



CERTIFIED LAND CORNER RESTORATION

Index No. W, X-5

State of Wisconsin }  
 County of Lincoln } ss.

John H. Fisher

I, John H. Fisher, do hereby certify on the 12th day of October, 1982, I found evidence of the meander corner corner of Sections 31 & 32 Township 35, North, Range 6 East, Fourth, Principal Meridian, as described hereon; and that from this evidence I established a new monument and accessories as described hereon to perpetuate the original location of this corner.

Resident witnesses:  
None

History of original corner establishment:


Not set by original survey

Description of corner evidence found:

2" iron pipe

Description of monument and accessories I established to perpetuate the original location of this corner.  
 From the 2" iron pipe found, I established new iron pipe witnesses

<u>1" iron pipe</u>	<u>S1°25'43"E</u>	<u>20.00 feet</u>
<u>1" iron pipe</u>	<u>S1°25'43"E</u>	<u>25.00 feet</u>
<u>1" iron pipe</u>	<u>S42°14'13"E</u>	<u>20.00 feet</u>
<u>2" iron pipe</u>	<u>N63°00'47"E</u>	<u>100.00 feet</u>

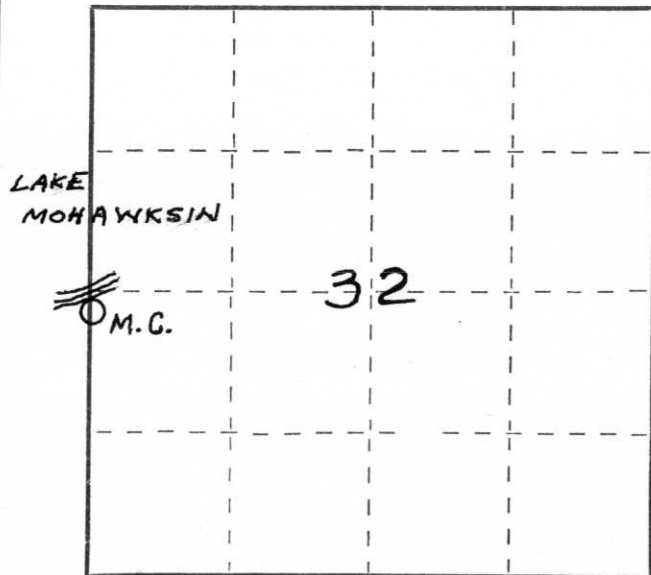

○ = Corner monument restored.

Dated at Minocqua, Wis., this 29th. day of March, 1983

Signature John H. Fisher Title Registered Land Surveyor Registration No. S-836  
 (County Surveyor, Registered Land Surveyor, or other duly authorized official)

Office of Register of Deeds, County of Lincoln, I hereby certify that the within instrument was filed in this office for record on the \_\_\_\_\_ day of \_\_\_\_\_, 19\_\_\_\_ at \_\_\_\_\_ o'clock \_\_\_\_\_ M.

(Register of Deeds)

By \_\_\_\_\_ Deputy