

# STATE OF WISCONSIN DEPARTMENT OF TRANSPORTATION

## PLAN OF PROPOSED IMPROVEMENT

# DEVIL CREEK BRIDGE AND APPROACHES TOWN OF SCOTT JOE SNOW ROAD LINCOLN COUNTY


STATE PROJECT	FEDERAL PROJECT	
	PROJECT	CONTRACT
9861-01-70	STP 35 99 (34)	1

### Index of Sheets

Sheet No.	Title
1	Typical Sections and Details
2.0	Estimate of Quantities
3 - 3.1	Miscellaneous Quantities
3A	Right of Way Plat
5.0	Plan and Profile (INCLUDES EROSION CONTROL PLAN)
6-6.5	Standard Detail Drawings
8 - 8.9	Sign Plates
9.0	Structure Plans
	Computer Earthwork Data
	Cross Sections


TOTAL SHEETS = 23

AS-BUILT PLAN

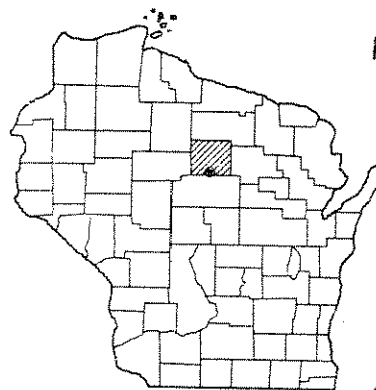

Project Engineer: Allen M. Wesolowski  
 Begin Construction: August 21, 1996  
 Completed: October 11, 1996  
 Diary Nos: 96-22

STATE PROJECT NUMBER  
9861-01-70

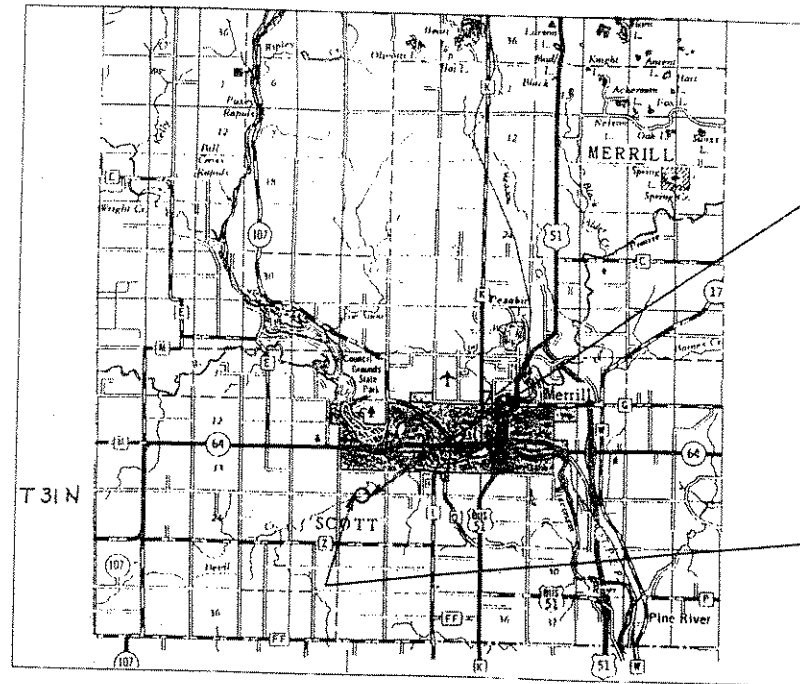

END PROJECT 9861-01-70  
 STA. 31+00  
 N 485000.00  
 E 2066287.37

BEGIN PROJECT 9861-01-70  
 STA. 28+75  
 N 485000.00  
 E 2066062.37

### Design Designation

A.D.T. 1994	= 80
A.D.T. 2014	= 112
D.H.V.	= N/A
D.	= 0.5
T. % ADT	= 5
V. DESIGN	= 40 MPH

Contractors: Rozic Construction Co.  
 Sub-Contractors:  
 Bill L. Schwede Sr., Inc.  
 Hi-Beam Erecting, Inc.  
 Traffic Signing & Marking, Inc.  
 American Asphalt of Wisconsin  
 Rent-A-Flash of Wisconsin  
 Timberline Contractors

### Conventional Signs

COUNTY LINE		COMBUSTIBLE FLUIDS	
CORPORATE LIMITS		UNDERGROUND UTILITIES	
PROPERTY LINE		GAS	
LOT LINE		ELECTRIC	
LIMITED HIGHWAY EASEMENT		TELEPHONE	
EXISTING RIGHT OF WAY		SERVICE PEDESTAL	
NEW RIGHT OF WAY		CABLE MARKER	
SURVEY LINE		POWER POLE	
SLOPE INTERCEPT		TELEPHONE POLE	
ORIGINAL GROUND		RAILROAD	
MARSH OR ROCK PROFILE		MARSH AREA	
CULVERT IN PLACE		WOODED AREA	
PROPOSED CULVERT			
CULVERT			

### Layout

SCALE 0 1 2 MILES

TOTAL NET LENGTH OF CENTERLINE = 0.0426 MI.

ALL COORDINATES ON THIS PLAN ARE REFERENCED TO THE WISCONSIN COORDINATE SYSTEM, CENTRAL ZONE. COORDINATES WERE SCALED FROM U.S.G.S. TOPOGRAPHIC MAP MERRILL, WISCONSIN QUADRANGLE FOR IDENTIFICATION ONLY.

ACCEPTED FOR LINCOLN COUNTY	
BY <i>Peter Kachel</i> PETER KACHEL, HWY COMMISSIONER	
ACCEPTED FOR TOWN OF SCOTT	
BY <i>Emil Pederson</i> EMIL PEDERSON, TOWN SUPERVISOR	
ORIGINAL PLANS PREPARED BY <b>BECHER-HOPPE ASSOC., Inc.</b> WAUSAU, WISCONSIN	
DATE: 12/14/95 <i>Randal W. VanNatta</i> (Signature)	
STATE OF WISCONSIN DEPARTMENT OF TRANSPORTATION	
PREPARED BY	
Surveyor	BECHER-HOPPE ASSOC.
Designer	BECHER-HOPPE ASSOC.
District Examiner	D. KUHN
District Supervisor	A. PETERSON
Proj. Dev. Engineer	
C.O. Examiner	D. MARG
APPROVED FOR DISTRICT OFFICE	
DATE: 1-8-96	<i>Henry E. Hagg</i> (Signature)
AUTHORIZED FOR CENTRAL OFFICE DESIGN	
DATE:	(Signature)

LINCOLN

9861-1-70

C:\ACAD\JOBS\94229\LIN\94229TL1.DWG 08-15-95/11:13:95