


ALTA AS BUILT LOCATION SURVEY

LOT -A- CERTIFIED SURVEY No. 988

Located in the
SW 1/4 of the NW 1/4
SECTION 27, T35N, R6E,
CITY OF TOMAHAWK,
LINCOLN COUNTY, WISCONSIN

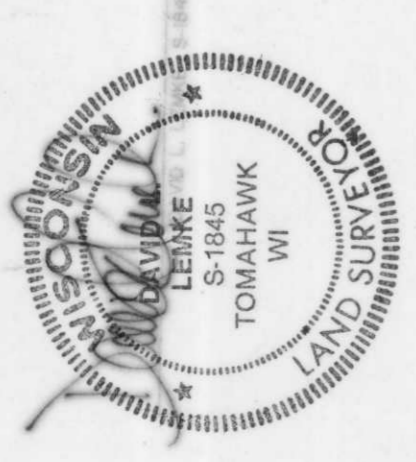

JAN 15 1998

RECEIVED AT LINCOLN COUNTY
COURTHOUSE THIS 22nd DAY
OF Jan 19 98
TAX DESCRIPTION OFFICE

WE HEREBY CERTIFY THAT THE INFORMATION CONTAINED HEREIN IS CORRECT AND TRUE TO THE BEST OF OUR KNOWLEDGE AND BELIEF, AND THAT WE HAVE CONDUCTED A THOROUGH AND CAREFUL SURVEY OF THE PROPERTY DESCRIBED HEREIN, AND THAT THE INFORMATION CONTAINED HEREIN IS THE RESULT OF OUR OWN SURVEYING AND MEASUREMENTS, AND NOT FROM ANY OTHER SOURCE. WE FURTHER CERTIFY THAT THE SURVEY WAS CONDUCTED IN ACCORDANCE WITH THE STANDARDS AND PRACTICES OF THE PROFESSION OF LAND SURVEYING IN THE STATE OF WISCONSIN, AND THAT WE ARE A LICENSED LAND SURVEYOR IN THE STATE OF WISCONSIN.



UTILITY SERVICES PROVIDED BY:
WISCONSIN TV CABLE 715-269-3234
CITY OF TOMAHAWK - WATER-715-453-5404
WISCONSIN PUBLIC SERVICE 800-455-4545
DISCOUNT FERTILIZER 800-242-8338

PREPARED FOR:
SPT PROPERTIES
1513 N. 4th. Street
Tomahawk, WI 54661
8877 LLC

BOUNDARY MARKERS
AS PER THE SURVEY
SCALE: 1" = 40'
FOOTED 1/4" FROM H&E

L239A