

SURVEYOR'S NOTES

1. AT THE TIME OF THE SURVEY, SNOW AND/OR ICE EXISTED OVER THE SUBJECT PROPERTY. POINT OF BEGINNING SHALL NOT BE HELD RESPONSIBLE FOR ANY POSSIBLE ERRORS OR OMISSIONS DUE TO SAID WINTER CONDITIONS.

BENCH MARK

ELEVATIONS ARE REFERENCED TO NAVD 88 DATUM.

BENCHMARK #1
604 SPIKE IN EAST SIDE OF LIGHT POLE LOCATED ON THE EAST SIDE OF THE TOMAHAWK SCHOOL BUILDING, APPROXIMATELY 88 FEET SOUTHWEST OF THE SOUTHWEST CORNER OF THE TRACK.
ELEVATION = 1448.70

BENCHMARK #2
NORTHWEST FLANGE BOLT ON FIRE HYDRANT LOCATED NORTH OF THE TOMAHAWK SCHOOL BUILDING, APPROXIMATELY 55 FEET NORTH OF THE NORTHEAST CORNER OF THE SCHOOL BUILDING.
ELEVATION = 1451.02

CLIENT/OWNER

TOMAHAWK SCHOOL DISTRICT
1048 EAST KING ROAD
TOMAHAWK, WI 54487

GENERAL DESCRIPTION

BEG PART OF THE NORTHWEST 1/4 OF SECTION 35, TOWNSHIP 35 NORTH, RANGE 6 EAST, CITY OF TOMAHAWK, LINCOLN COUNTY, WISCONSIN.

SUBJECT TO (IF ANY) COVENANTS, CONDITIONS, RESTRICTIONS, RIGHT-OF-WAYS AND EASEMENTS OF RECORD.

SURVEYOR'S CERTIFICATE

I, JORDAN G. BROST, PROFESSIONAL LAND SURVEYOR DO HEREBY CERTIFY THAT THIS IS A TRUE AND CORRECT COPY OF A TOPOGRAPHICAL SURVEY AS DONE UNDER MY DIRECTION ON JANUARY 21, 2020.

DATED THIS 4th DAY OF FEBRUARY, 2020


JORDAN G. BROST
PROFESSIONAL LAND SURVEYOR NO. 3009



SURVEY LEGEND

These standard symbols will be found in the drawing.

- STORM SEWER LINE
- BURIED ELECTRIC LINE
- BURIED GAS LINE
- APPROXIMATE BURIED WATER LINE PER MAPS FROM OTHERS
- CHAIN LINE FENCE LINE (UNLESS NOTED OTHERWISE)
- EDGE OF BITUMINOUS
- CONTOUR LINE
- CIRCULAR CATCH BASIN
- WATER SPIGOT
- WATER VALVE
- HYDRANT
- IRRIGATION SPIGOT
- ELECTRIC METER
- ELECTRIC TRANSFORMER
- ELECTRIC OUTLET
- ELECTRIC BOX
- LIGHT POLE
- TELEPHONE PEDESTAL
- STADIUM LIGHT
- POST
- GUARD POST/BOLLARD
- TRANSIT BOX
- DUST COLLECTOR
- SIGN
- FLAGPOLE
- DISC GOLF BASKET
- PLAY EQUIPMENT
- TREE
- PINE TREE
- METAL PLATE

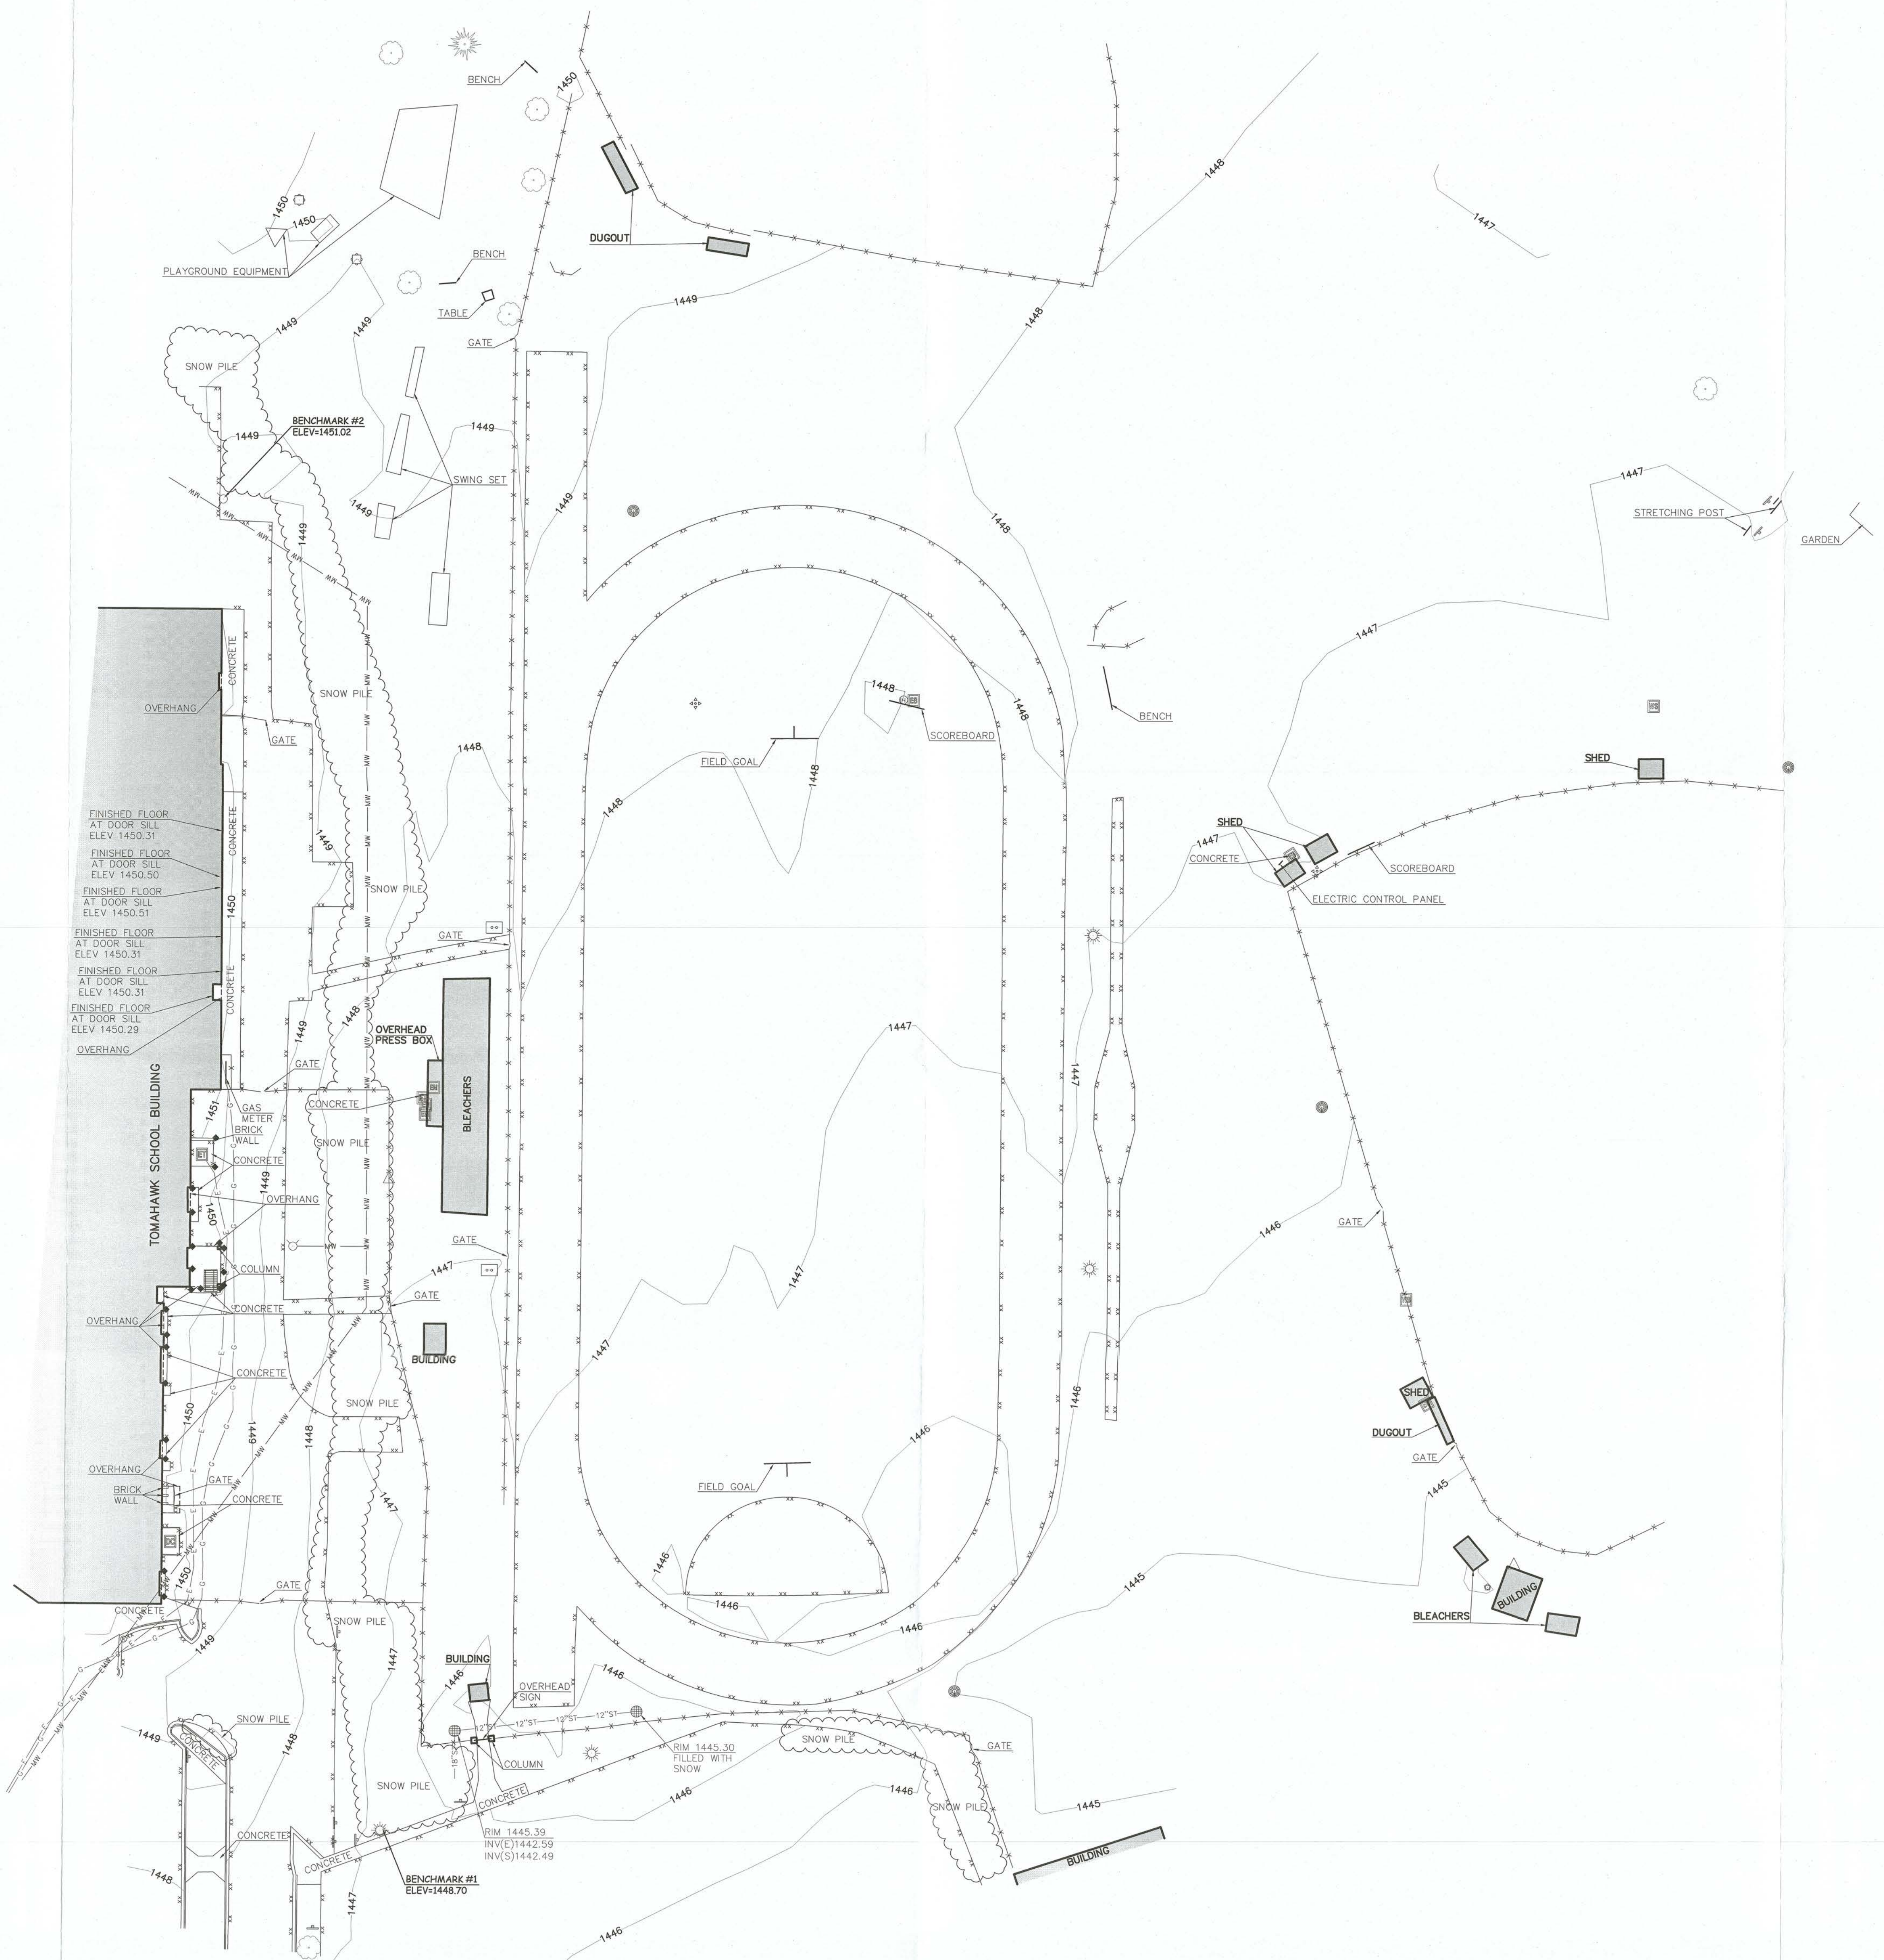

RECEIVED BY LINCOLN COUNTY SURVEYOR THIS 20th DAY OF February 20 20
Jordan G. Brost
 COUNTY SURVEYOR

0' 40' 80' 120'
 Scale 1"=40'

UTILITY DISCLAIMER

THE LOCATION, DEPTH, SIZE AND TYPE OF UNDERGROUND PUBLIC AND PRIVATE UTILITIES OR STRUCTURES SHOWN HEREON WERE OBTAINED FROM PUBLIC RECORDS, FIELD RECONSTRUCTION AND/OR AS-BUILT PLANS. THE LOCATIONS SHOWN HEREON ARE ONLY APPROXIMATE, AND ADDITIONAL UTILITY LINES NOT DISCOVERED, OR MARKED, DURING THE SURVEY. CONTRACTORS AND FIELD SURVEYORS MAY EXIST. ANY CONTRACTOR USING THE INFORMATION SHOWN HEREON IS HEREBY FOREWARNED THAT ANY EXCAVATION WORK MAY RESULT IN THE DISCOVERY OF ADDITIONAL UNDERGROUND UTILITIES NOT SHOWN HEREON. FOR MAJOR OR RECURRENT OF ANY KIND, EXPRESS OR IMPLIED, WITH RESPECT TO THE EXISTING UTILITIES SHOWN PRIOR TO CONSTRUCTION, IT IS THE CONTRACTOR'S RESPONSIBILITY TO FIELD VERIFY LOCATIONS, DEPTHS, SIZES AND TYPES OF UNDERGROUND PUBLIC AND PRIVATE UTILITIES OR STRUCTURES WITHIN THE CONSTRUCTION LIMITS AND SHALL BE RESPONSIBLE FOR NOTIFYING THE ENGINEER OF RECORD. ALL UTILITIES THAT DO NOT ALIGN WITH THE EXISTING CONDITIONS AS SHOWN HEREON. CONTRACTORS MUST OBTAIN PERMITS FOR PUBLIC UTILITIES AS ORDERED FOR THIS SURVEY.

*A PRIVATE UTILITY LOCATE WAS NOT A PART OF THE SCOPE OF WORK CONTRACTED FOR THIS PROJECT AND WAS THEREFORE NOT ORDERED.

POINT OF BEGINNING, INC. HOLDS THE RIGHTS TO COPYRIGHT IN AND TO THESE PRINTS, DRAWINGS AND DOCUMENTS. NO REPRODUCTION, COPYING, ALTERATION, MODIFICATION, USAGE, INCORPORATION INTO OTHER DOCUMENTS OR ASSIGNMENT OF THE NAME MAY OCCUR WITHOUT THE PRIOR WRITTEN PERMISSION OF POINT OF BEGINNING, INC.

© 2020 POINT OF BEGINNING, INC.

REVISIONS	
CHECKED:	JORDAN G. BROST
DRAWN:	CHAD A. GORETSKI
DATE:	1-27-20
PROJECT NO.:	20-403

TOPOGRAPHIC SURVEY

**TOMAHAWK SCHOOL DISTRICT
 TOMAHAWK HIGH SCHOOL
 CITY OF TOMAHAWK
 LINCOLN COUNTY, WISCONSIN**

Civil Engineering
 Land Surveying
 Landscape Architecture
 4921 Kirschling Court
 Stevens Point, WI 54481
 715.344.9992(FH) 715.344.9922(FX)

POB
 Point of Beginning
TOPO

L536A