


LINCOLN COUNTY

SECTION SUMMARY

11 - 31 - 4 E
 Section Town Range
 11 31 4
 CORNING
 Township

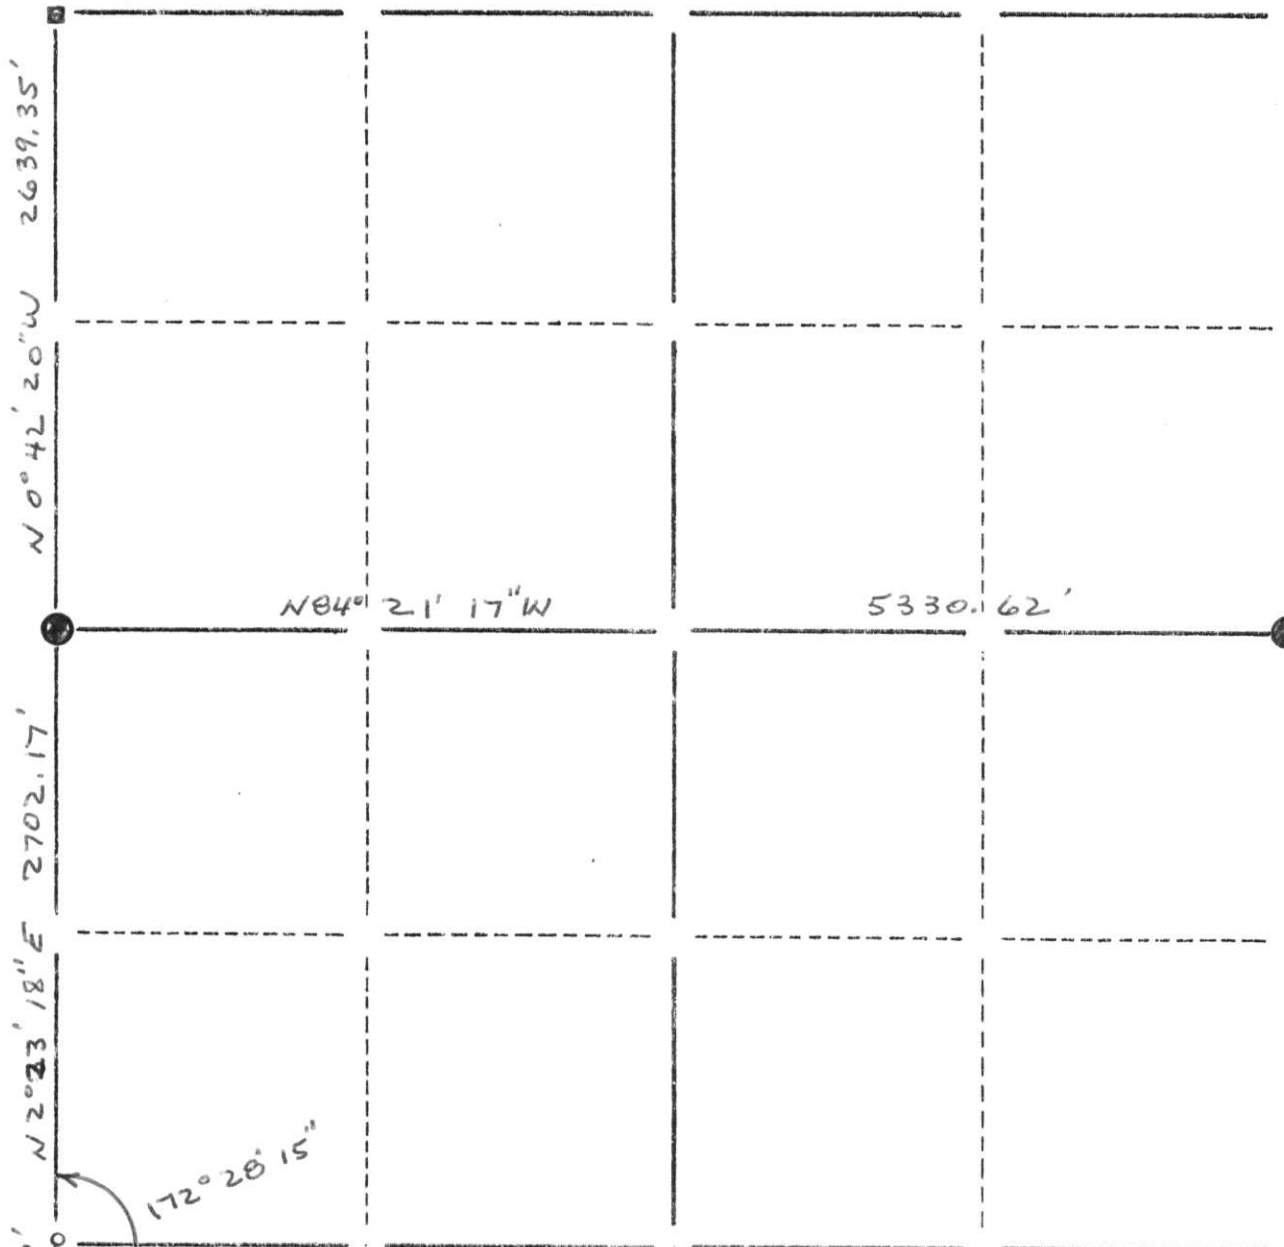

LEGEND

- - Harrison Cast Iron Monument
- - Stone or Concrete Monument
- - 2" Iron Pipe
- - 1 1/4" Iron Pipe
- - Iron Bar

- △ - RR Spike
- - PK Nail
- - Other - Berntsen Monument
- ◇ - _____
- ▲ - _____

NOTE

This section summary tied into Section 15 section summary done by me in 1996 by an angle and distance from SW Corner of Section 11 to E 1/4 Corner of Section 15.



RECEIVED AT LINCOLN COUNTY COURTHOUSE THIS 24th DAY OF July 19 97
Pat Priebe
 TAX DESCRIPTION OFFICE

Robert K. Fergot
 Robert K. Fergot
 July 22, 1997

E: I - 17:21