
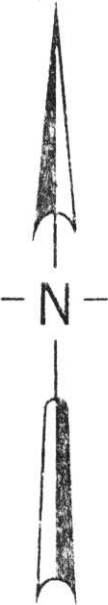


LINCOLN COUNTY

SECTION SUMMARY

15 - 31 - 1
Section Town Range

CORNING
Township

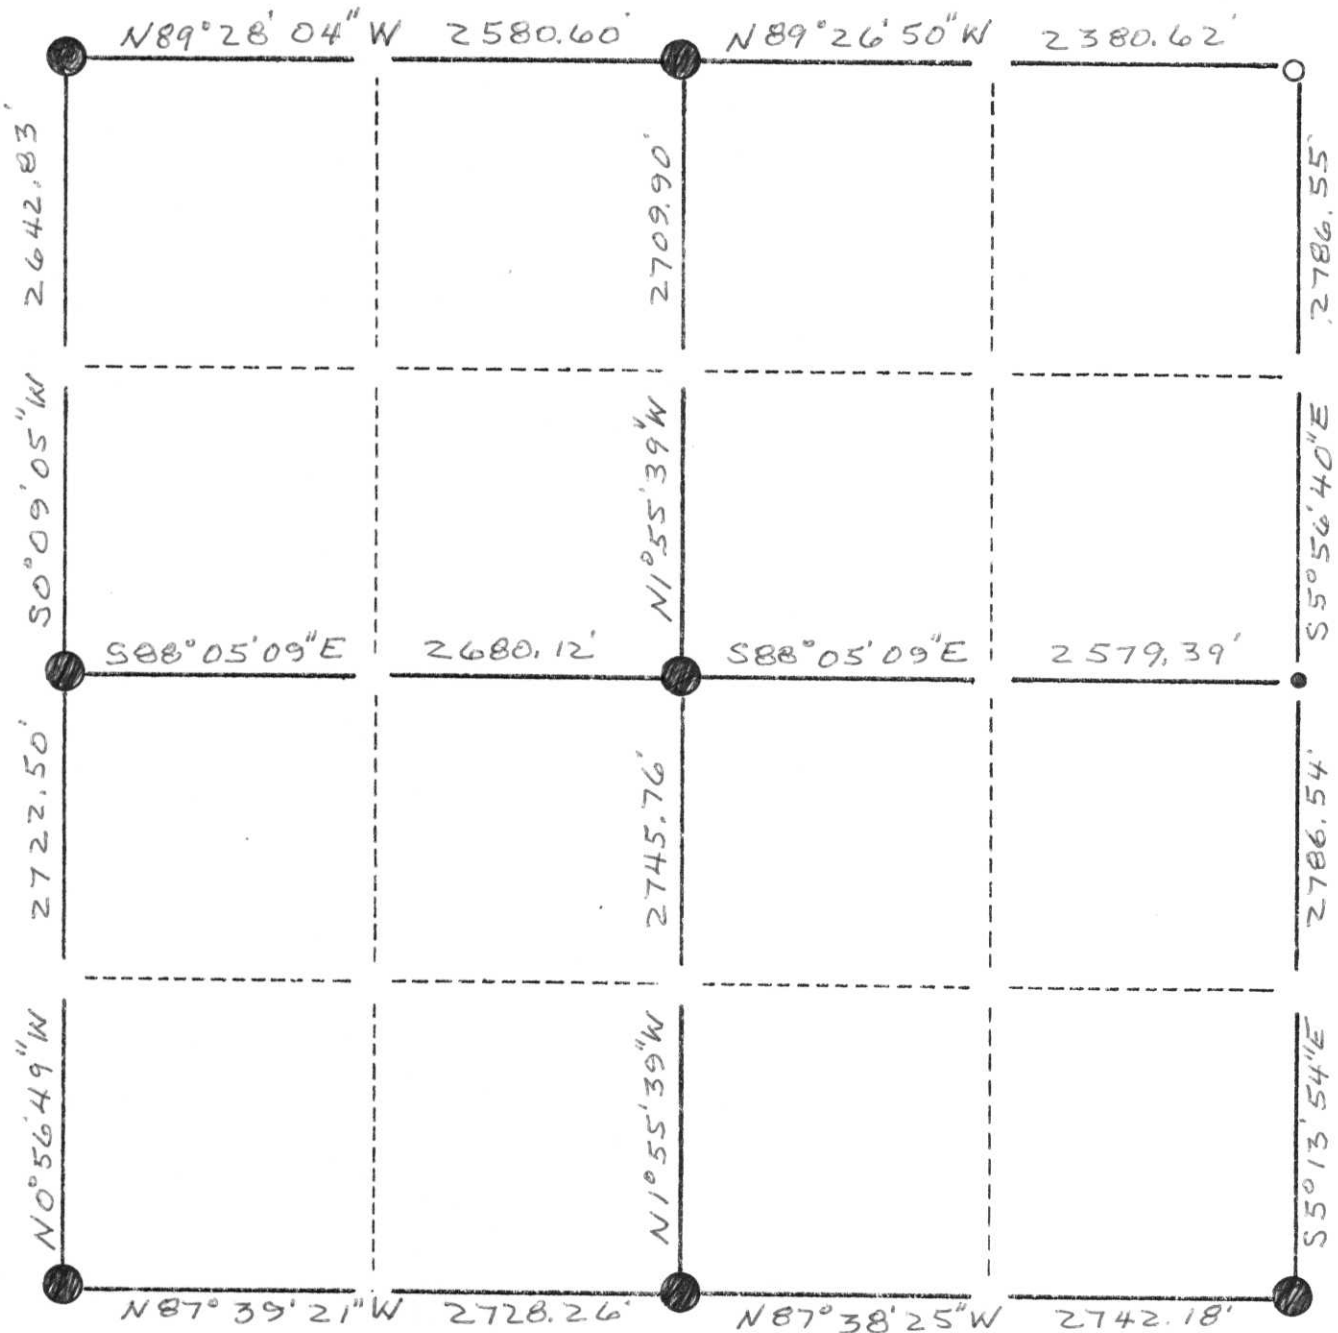

LEGEND

- ⊕ - Harrison Cast Iron Monument
- - Stone or Concrete Monument
- - 2" Iron Pipe
- - 1 1/4" Iron Pipe
- - Iron Bar 1"
- △ - RR Spike
- - PK Nail
- - Other - Berntsen Monument
- ◇ - _____
- ▲ - _____



The locations that were monumented as the corners of this section were determined by giving most weight to the existing fences and roads. No evidence of monuments were found by excavating of the roads. All original corner ties have been obliterated. Corners in adjacent sections were non-existent.

In my judgement, this section as monumented by me has been done in the most equitable manner.

Robert K. Fergot

April 5, 1996

I:W-13:17