
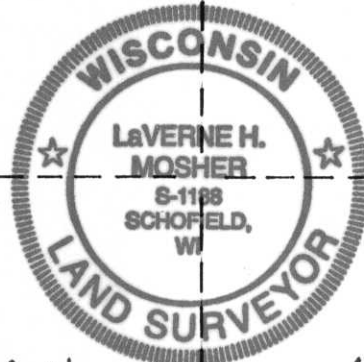


4E

CORNING
TOWNSHIP

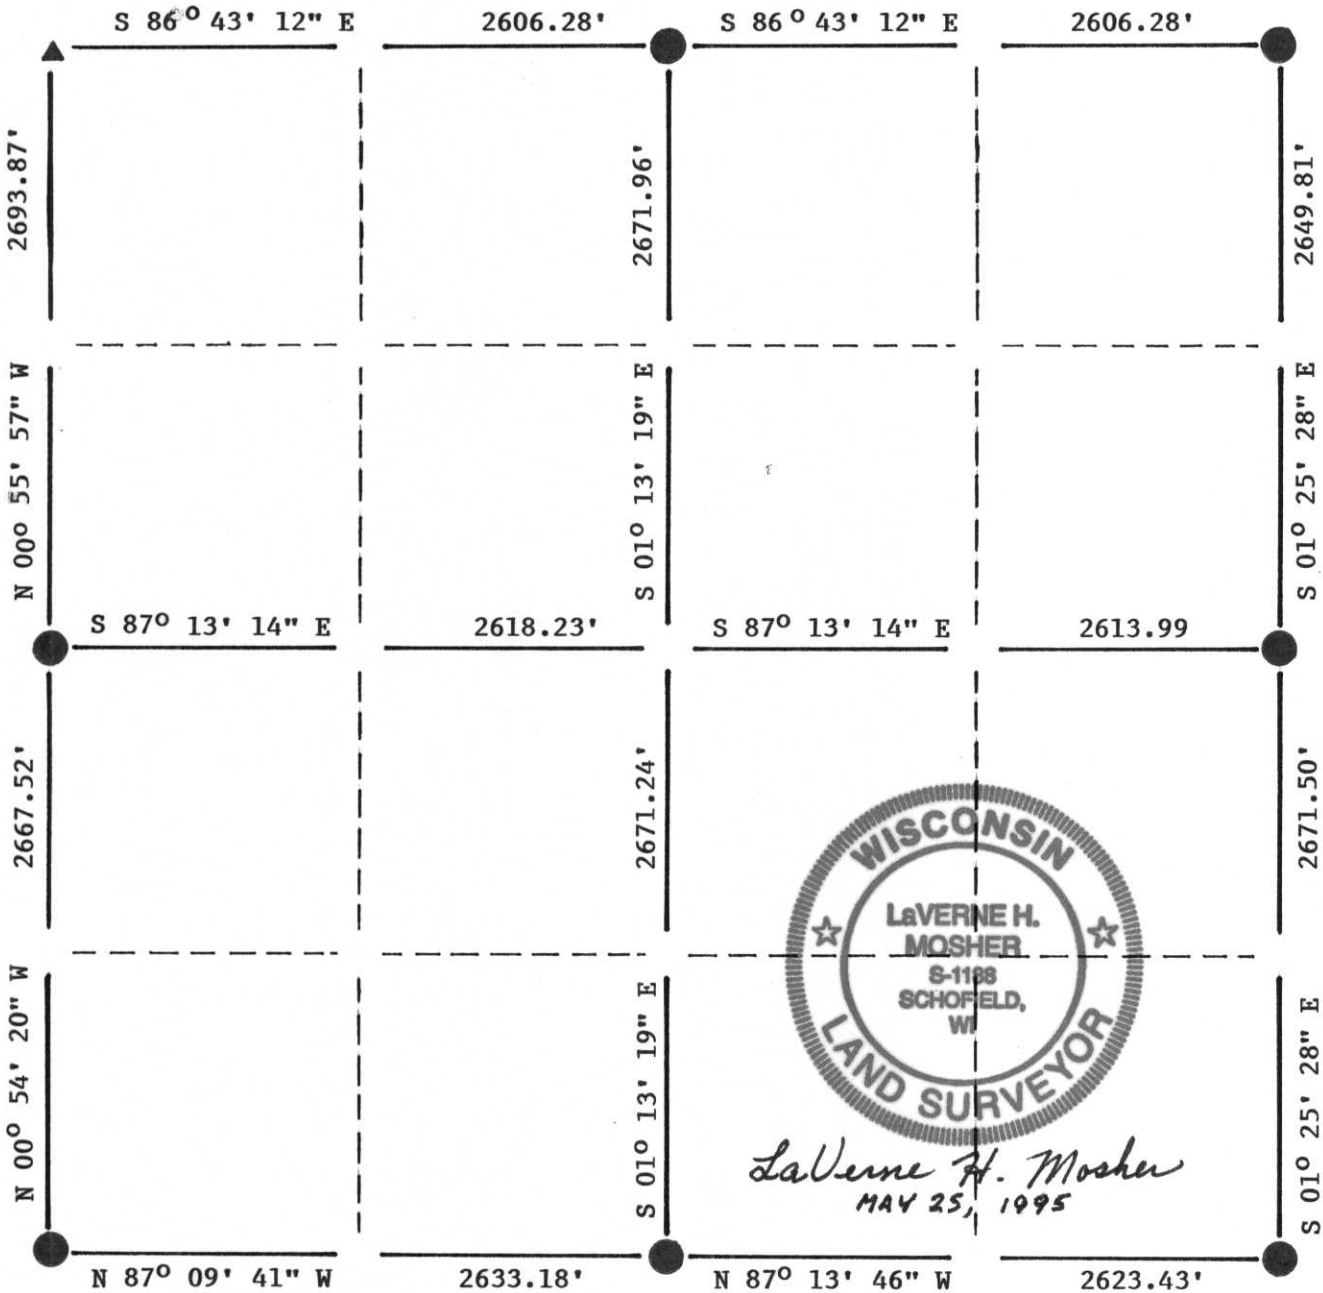

Laverne H. Mosher
MAY 25, 1995

LEGEND

- - HARRISON CAST IRON MONUMENT
- - STONE OR CONCRETE MONUMENT
- - 2" IRON PIPE
- - 1" IRON PIPE
- - IRON BAR
- △ - R.R. SPIKE
- - PK NAIL
- - BERNTSEN MONUMENT
- ▲ - OTHER - God SPIKE (FERGOT) PER

LHM SURVEYING

4203 SCHOFIELD AVE, SCHOFIELD, WI. 54476

RECEIVED AT LINCOLN COUNTY
COURTHOUSE THIS 25 DAY
OF May 1995
Pat Rieder
TAX DESCRIPTION OFFICE

M:Q-17:21