


LINCOLN COUNTY

SECTION SUMMARY

24 - 31 - 4
 Section Town Range
 CORNING
 Township

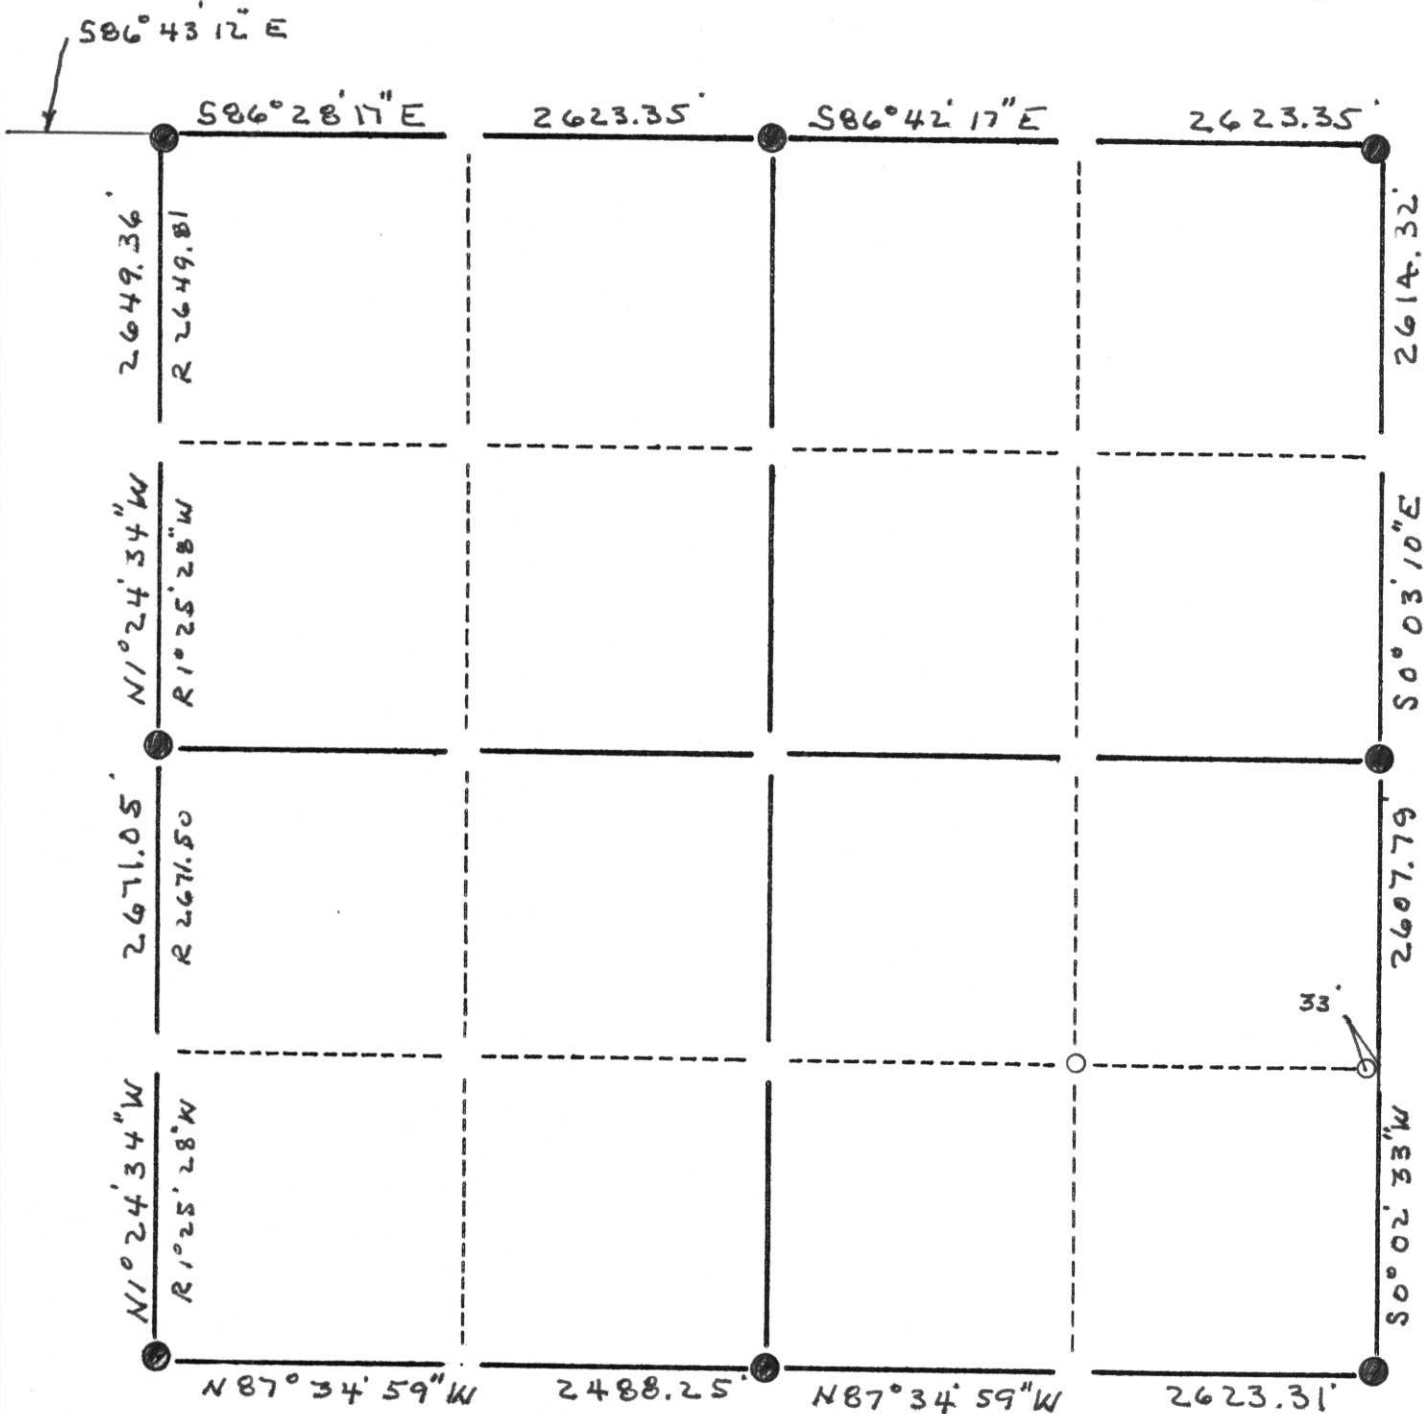

LEGEND

- ⊕ - Harrison Cast Iron Monument
- - Stone or Concrete Monument
- - 2" Iron Pipe
- - 1 1/4" Iron Pipe
- - Iron Bar
- △ - RR Spike
- - PK Nail
- - Other - Berntsen Monument
- ◇ - _____
- ▲ - _____



RECEIVED AT LINCOLN COUNTY
 COURTHOUSE THIS 1st DAY
 OF May 1998
Pat Priebe
 TAX DESCRIPTION OFFICE

Robert K. Fergot

April 28, 1998

M:Q - 21:25