




CORNING

Township

SECTION SUMMARY

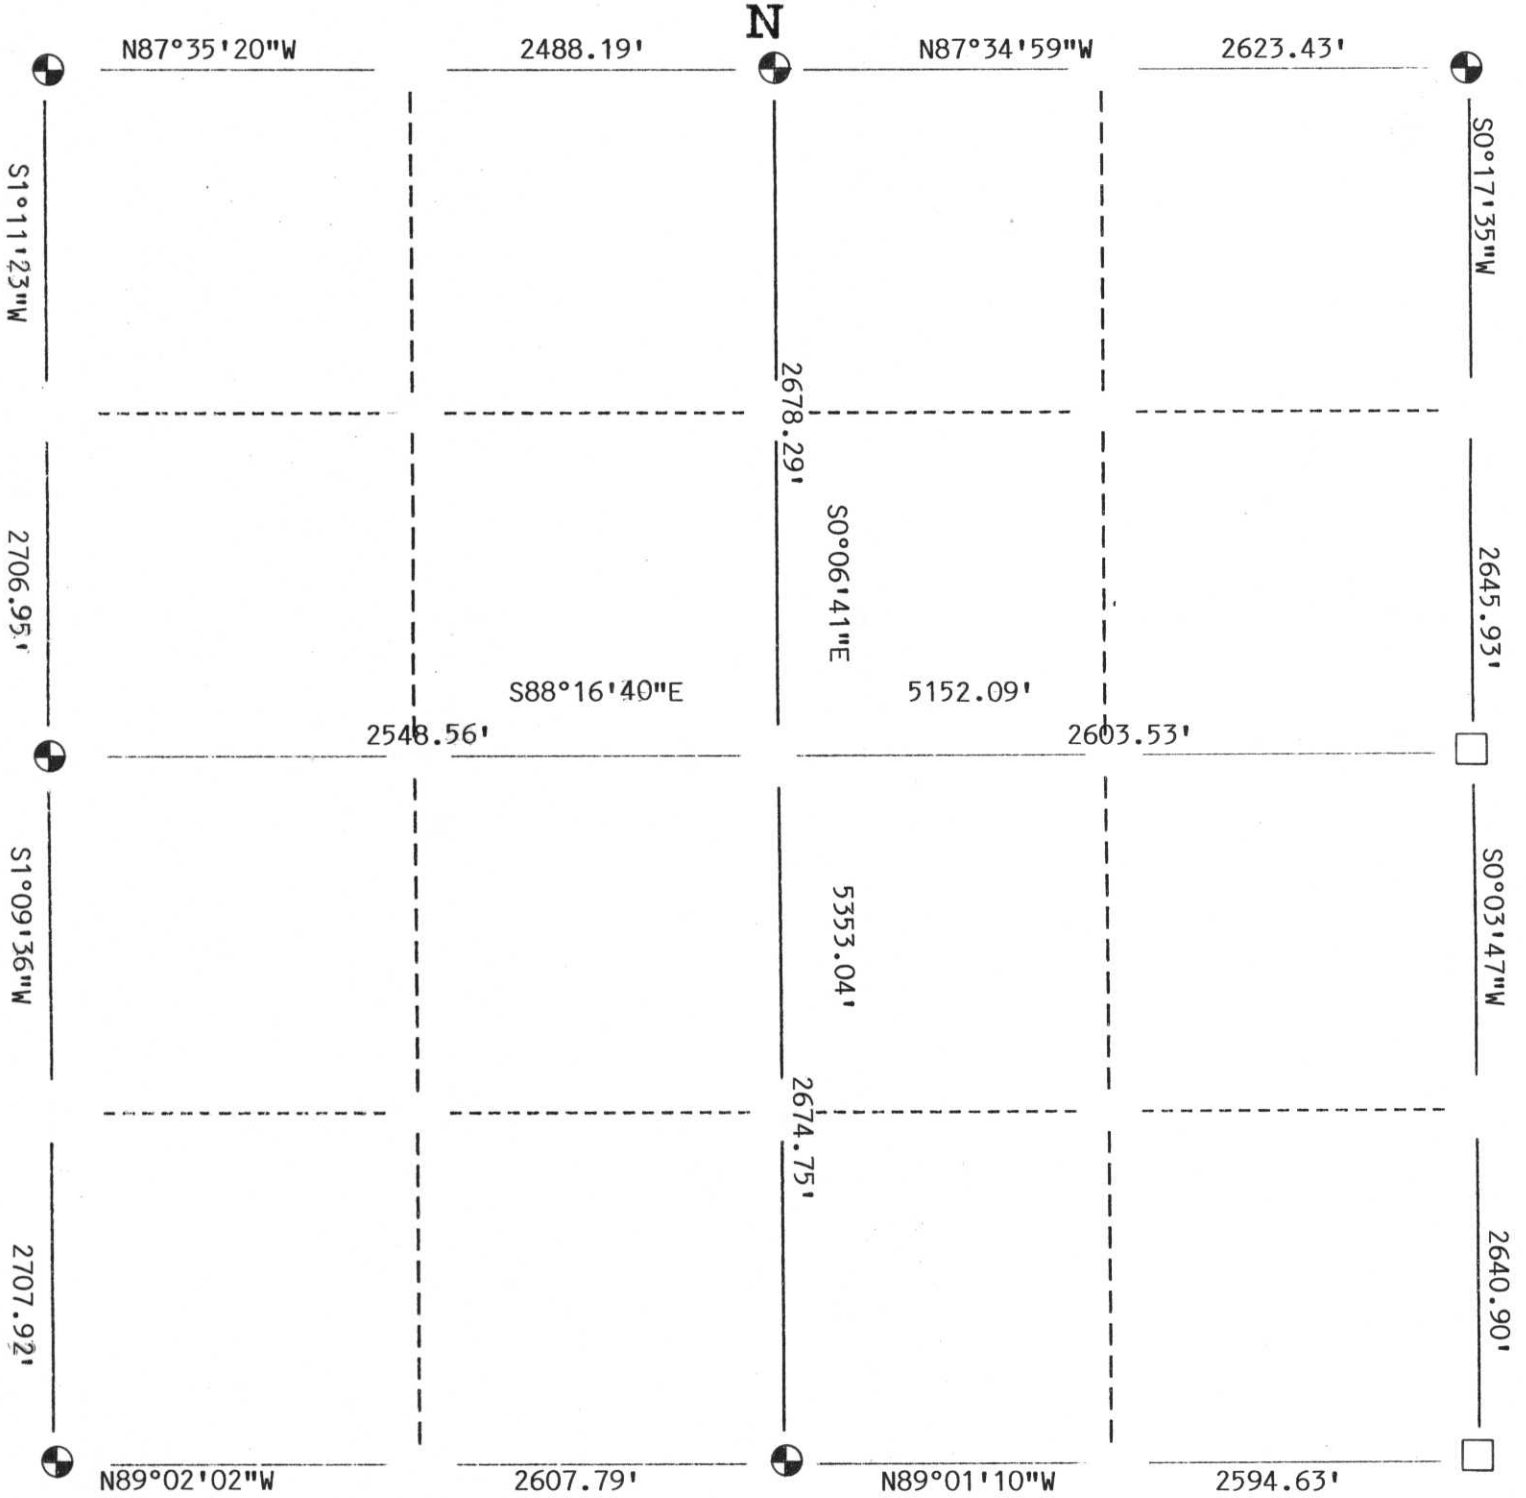

LEGEND

- Berntsen Monument
- 2" Iron Pipe
- Stone or Concrete Monument
- 1" Iron Pipe
- Iron Pipe
- Other



Bearings referenced to the north line NE $\frac{1}{4}$ of Section 25, assumed bearing of N87°34'59"W

CERTIFIED CORRECT:
David J. Goslin RLS No. 2280

David J. Goslin

Registered Land Surveyor

DATE: 3-21-00

RECEIVED AT LINCOLN COUNTY
COURTHOUSE THIS 28th DAY
OF March 2000
Jerry Dallman
LAND INFORMATION OFFICE

2:0 - 21:25