
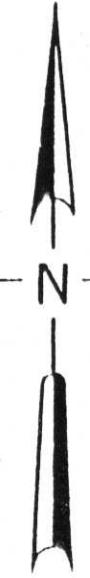


LINCOLN COUNTY

SECTION SUMMARY

30 - 31 - 4
Section - Town - Range

CORNING
Township

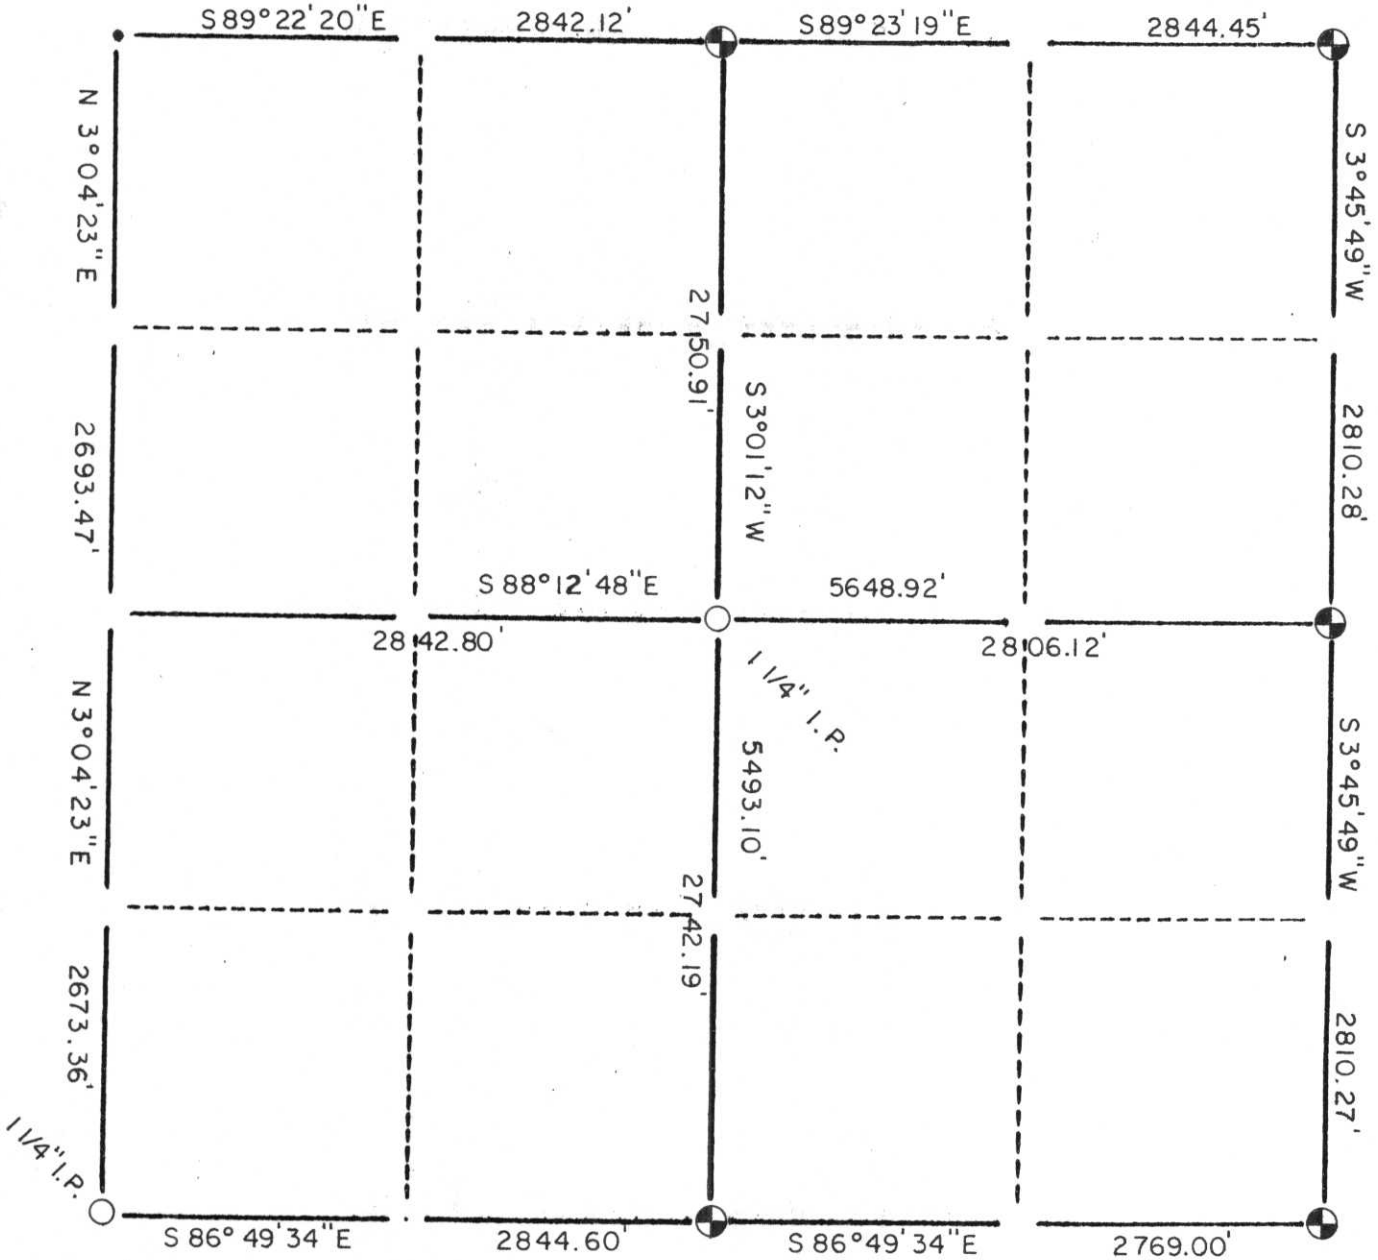

LEGEND

- LINCOLN COUNTY BERNTSEN MONUMENT
- Stone or Concrete Monument
- 2" Iron Pipe
- 1" Iron Pipe
- Iron Bar
- NAIL



CERTIFIED CORRECT
Edwin R. Abendroth
 Edwin R. Abendroth RLS No. S-798
 Registered Land Surveyor
 DATE: December 19, 1997

RECEIVED AT LINCOLN COUNTY
 COURTHOUSE THIS 22nd DAY
 OF Dec 19 97
Pat Pribe
 TAX DESCRIPTION OFFICE

Q:11-1:5