


**LINCOLN COUNTY U.S. PUBLIC LAND  
SECTION SUMMARY**

SECTION 26  
TOWNSHIP 31N  
RANGE 5 E

**CORNING**  
CITY, VILLAGE, TOWN

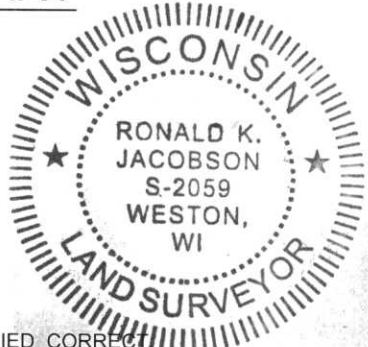

CERTIFIED CORRECT

*Ronald Jacobson*  
Ronald Jacobson RLS 2059-008

Registered Land Surveyor

DATE: August 4, 2006



NOT TO SCALE  
BEARINGS REFERENCED  
TO LINCOLN COUNTY  
CORDINATE SYSTEM

COORDINATES ARE REFERENCED  
TO LINCOLN COUNTY COORDINATE  
SYSTEM AS DEVELOPED BY THE WI.  
DEPARTMENT OF TRANSPORTATION  
AND ARE BASED ON GPS OBSERVATIONS  
TO CONTROL POINTS AS SUPPLIED BY  
LINCOLN COUNTY.



RECEIVED BY LINCOLN COUNTY

**LEGEND**

- ▲ FOUND MAG NAIL
- △ SET SURVEY NAIL
- CALCULATED PER TIE SHEET ON RECORD
- ⊗ FOUND 0.75" BAR
- FOUND STONE

SURVEYOR THIS 7<sup>TH</sup> DAY  
OF August 20 06  
*Ronald Jacobson*  
COUNTY SURVEYOR

DRAFTED BY: Seubert  
DATE: August 4, 2006

Central Wisconsin Engineers & Architects  
5707 Schofield Ave.  
Weston, Wisconsin 54476  
(715) 359-3400