


LINCOLN COUNTY



3 - 31 - 6
Section Town Range

MERRILL
Township

SECTION SUMMARY

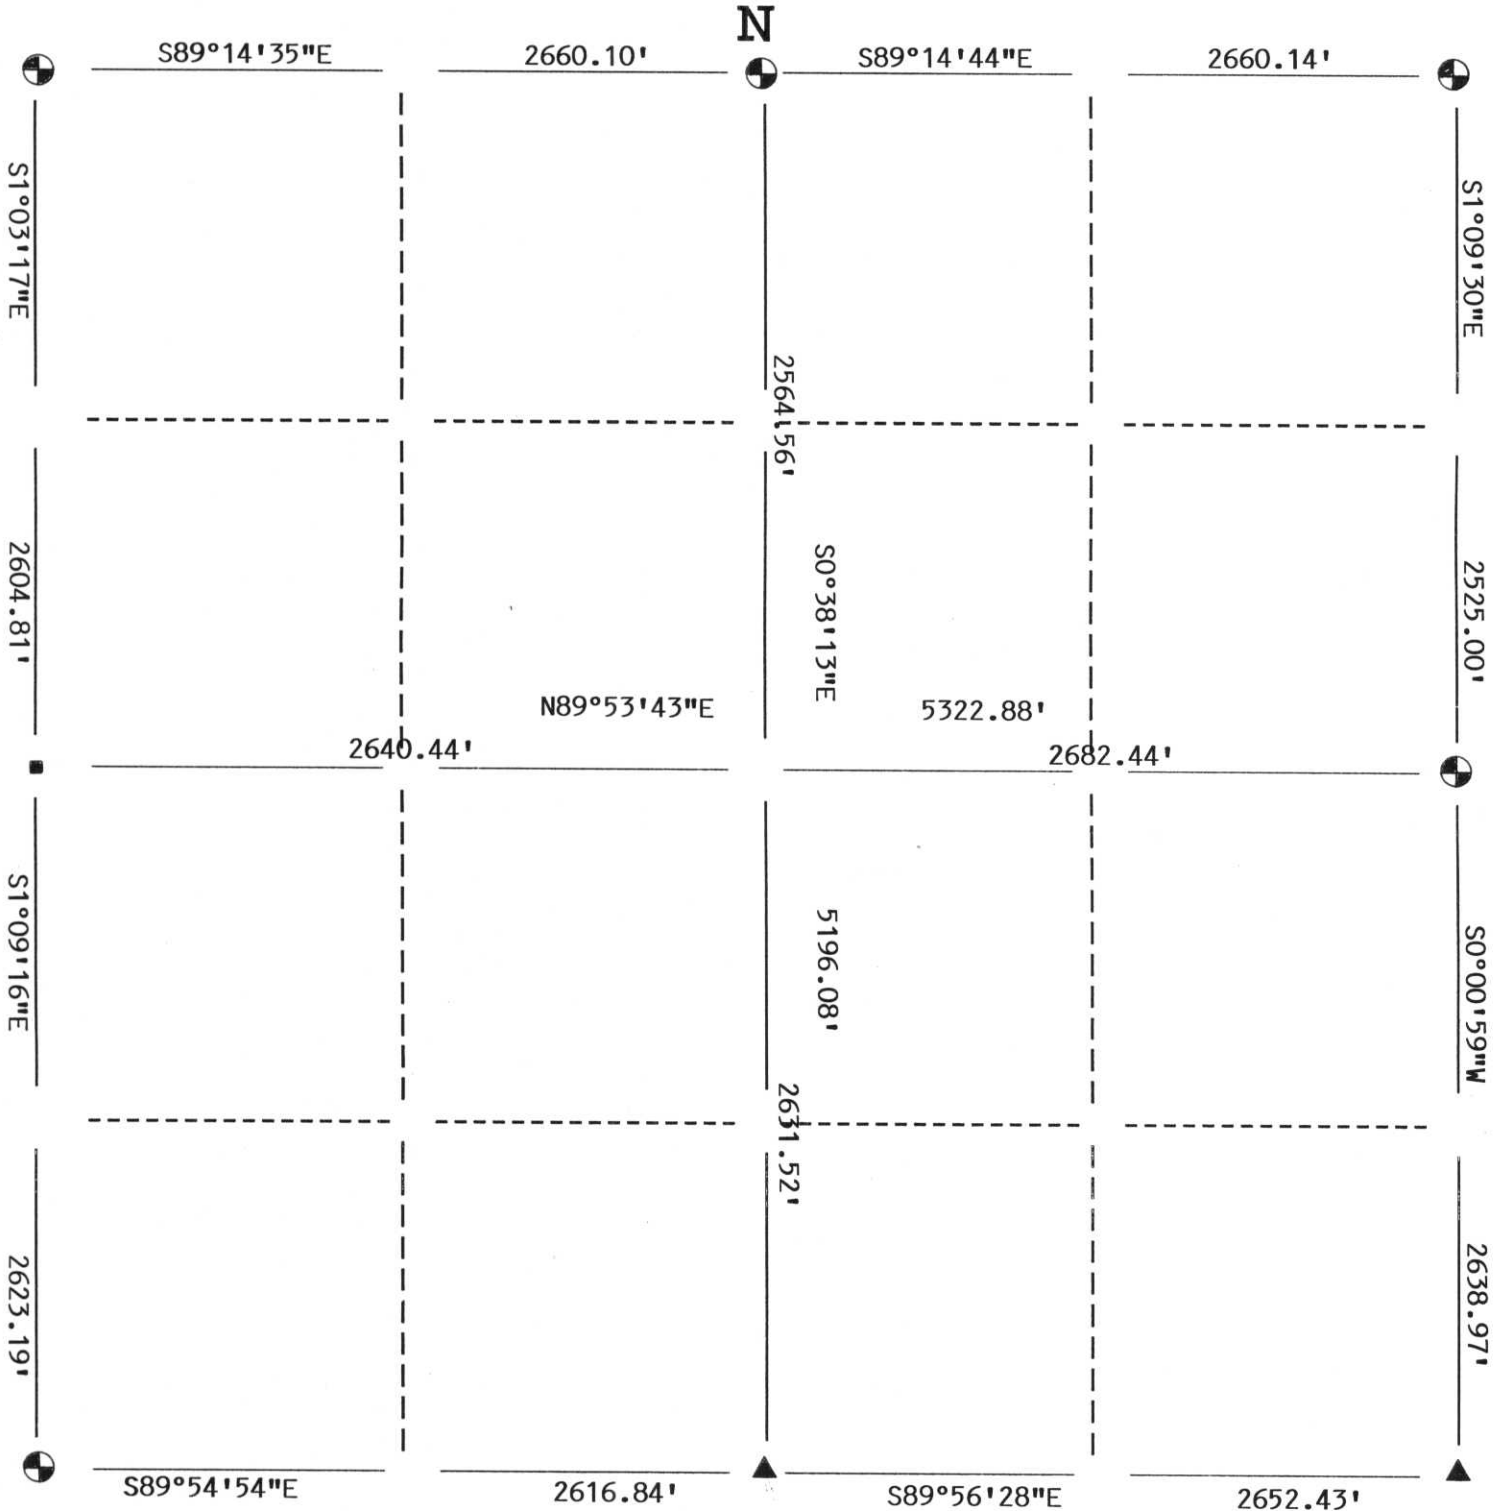

LEGEND


- Berntsen Monument
- 2" Iron Pipe
- Stone or Concrete Monument
- 1" Iron Pipe
- Iron Pipe
- Other Railroad Spike
- Berntsen Survey Mark Nail



RECEIVED AT LINCOLN COUNTY
COURTHOUSE THIS 10 DAY
OF May 20 01
Tony Dallman
LAND INFORMATION OFFICE

CERTIFIED CORRECT:
David J. Goslin
David J. Goslin RLS No. 2280
Registered Land Surveyor
DATE: 5-08-01



H/E - 10:11

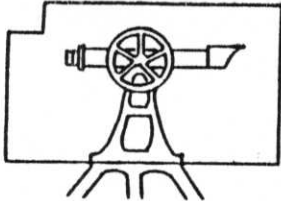

LINCOLN
county
surveyor

SECTION
SUMMARY

$\frac{3}{\text{Section}} - \frac{31}{\text{Town}} - \frac{6}{\text{Range}}$
Merrill
Township

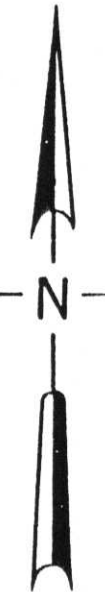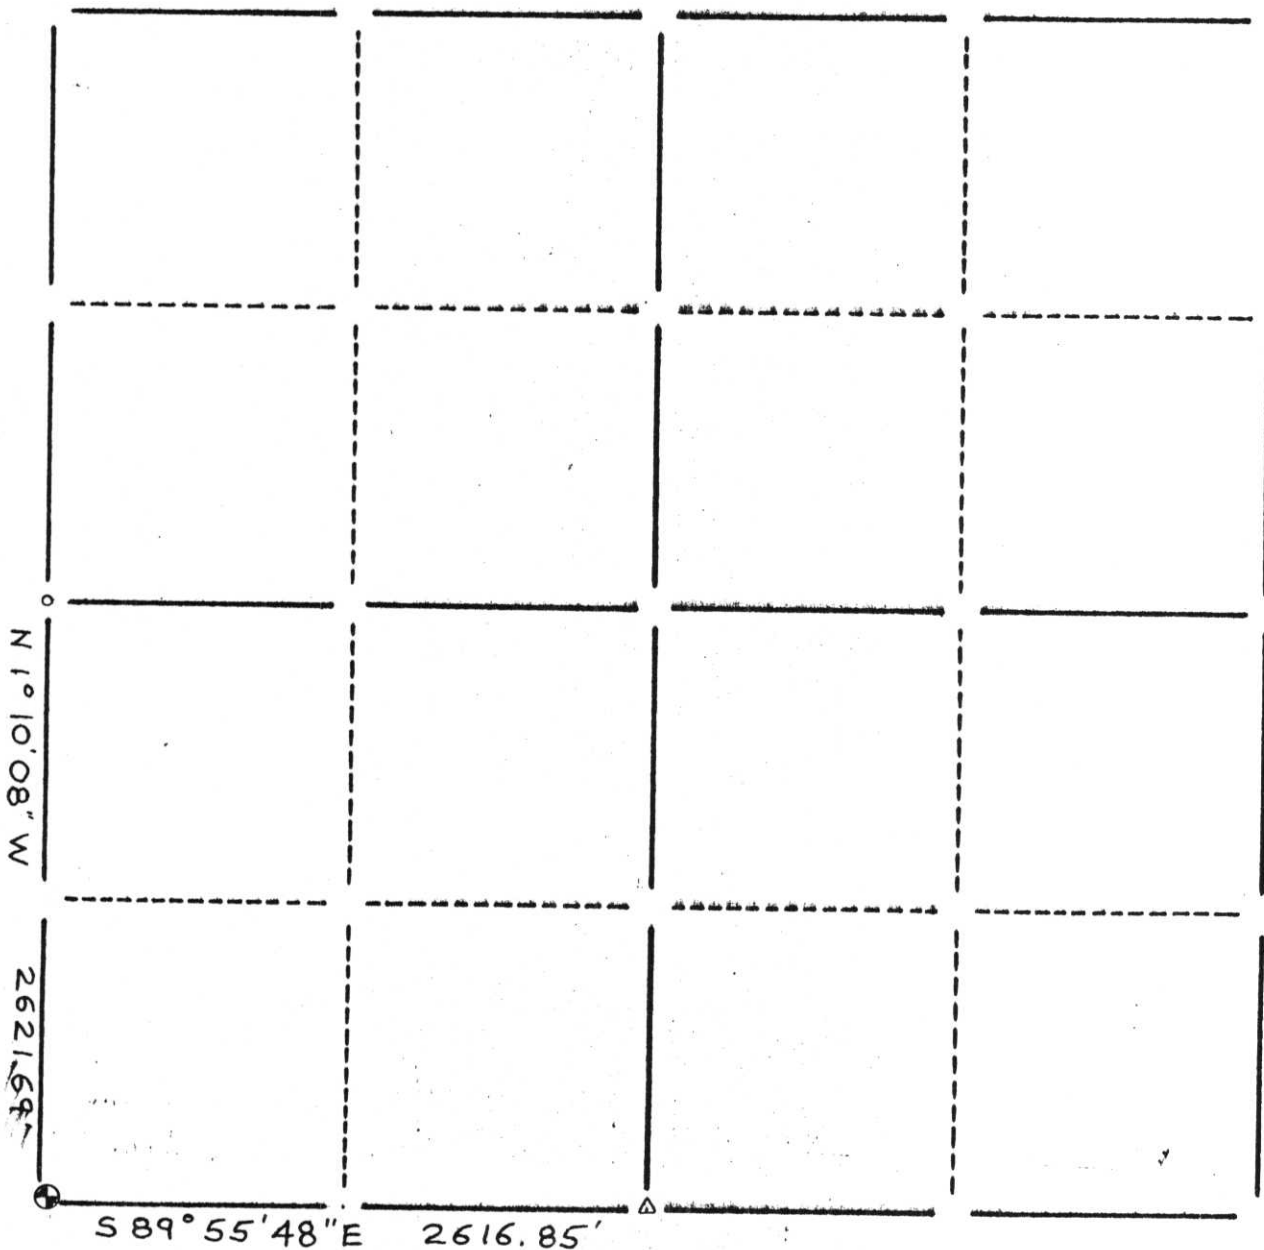

LEGEND

- ⊕ - Harrison Cast Iron Monument
- - Stone or Concrete Monument
- - 2" Iron Pipe
- - 1" Iron Pipe
- - Iron Bar
- △ - Other Railroad spike
- - PK nail

SEAL

RECEIVED AT LINCOLN COUNTY
COURTHOUSE THIS _____ DAY
OF _____ 19____

TAX DESCRIPTION OFFICE

CERTIFIED CORRECT:

Edmund R. Ahendrath

5-798
Registered Land Surveyor

DATE: 9-27-95

A:E-13:17