

# LINCOLN COUNTY

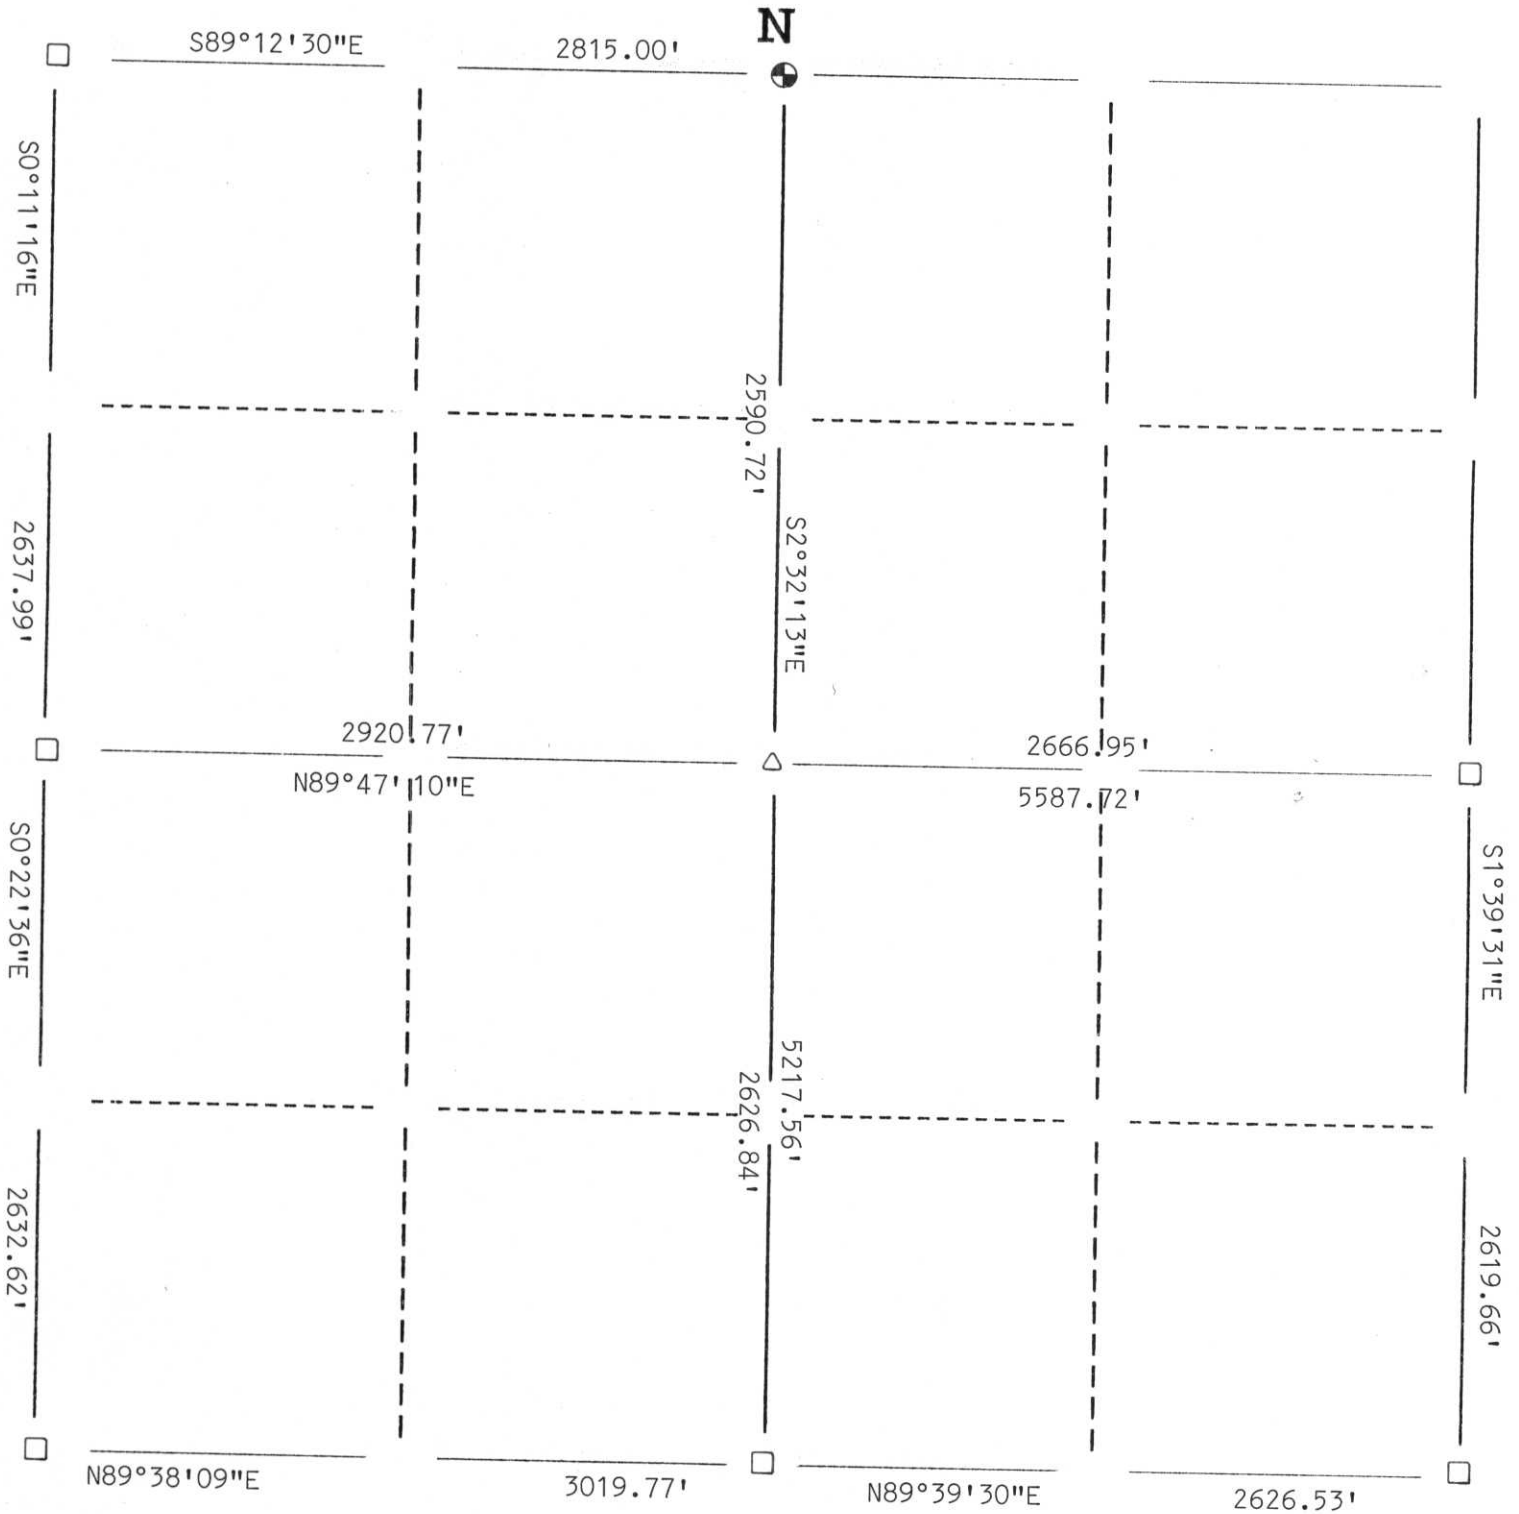


6 - 31 - 86  
Section Town Range






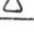
SCOTT

Township

## SECTION SUMMARY



### LEGEND

-  Berntsen Monument
-  2" Iron Pipe
-  Stone or Concrete Monument
-  1" Iron Pipe
-  Iron Pipe
-  Other Railroad spike



CERTIFIED CORRECT:

*David J. Goslin*  
David J. Goslin RLS S-2280

DATE: 5-7-99 Registered Land Surveyor

A.E.-1:5