

LINCOLN COUNTY




8 - 31 - 6
Section Town Range

SCOTT

Township

SECTION SUMMARY

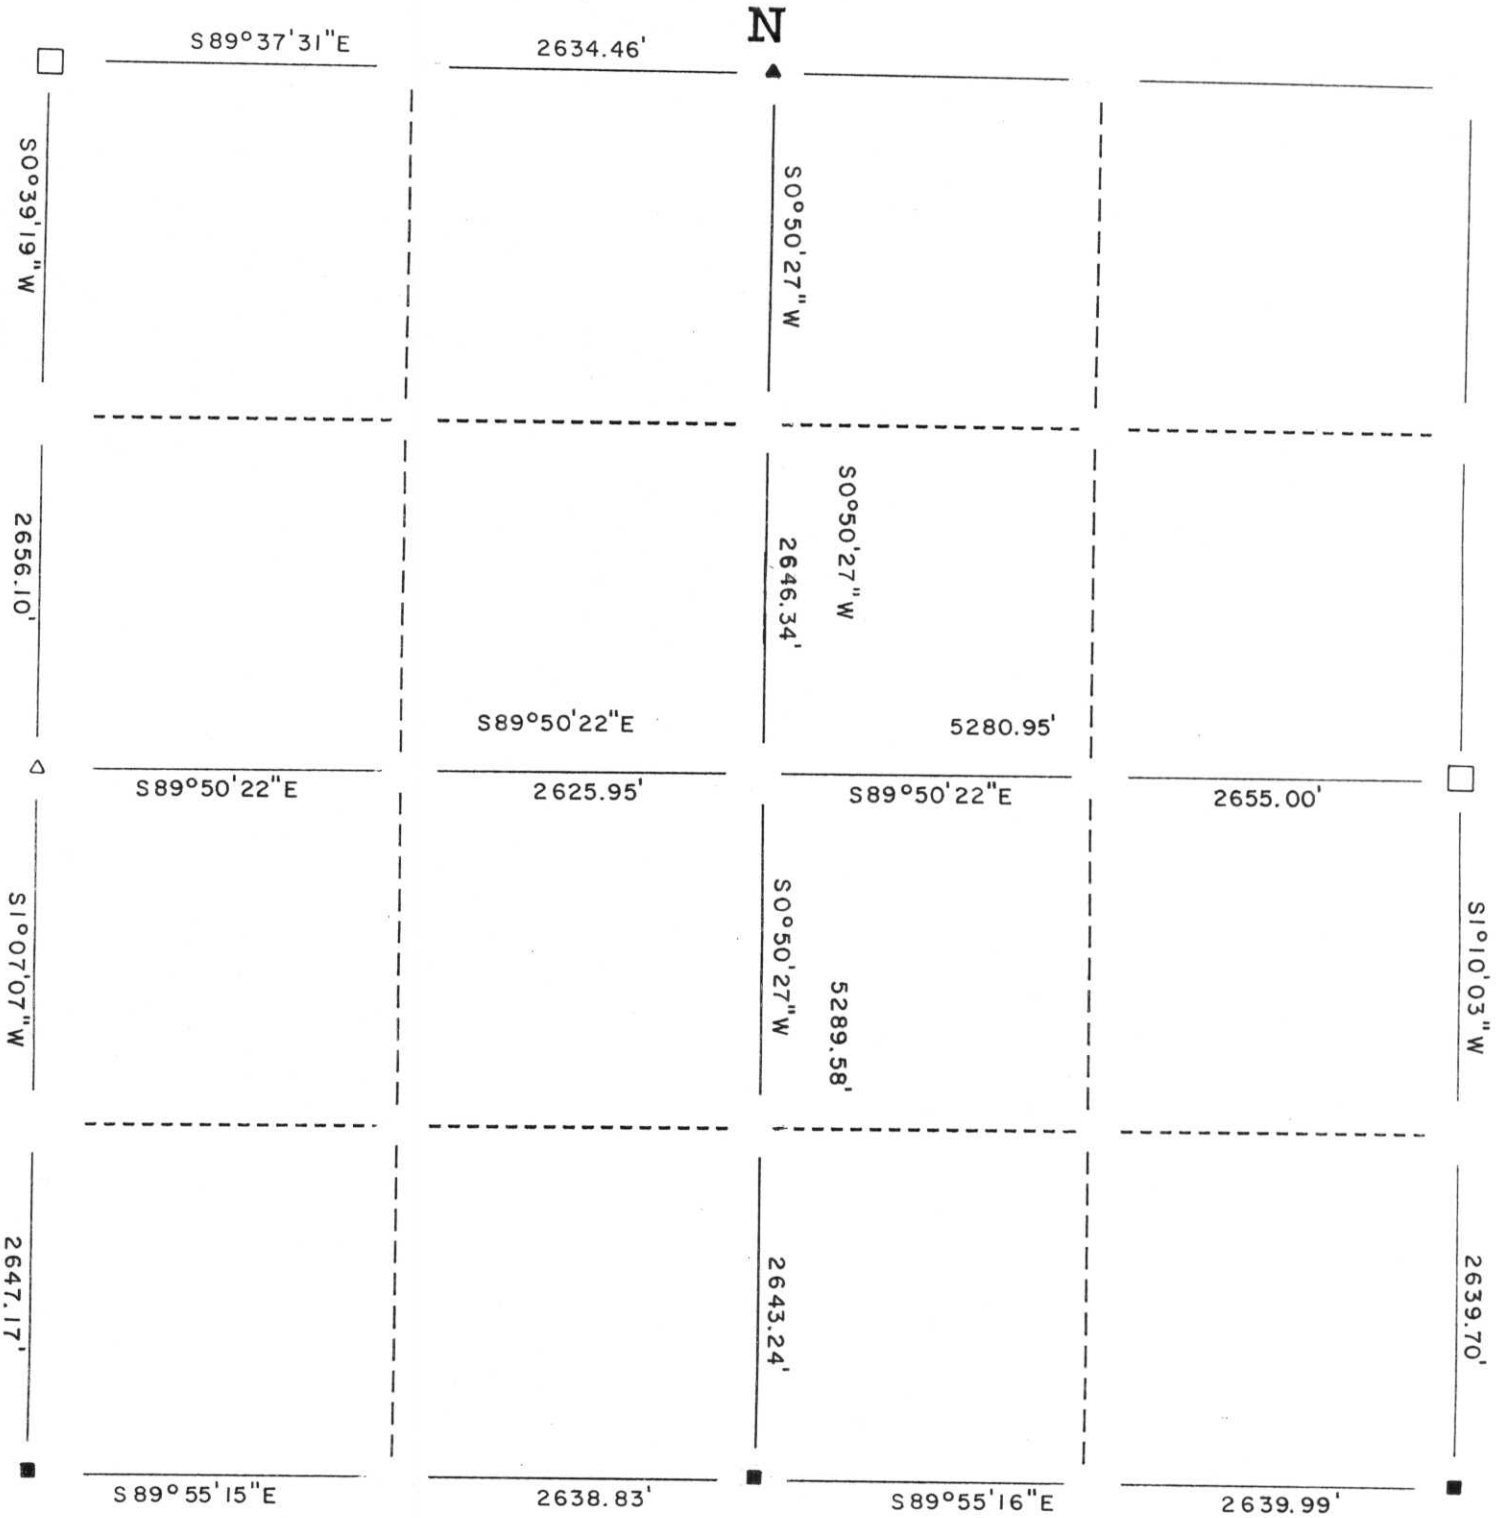

LEGEND


- Berntsen Monument
- 2" Iron Pipe
- Stone or Concrete Monument
- 1" Iron Pipe
- Iron Pipe
- Other
- EXISTING PK NAIL
- SET 60D NAIL FROM TIES
- SET BERNTSEN SURVEY MARK NAIL

RECEIVED BY LINCOLN COUNTY
SURVEYOR THIS 13TH DAY
OF February 20 08
Tom Wall
COUNTY SURVEYOR




CERTIFIED CORRECT:
DAVID J. GOSLIN
David J. Goslin
Registered Land Surveyor

DATE: 1-24-08

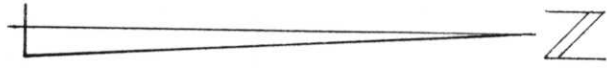

SCALE: 1"=1000'
 0 500' 1000'

- LEGEND**
- (M) MEASURED DISTANCE
 - (R) RECORD HIGHWAY STATIONING DISTANCE FROM HIGHWAY FIELD NOTES
 - EXISTING PK NAIL
 - ▲ EXISTING BERTNSEN SURVEY MARK NAIL
 - △ SET BERTNSEN SURVEY MARK NAIL
 - HWY HIGHWAY STATIONING DISTANCE FROM RIGHT OF WAY PLAT DIVISION JOB NO. 7035

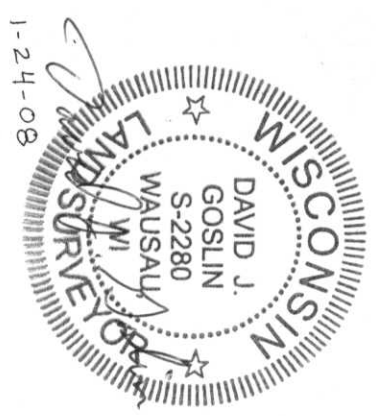

PROPORTION FOR SOUTHEAST CORNER SECTION 8
 $(M) 5271.99' = \frac{2639.99'}{2642.00'} = \frac{2632.00'}{2634.00'}$
 HWY 5276.00' = 2642.00' = 2634.00'

