


SECTION SUMMARY

12 - 31N - 6E
Section Township Range
CITY OF MERRILL
Town

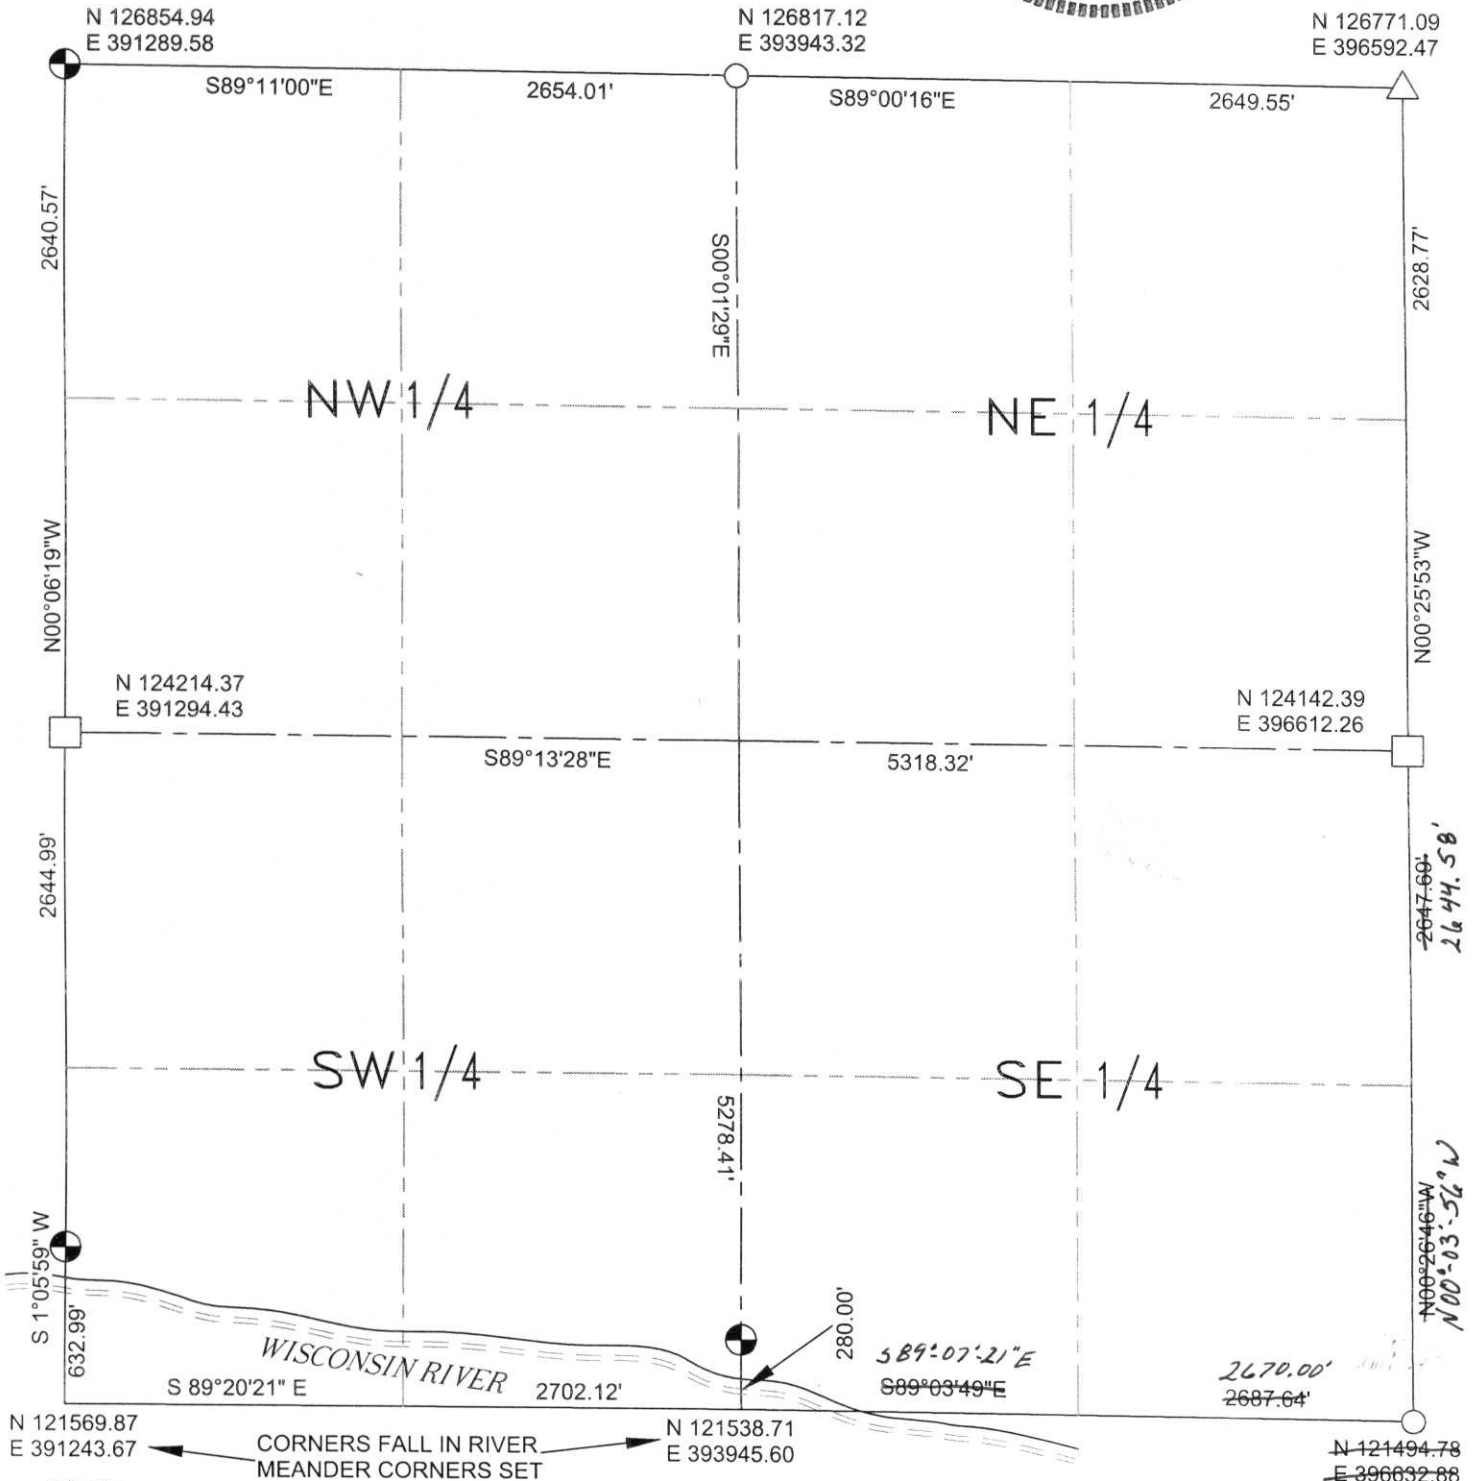

NOTES:
COORDINATES AND BEARINGS ARE REFERENCED TO THE LINCOLN COUNTY COORDINATE SYSTEM AS DEVELOPED BY THE WISCONSIN DEPARTMENT OF TRANSPORTATION AND WERE DETERMINED BY GPS OBSERVATIONS ON CONTROL POINTS AS SUPPLIED BY THE WDOT.

LEGEND

- ⊙ - BERNSTEN ALUMINUM MONUMENT
- - BERNSTEN SURVEY NAIL
- - FOUND STONE MONUMENT
- - Iron Bar
- △ - FOUND P.K. NAIL

RECEIVED AT LINCOLN COUNTY
COURTHOUSE THIS 25TH DAY
OF June 20 01
Tommy Wallum
LAND INFORMATION OFFICE

CERTIFIED CORRECT:

David A. Renaud
S-2142
Registered Land Surveyor
DATE: 6/18/01

R.E.I. 4080 N. 20th AVE WAUSAU, WI 54401 (715)675-9784

D.D. 02/08/01 16:44:58
E: 1 - 21:25