
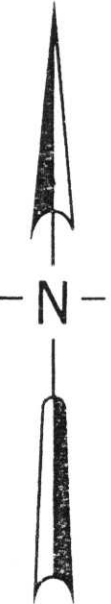


LINCOLN COUNTY

SECTION SUMMARY

13 - 31 - 6
Section Town Range

SCOTT
Township

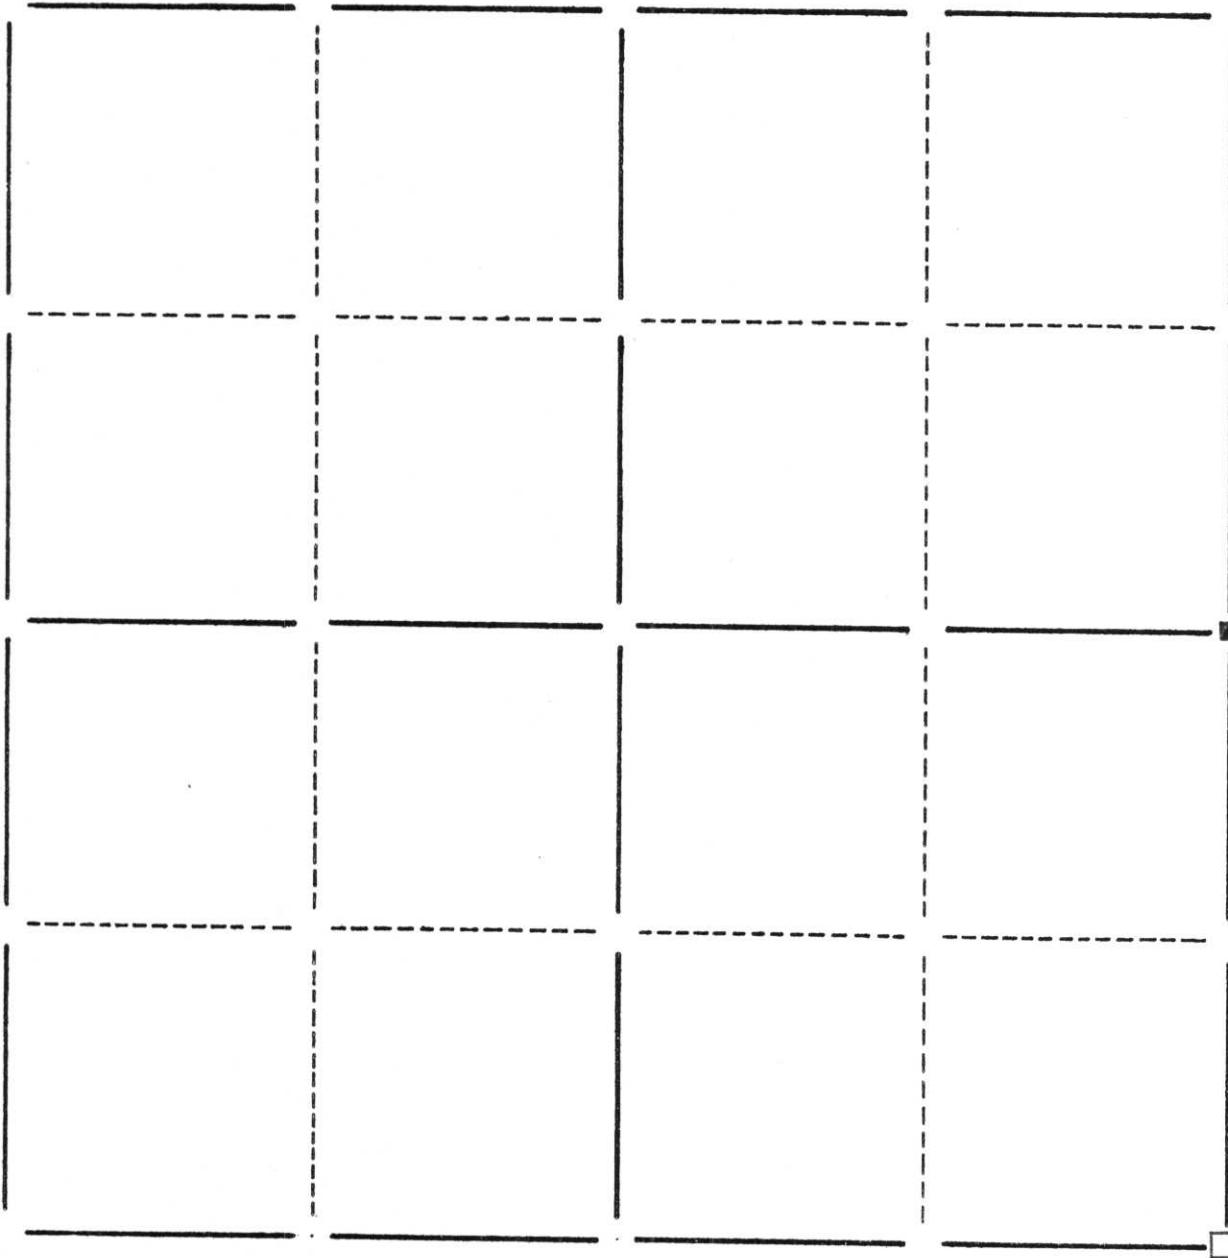

LEGEND

- ⊕ - Harrison Cast Iron Monument
- - Stone or Concrete Monument
- - 2" Iron Pipe
- - 1" Iron Pipe
- - Iron Bar

- △ - RR Spike
- - PK Nail
- - Other - Berntsen Monument
- ◇ - _____
- ▲ - _____

Bearings are referenced to CSM #1066

Robert K. Fergot
Robert K. Fergot Jan. 25, 1999



RECEIVED AT LINCOLN COUNTY
COURTHOUSE THIS 28th DAY
OF Jan 19 99
Pat Aruba
LAND INFORMATION OFFICE

I.M-21:25