




14 - 31 - 6
Section Town Range

CITY MERRILL
SCOTT Township

SECTION SUMMARY

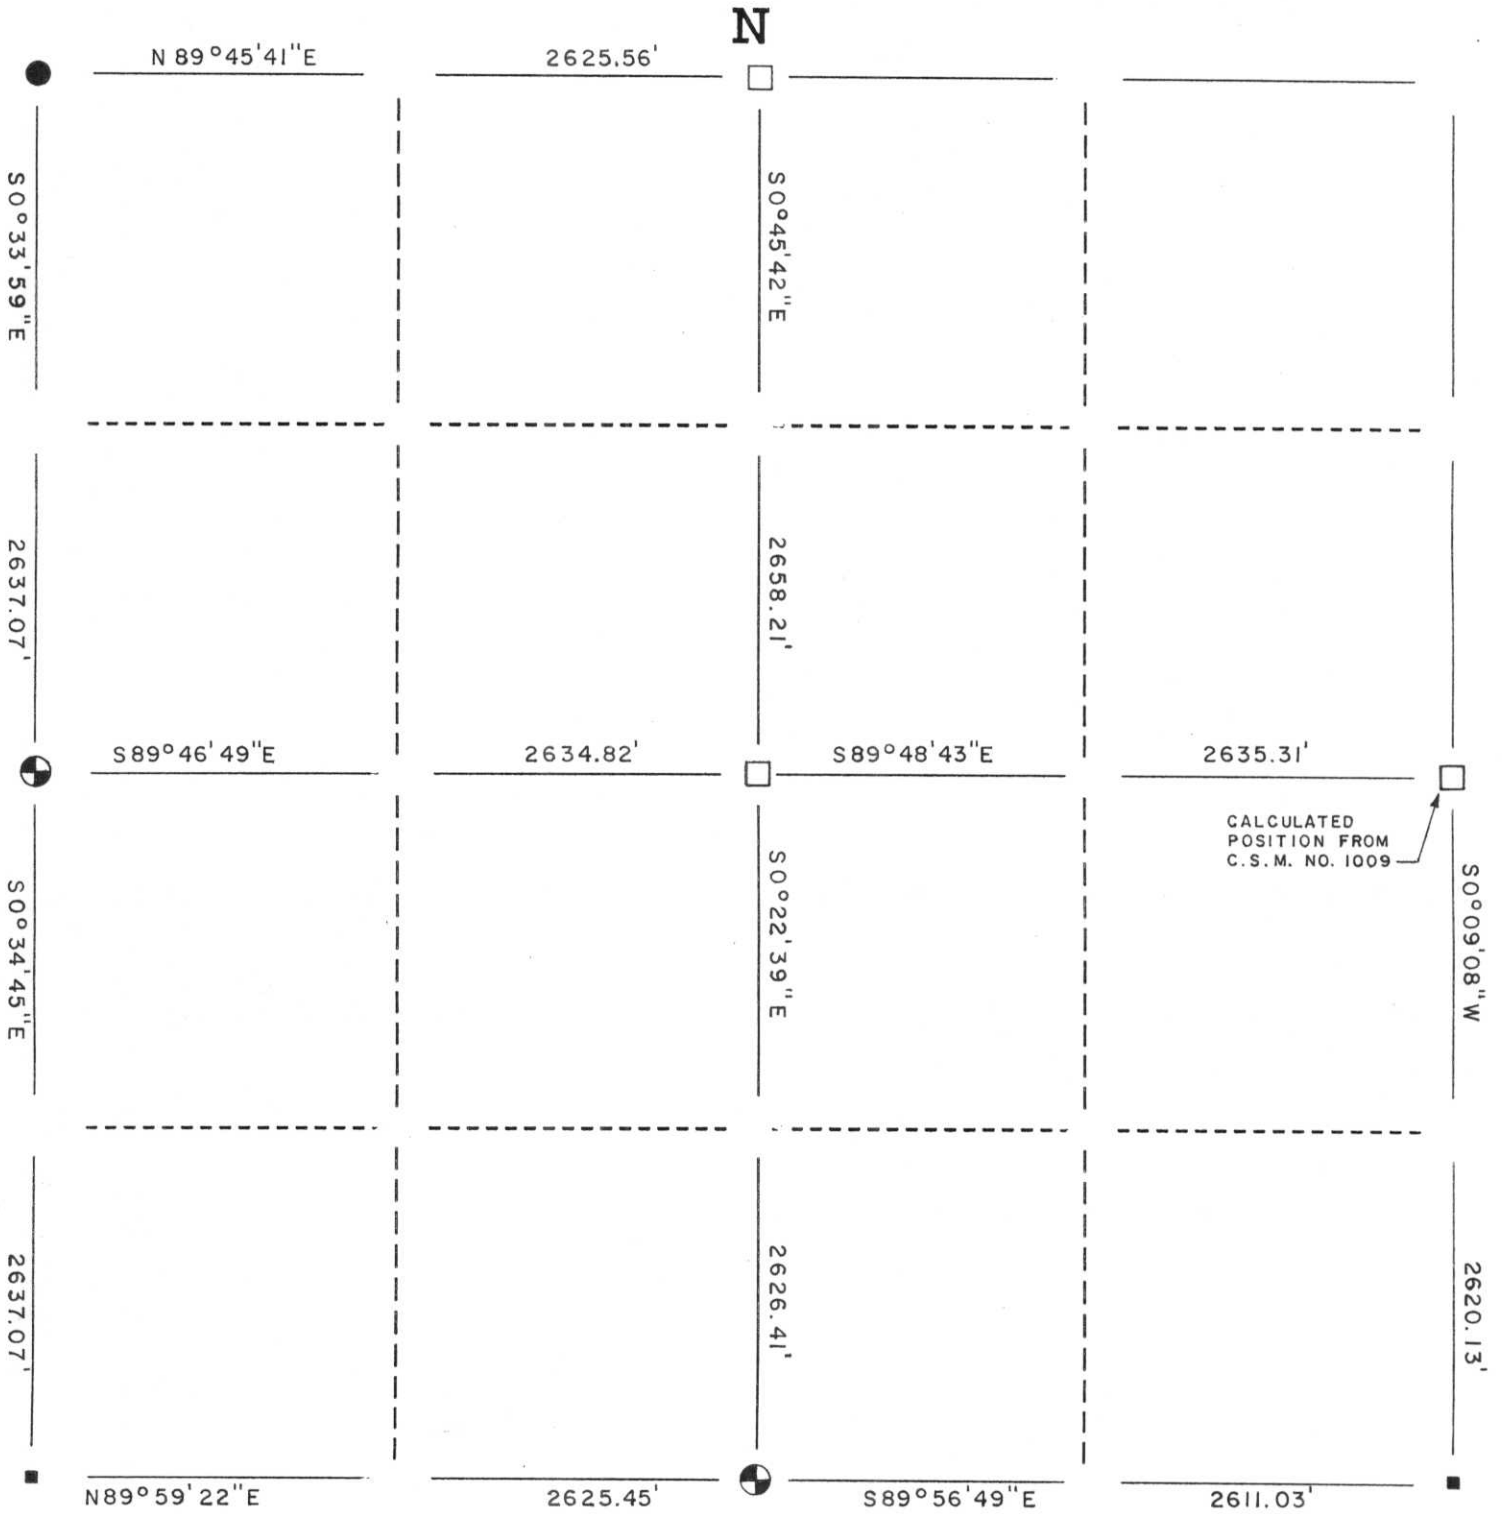

LEGEND

- Berntsen Monument
- 2" Iron Pipe
- Stone or Concrete Monument
- 1" Iron Pipe
- ~~Iron Pipe~~ 1" RE-BAR
- Other PK NAIL

RECEIVED BY LINCOLN COUNTY
SURVEYOR THIS 15TH DAY
OF March 20 06
Tony Dall
COUNTY SURVEYOR

CERTIFIED CORRECT:

David J. Dolin
Registered Land Surveyor

DATE: 2-21-06



I: M-17:21