




LINCOLN COUNTY

SECTION SUMMARY

18 - 31 - 6
Section Town Range
SCOTT
Township

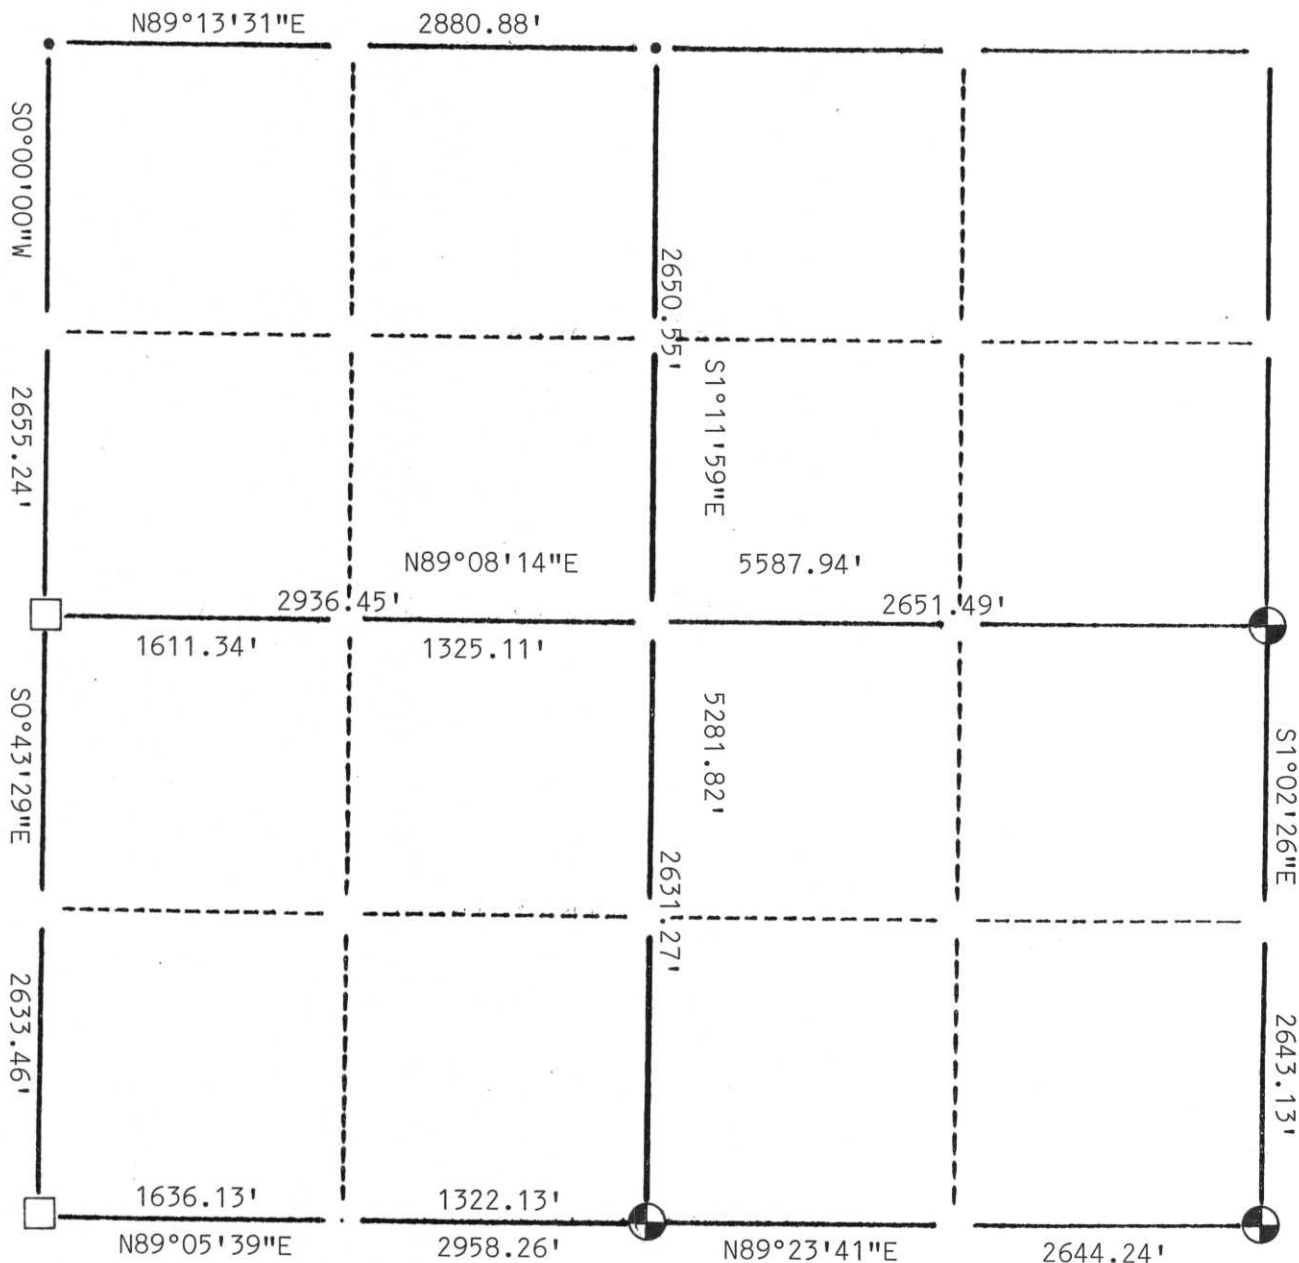

LEGEND

- ⊙ - LINCOLN COUNTY BERNTSEN MONUMENT
- - Stone or Concrete Monument
- - 2" Iron Pipe
- - 1" Iron Pipe
- - Iron Bar
- - NAIL

CERTIFIED CORRECT:
Edwin R. Abendroth
 Edwin R. Abendroth RLS No. S-798
 Registered Land Surveyor
 DATE: October 27, 1997

RECEIVED AT LINCOLN COUNTY
 COURTHOUSE THIS 6th DAY
 OF Nov 1997
Pat Priske
 TAX DESCRIPTION OFFICE



I: M - 1:5