


LINCOLN COUNTY

SECTION SUMMARY

21	-	31	6
Section		Town	Range
21		31	6
SCOTT			
Township			

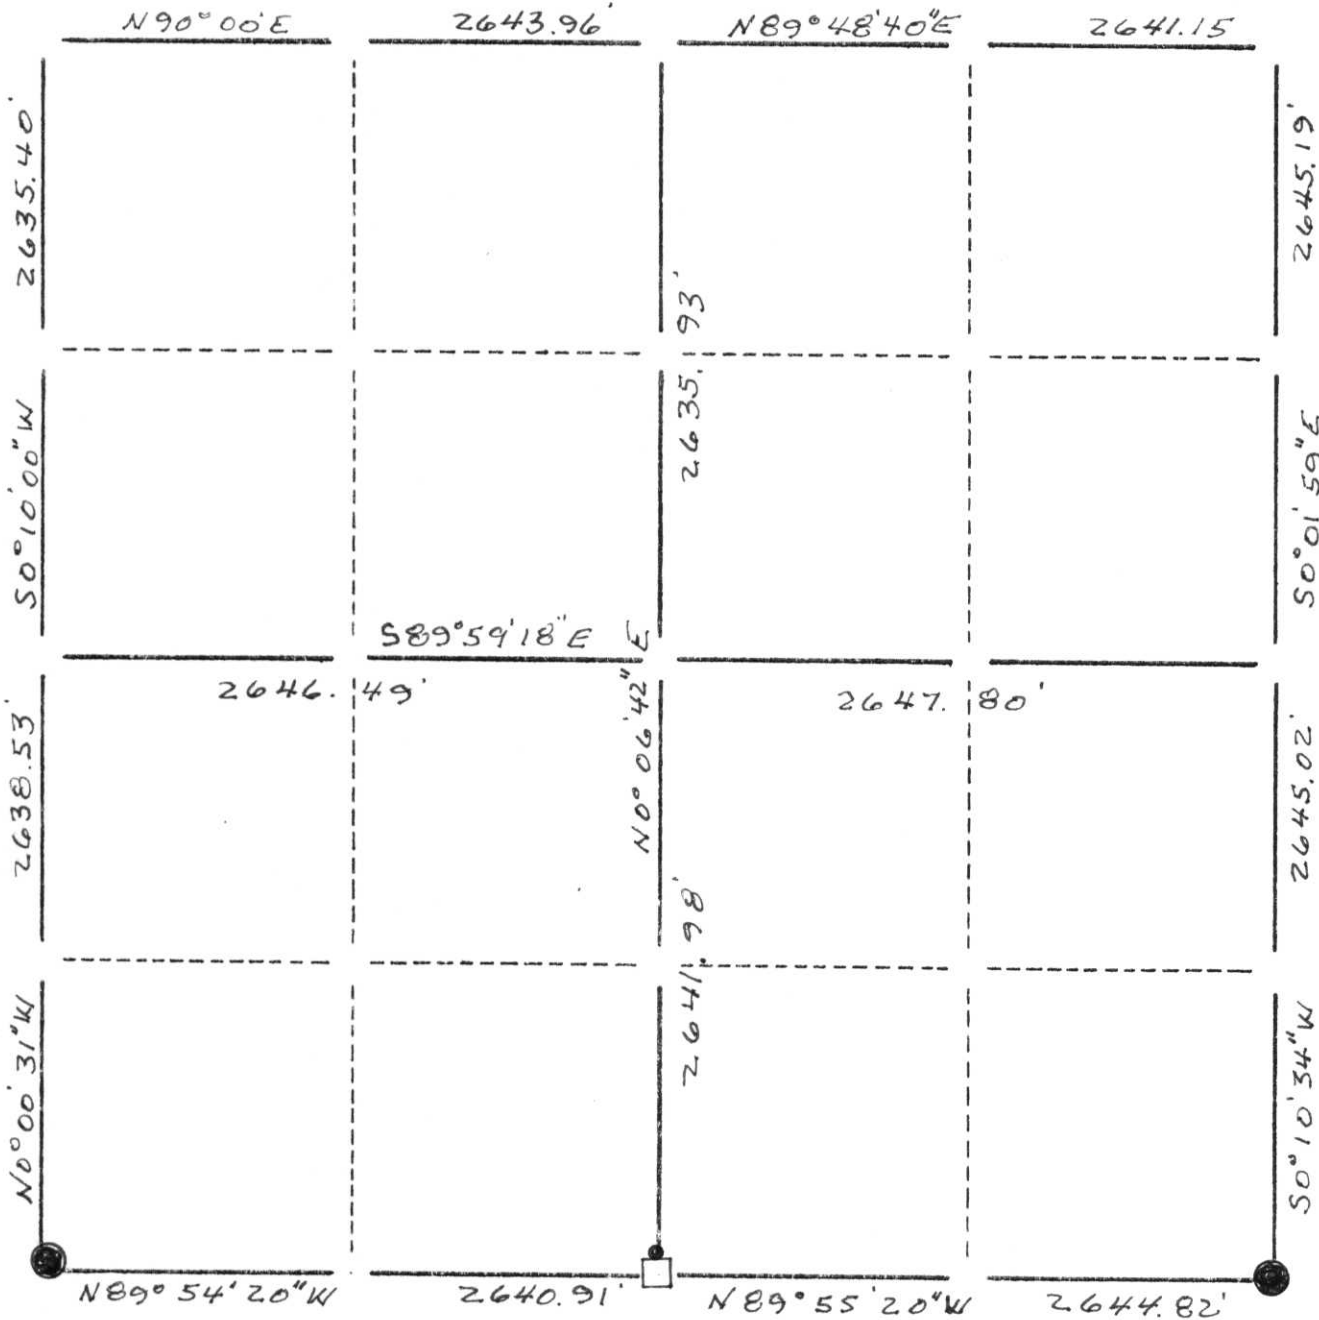

LEGEND

- ⊗ - Harrison Cast Iron Monument
- - Stone or Concrete Monument
- - 2" Iron Pipe
- - 1" Iron Pipe
- - Iron Bar
- △ - RR Spike
- - PK Nail
- - Other - Berntsen Monument
- ◇ - _____
- ▲ - _____

Only the corners on the south line of Section 21 were remonumented by me as indicated. All other corners were located from tie sheets from the county surveyors records, for my survey of the section.



RECEIVED AT LINCOLN COUNTY
 COURTHOUSE THIS 8th DAY
 OF Oct. 19 97
Pat Priske
 TAX DESCRIPTION OFFICE

Robert K. Fergot
 Robert K. Fergot

October 7, 1997

Index No. M.Q. - 9:13