
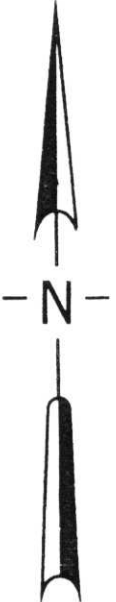


LINCOLN COUNTY

SECTION SUMMARY

25 - 31 - 6
 Section Town Range
 SCOTT
 Township

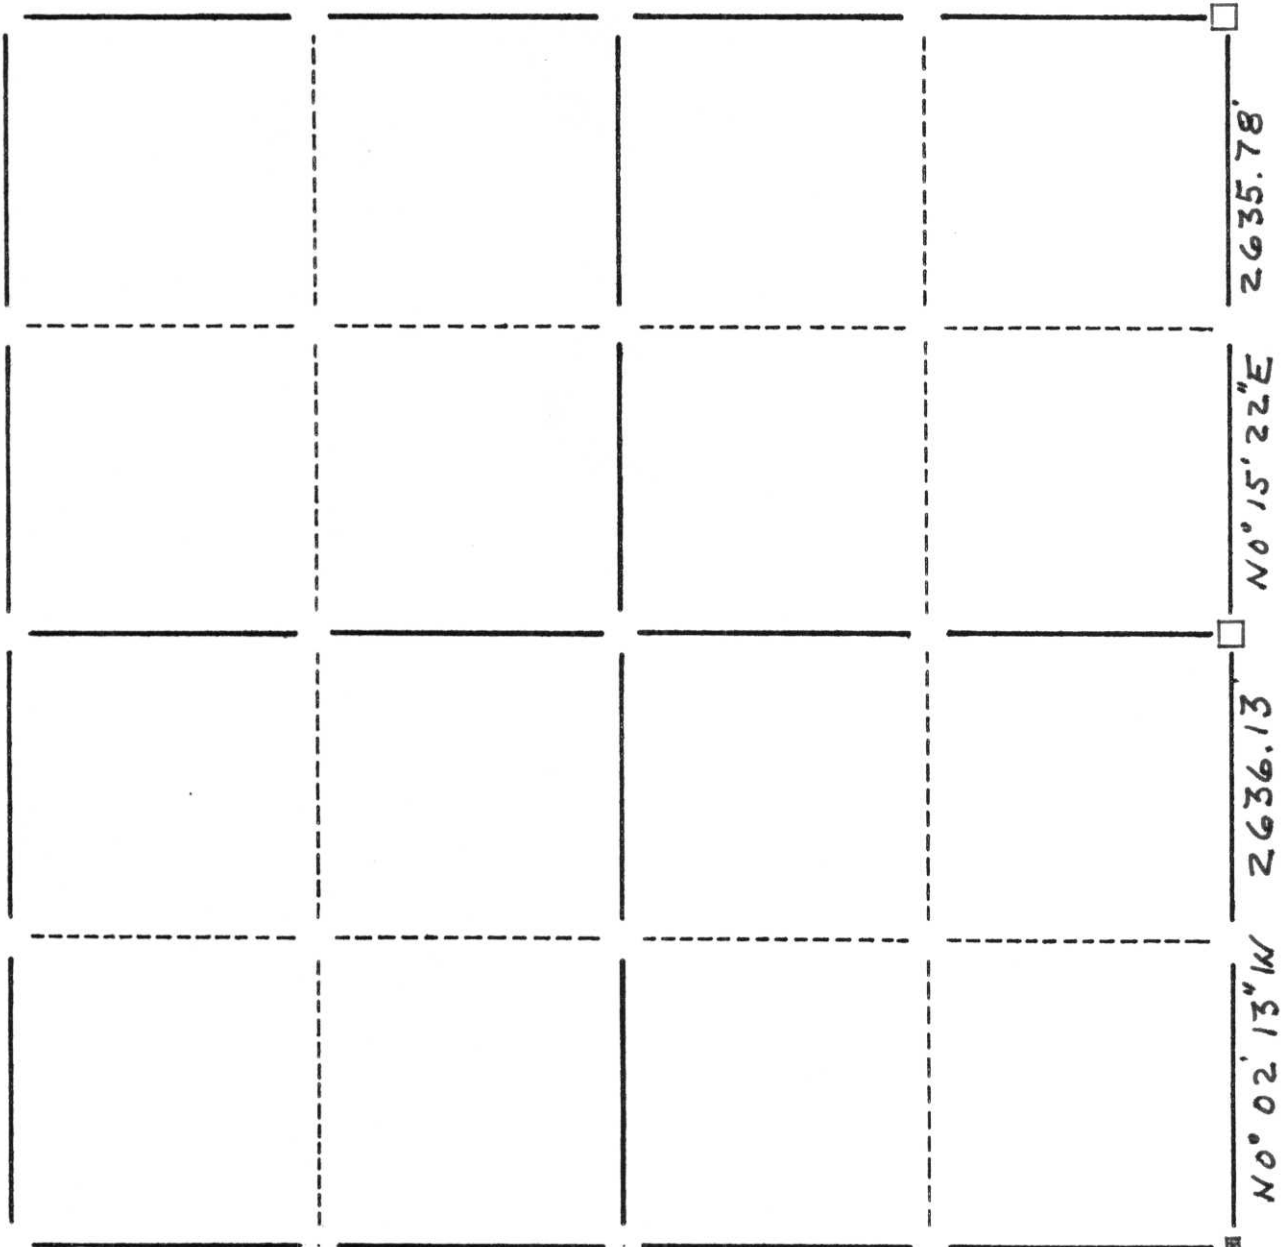

LEGEND

- ⊕ - Harrison Cast Iron Monument
- - Stone or Concrete Monument
- - 2" Iron Pipe
- - 1" Iron Pipe
- - Iron Bar
- △ - RR Spike
- - PK Nail
- - Other -Berntsen Monument

RECEIVED AT LINCOLN COUNTY
 COURTHOUSE THIS 28th DAY
 OF Jan. 19 99
Pat Priske
 LAND INFORMATION OFFICE

Bearings are referenced to
 CSM #1066

Robert K. Fergot
 Robert K. Fergot Jan 25, 1999

