


# Lincoln County

SECTION SUMMARY

29	31N	6E
Section	Township	Range
SCOTT		
Town		

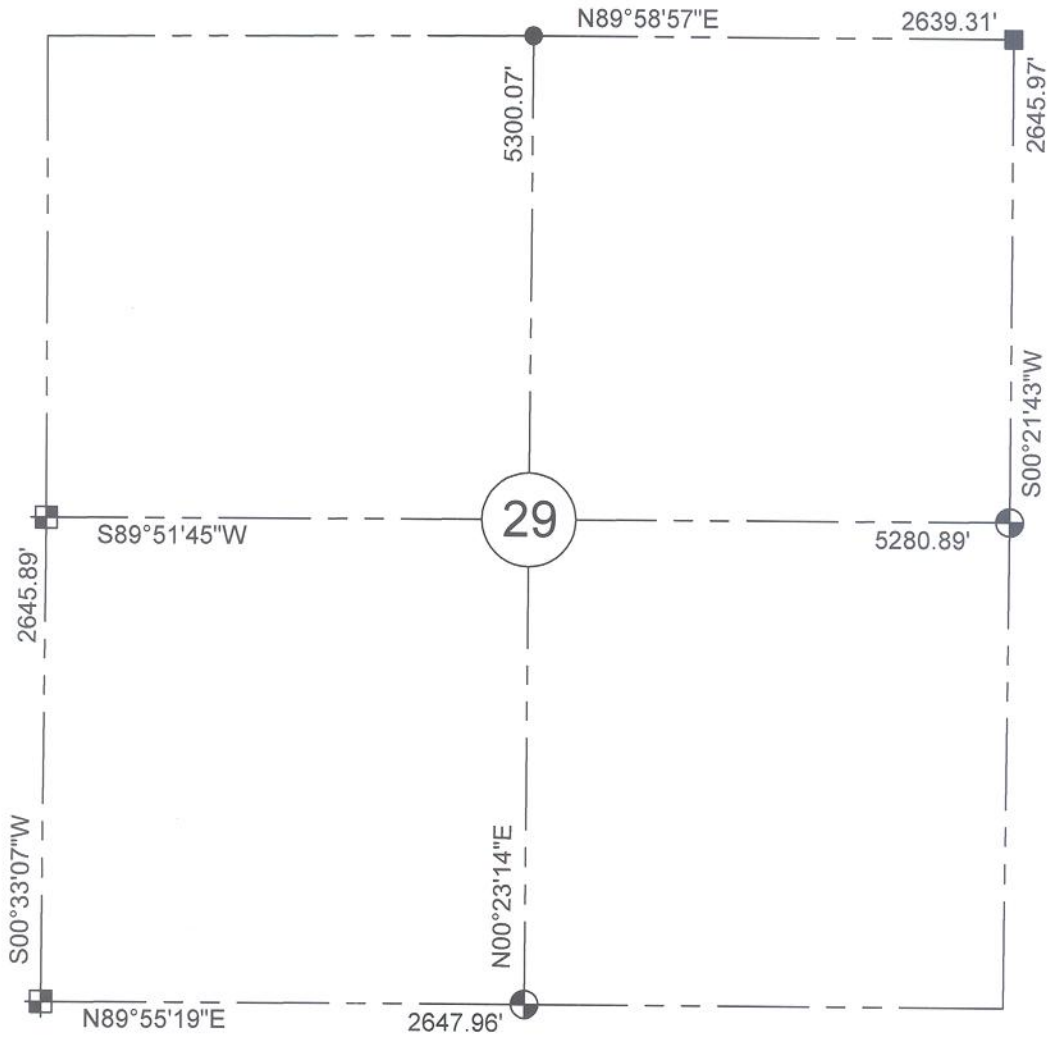

NOTE:  
BEARINGS ARE BASED ON THE LINCOLN COUNTY  
COORDINATE SYSTEM.


RECEIVED BY LINCOLN COUNTY  
SURVEYOR THIS 25<sup>TH</sup> DAY  
OF May 20 07  
*Tomy Walk*  
COUNTY SURVEYOR



LEGEND

- BERNSTEN MONUMENT
- SET MAG NAIL
- FOUND GRANITE STONE
- FOUND MAG NAIL

CERTIFIED CORRECT:  
*Keith J. Walkowski*  
KEITH J. WALKOWSKI  
Registered Land Surveyor  
DATE: 5-24-07


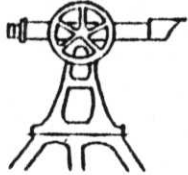


LINCOLN COUNTY

SECTION SUMMARY

29 - 31 - 6  
Section Town Range

SCOTT  
Township

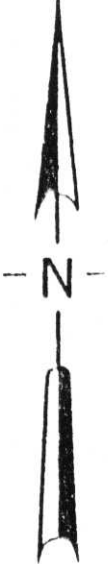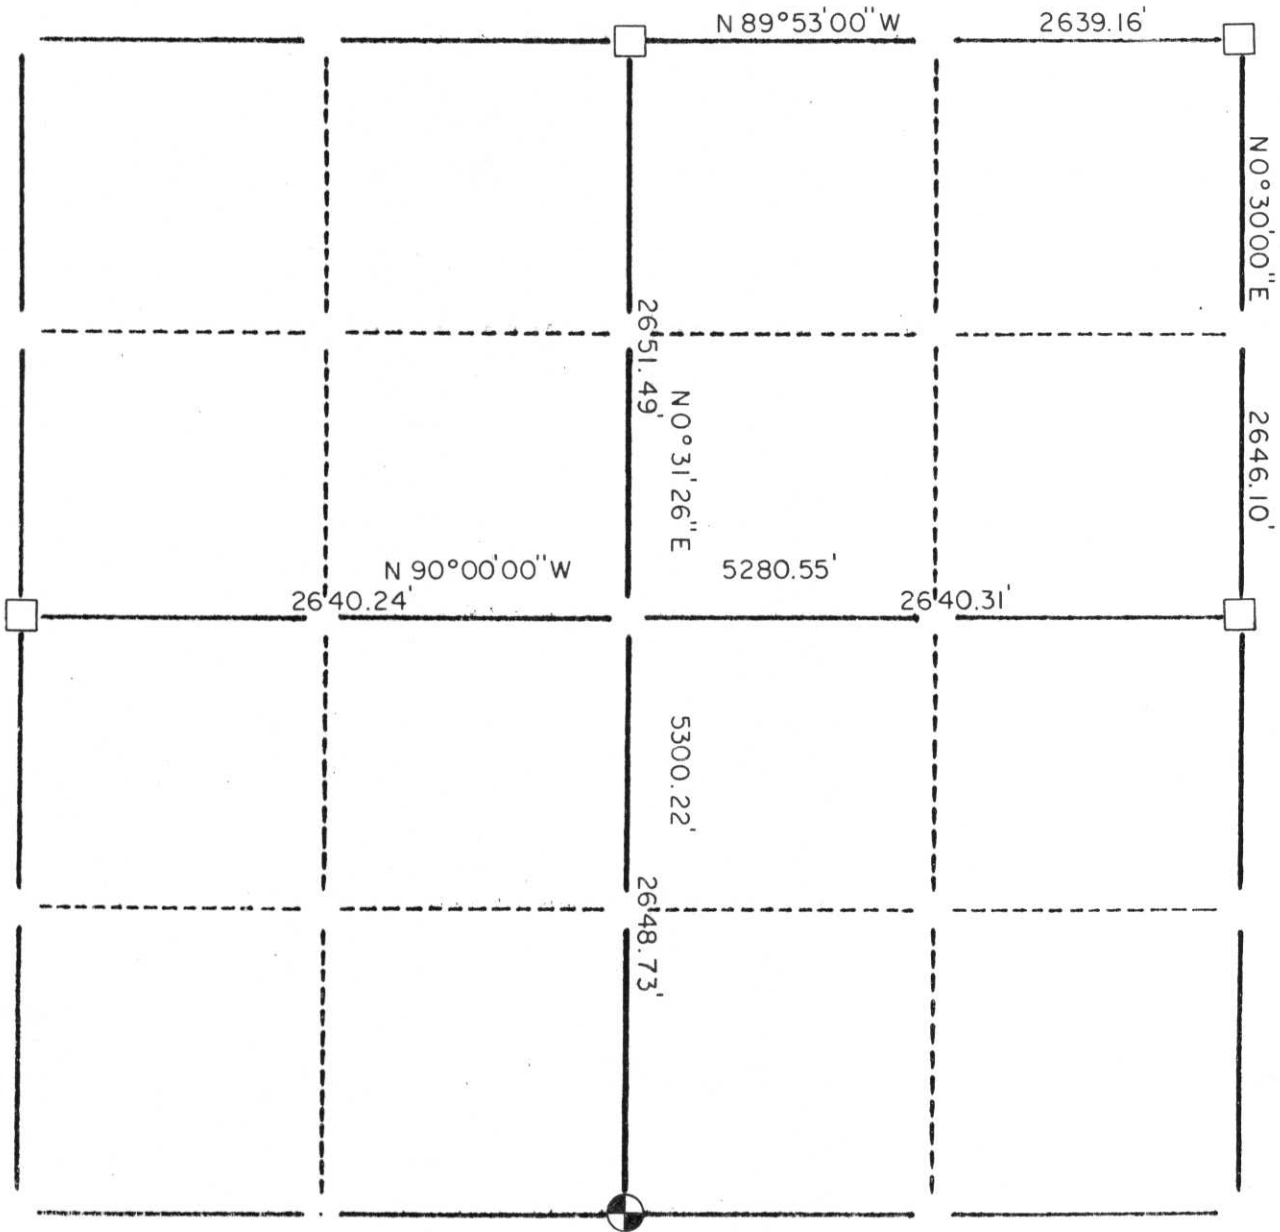

LEGEND

- - LINCOLN COUNTY BERNTSEN MONUMENT
- - Stone or Concrete Monument
- - 2" Iron Pipe
- - 1" Iron Pipe
- - Iron Bar
- - NAIL



CERTIFIED CORRECT:  
*Edwin R. Abendroth*  
 Edwin R. Abendroth RLS No. S-798  
 Registered Land Surveyor  
 DATE: June 8, 1998

RECEIVED AT LINCOLN COUNTY  
 COURTHOUSE THIS 9th DAY  
 OF July 19 98  
*Pat Prebe*  
 TAX DESCRIPTION OFFICE