
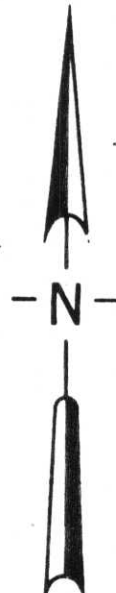


NOTE: See John Romatowski survey (1987)

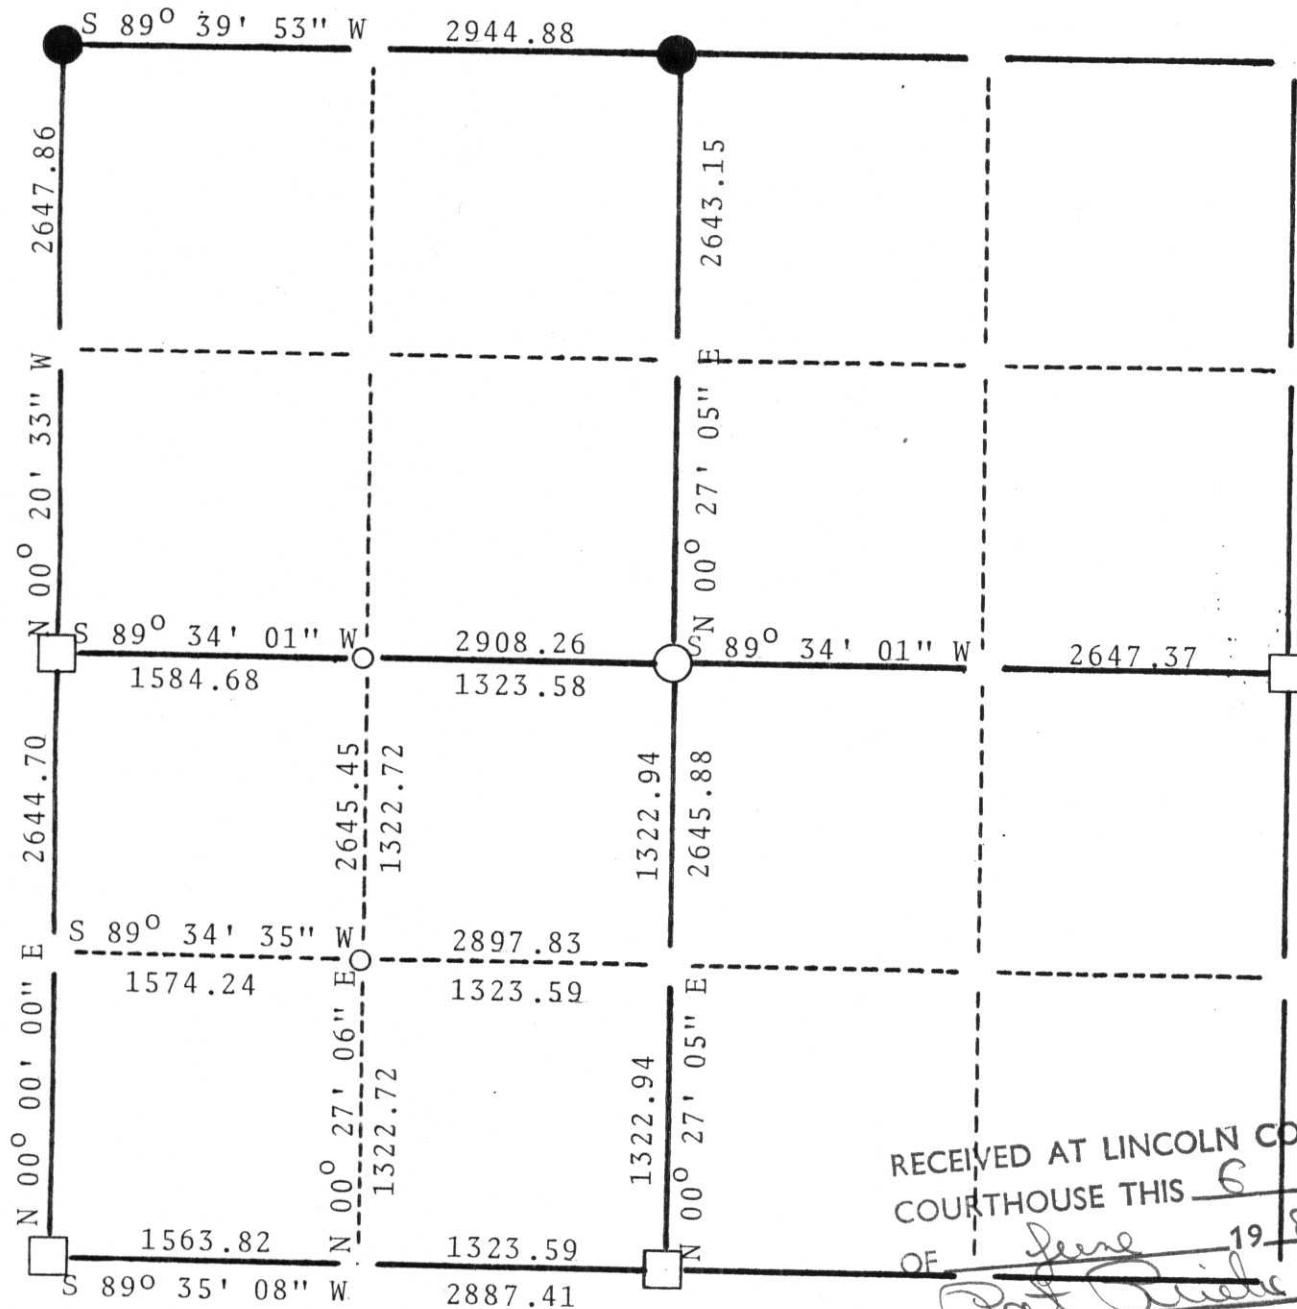

RECEIVED AT LINCOLN COUNTY  
COURTHOUSE THIS 6 DAY  
OF June 1983.  
*Pat Drieh*  
TAX DESCRIPTION OFFICE

**LEGEND**

- ⊕ - Harrison Cast Iron Monument
- - Stone or Concrete Monument
- - 2" Iron Pipe
- - 1" Iron Pipe
- - Iron Bar

- △ - RR Spike
- - PK Nail
- - Other - Berntsen Monument
- ◇ - \_\_\_\_\_
- ▲ - \_\_\_\_\_


**LHM** SURVEYING

6006 HILGEMAN STREET • SCHOFIELD, WI 54476

P:11-1:5

**Lincoln  
County  
Surveyor**

SECTION SUMMARY    30    31    6  
Section    Township    Range  
SCOTT  
Town

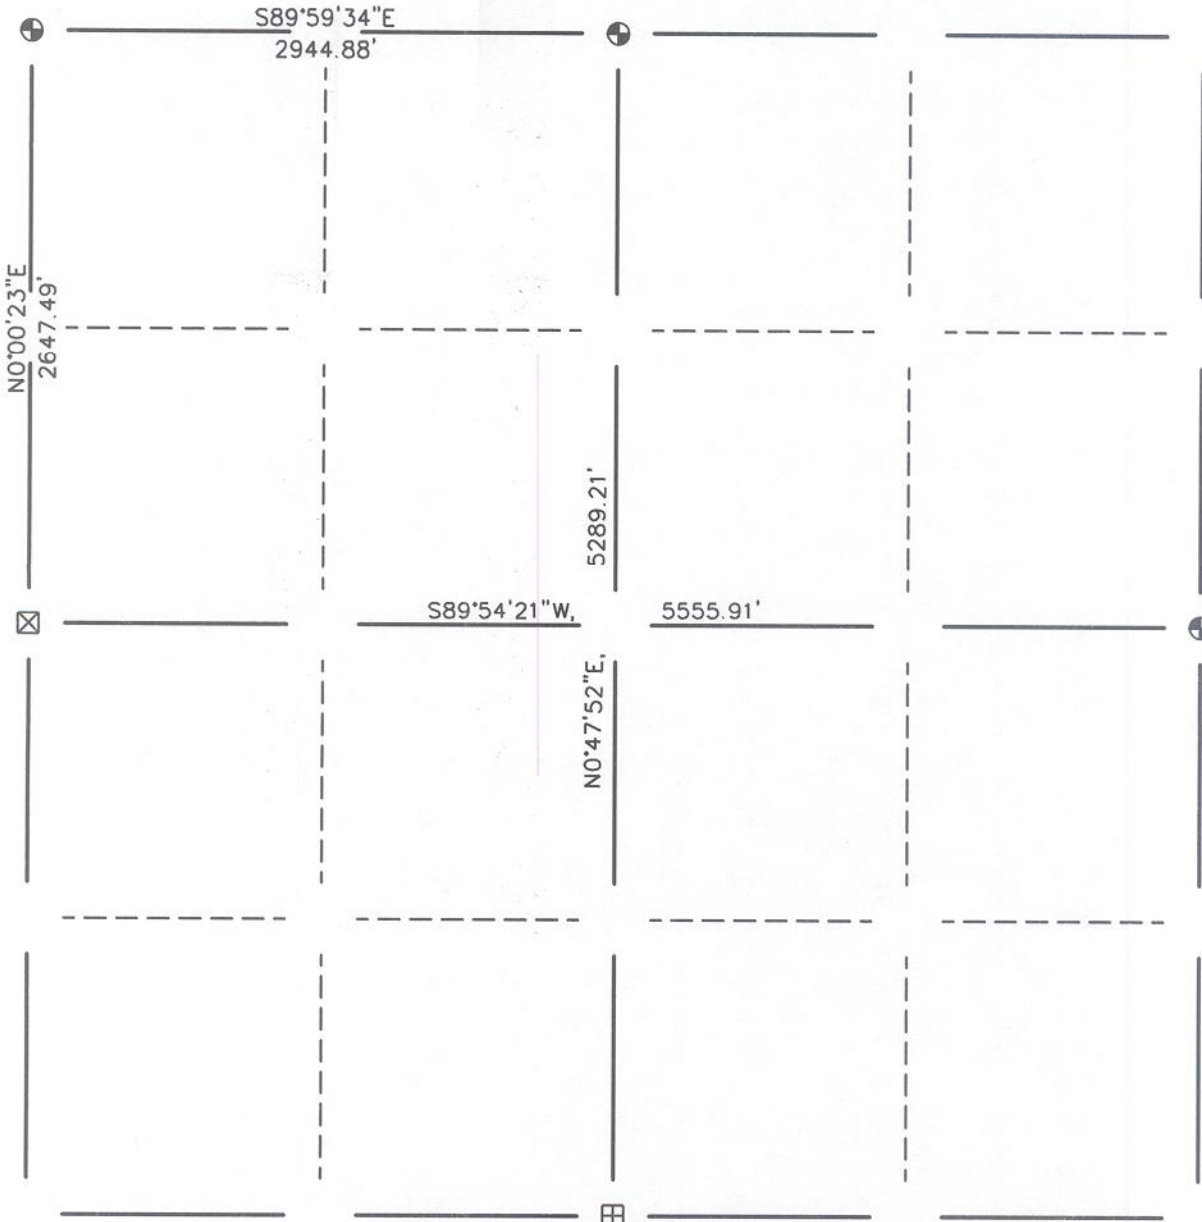

**LEGEND**

- ⊕ - Berntsen Monument
- ⊠ - 7" x 7" Granite Stone Monument
- ⊗ - 6" x 6" Limestone Monument

CERTIFIED CORRECT:  
William W. Nutter, RLS  
*William W. Nutter*  
Registered Land Surveyor  
DATE: 4-7-2004