


LINCOLN COUNTY



4 - 31 - 7
Section Town Range


PINE RIVER
Township

SECTION SUMMARY

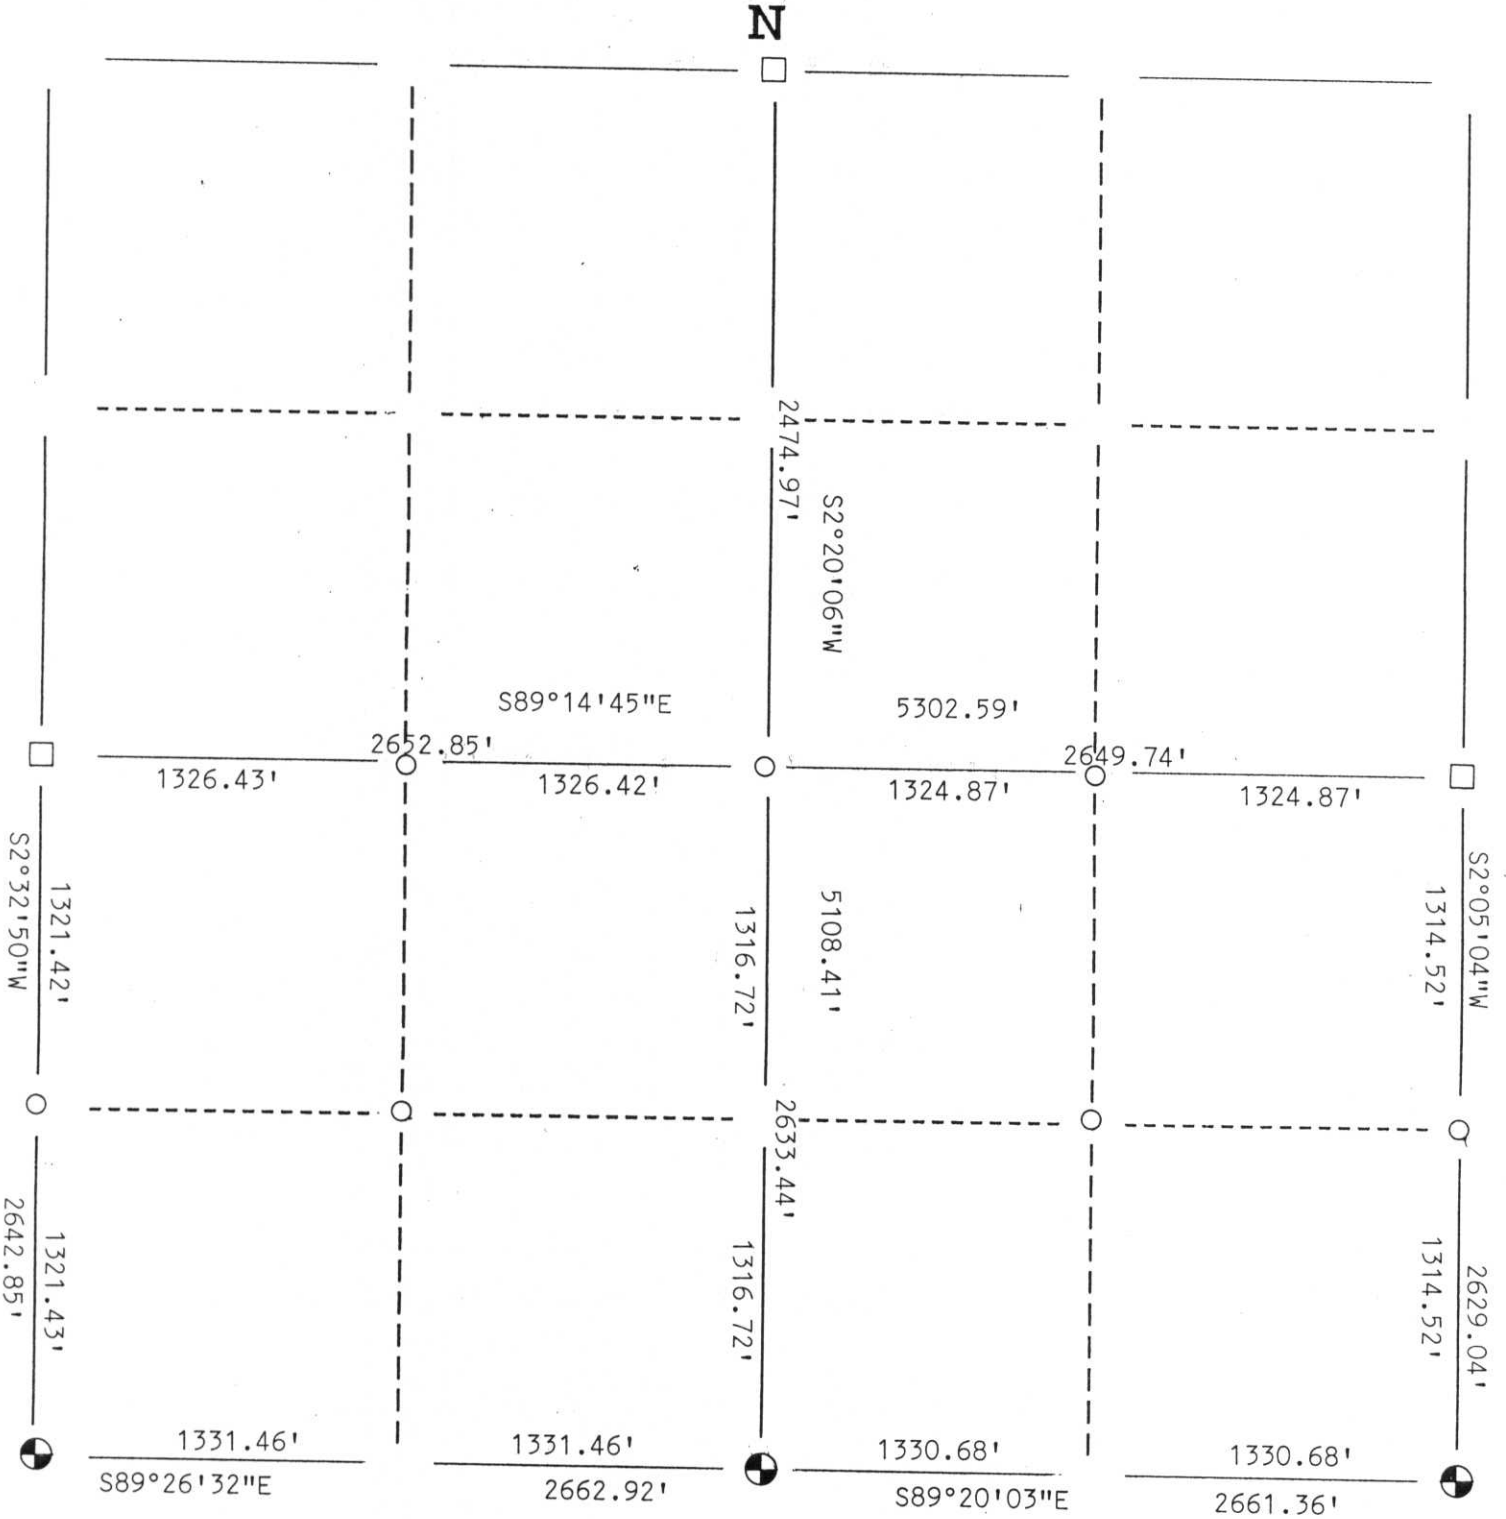

LEGEND

- Berntsen Monument
- 2" Iron Pipe
- Stone or Concrete Monument
- 1" Iron Pipe
- Iron Pipe 1/4" SET
- Other

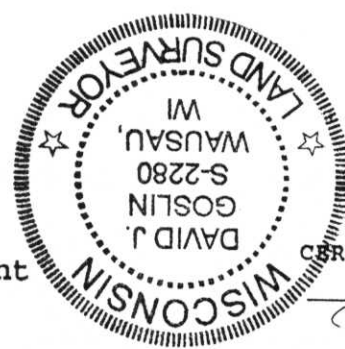

RECEIVED BY LINCOLN COUNTY
SURVEYOR THIS 9TH DAY
OF November 20 05
Tommy Dalk
COUNTY SURVEYOR

CERTIFIED CORRECT:
David J. Goslin
Registered Land Surveyor

DATE: 1-21-00

CLOSED TRA.

A, E: 9, 13



LINCOLN COUNTY








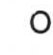


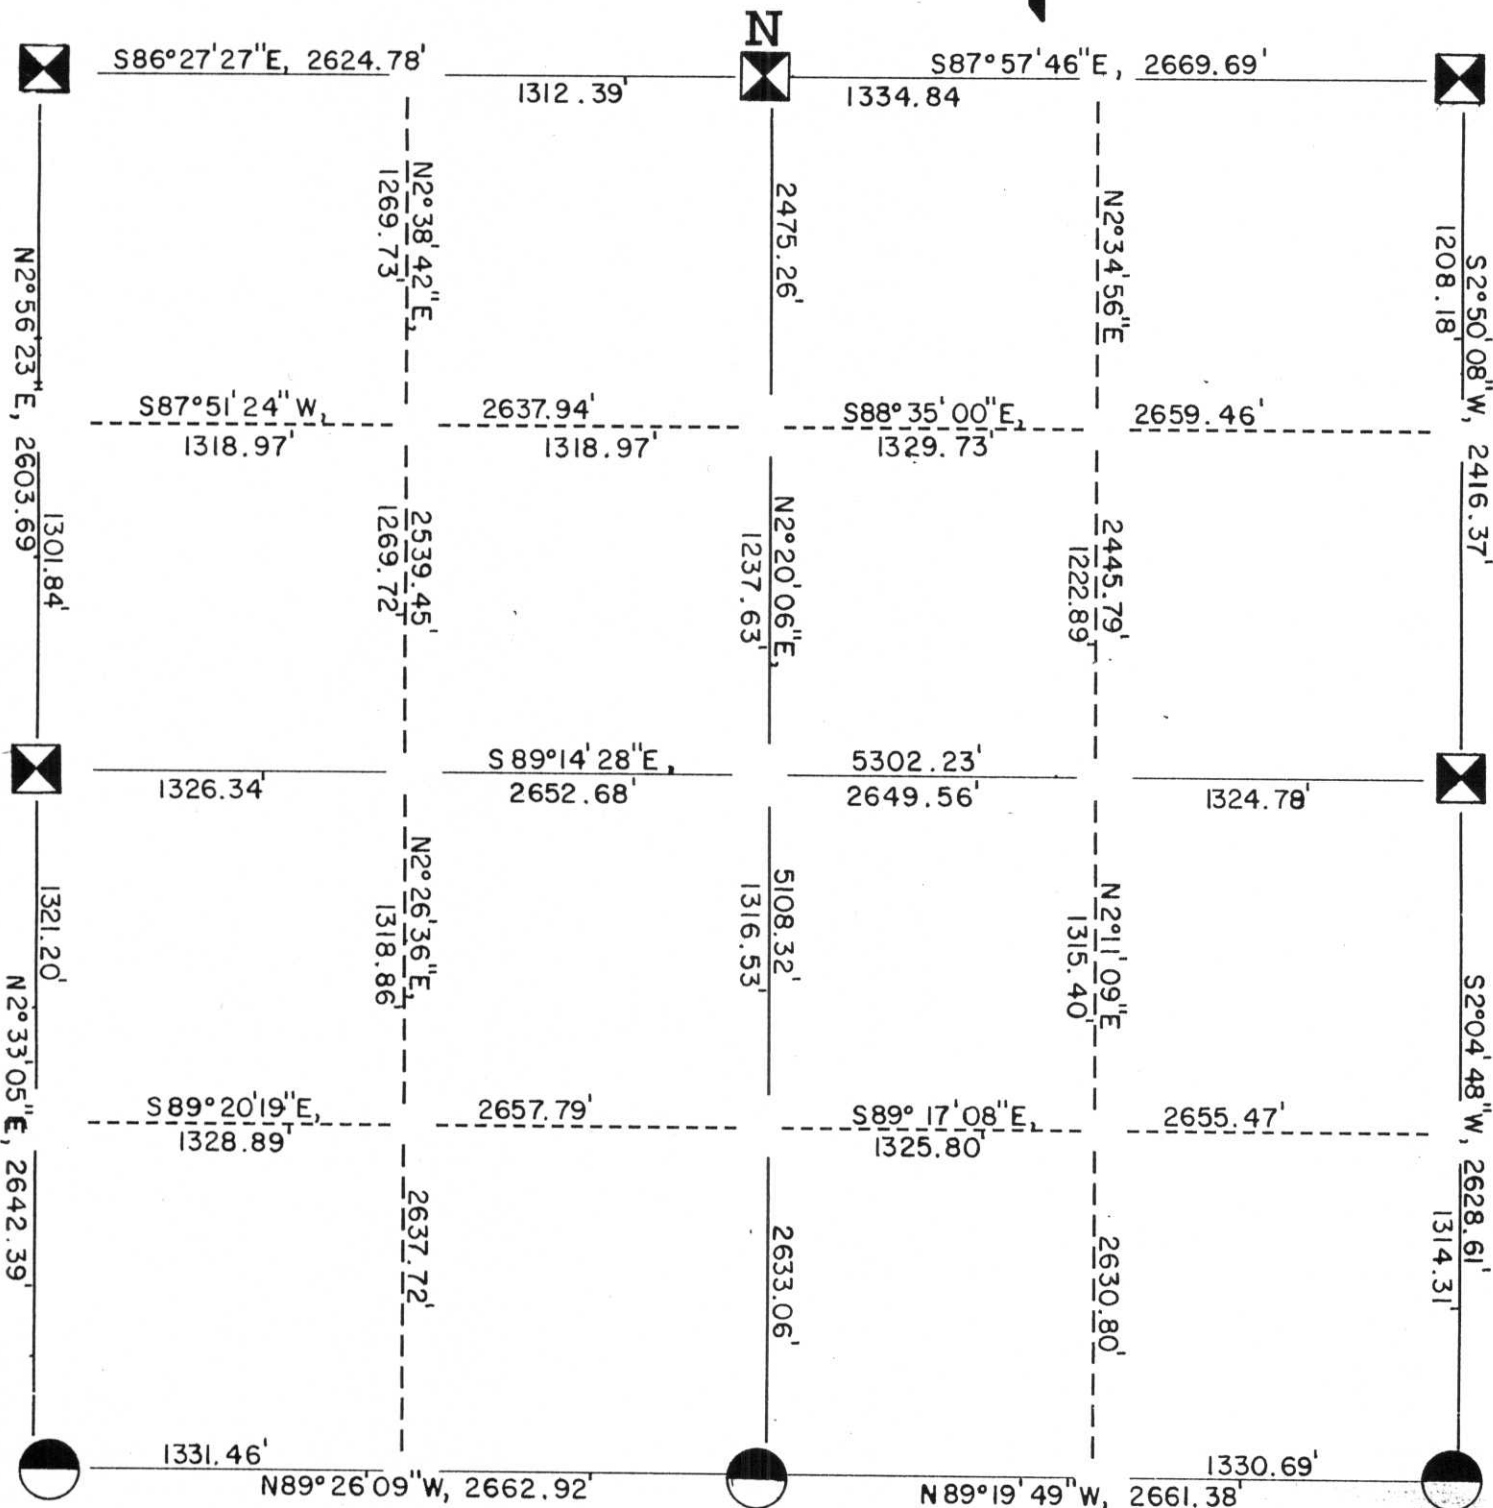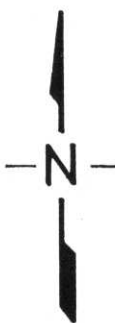4 - 31 - 7
Section Township Range

PINE RIVER
Township

SECTION SUMMARY



LEGEND

-  Berntsen Monument 
-  2" Iron Pipe
-  Stone or Concrete Monument 
-  1" Iron Pipe
-  Iron Pipe
-  Other

RECEIVED AT LINCOLN COUNTY
COURTHOUSE THIS 22nd DAY
OF Dec. 19 98
Pat Priebe
LAND INFORMATION OFFICE

CERTIFIED CORRECT:
William W. Mutter
Lincoln Land Survey
Registered Land Surveyor

DATE: 12-21-98

AE-913