
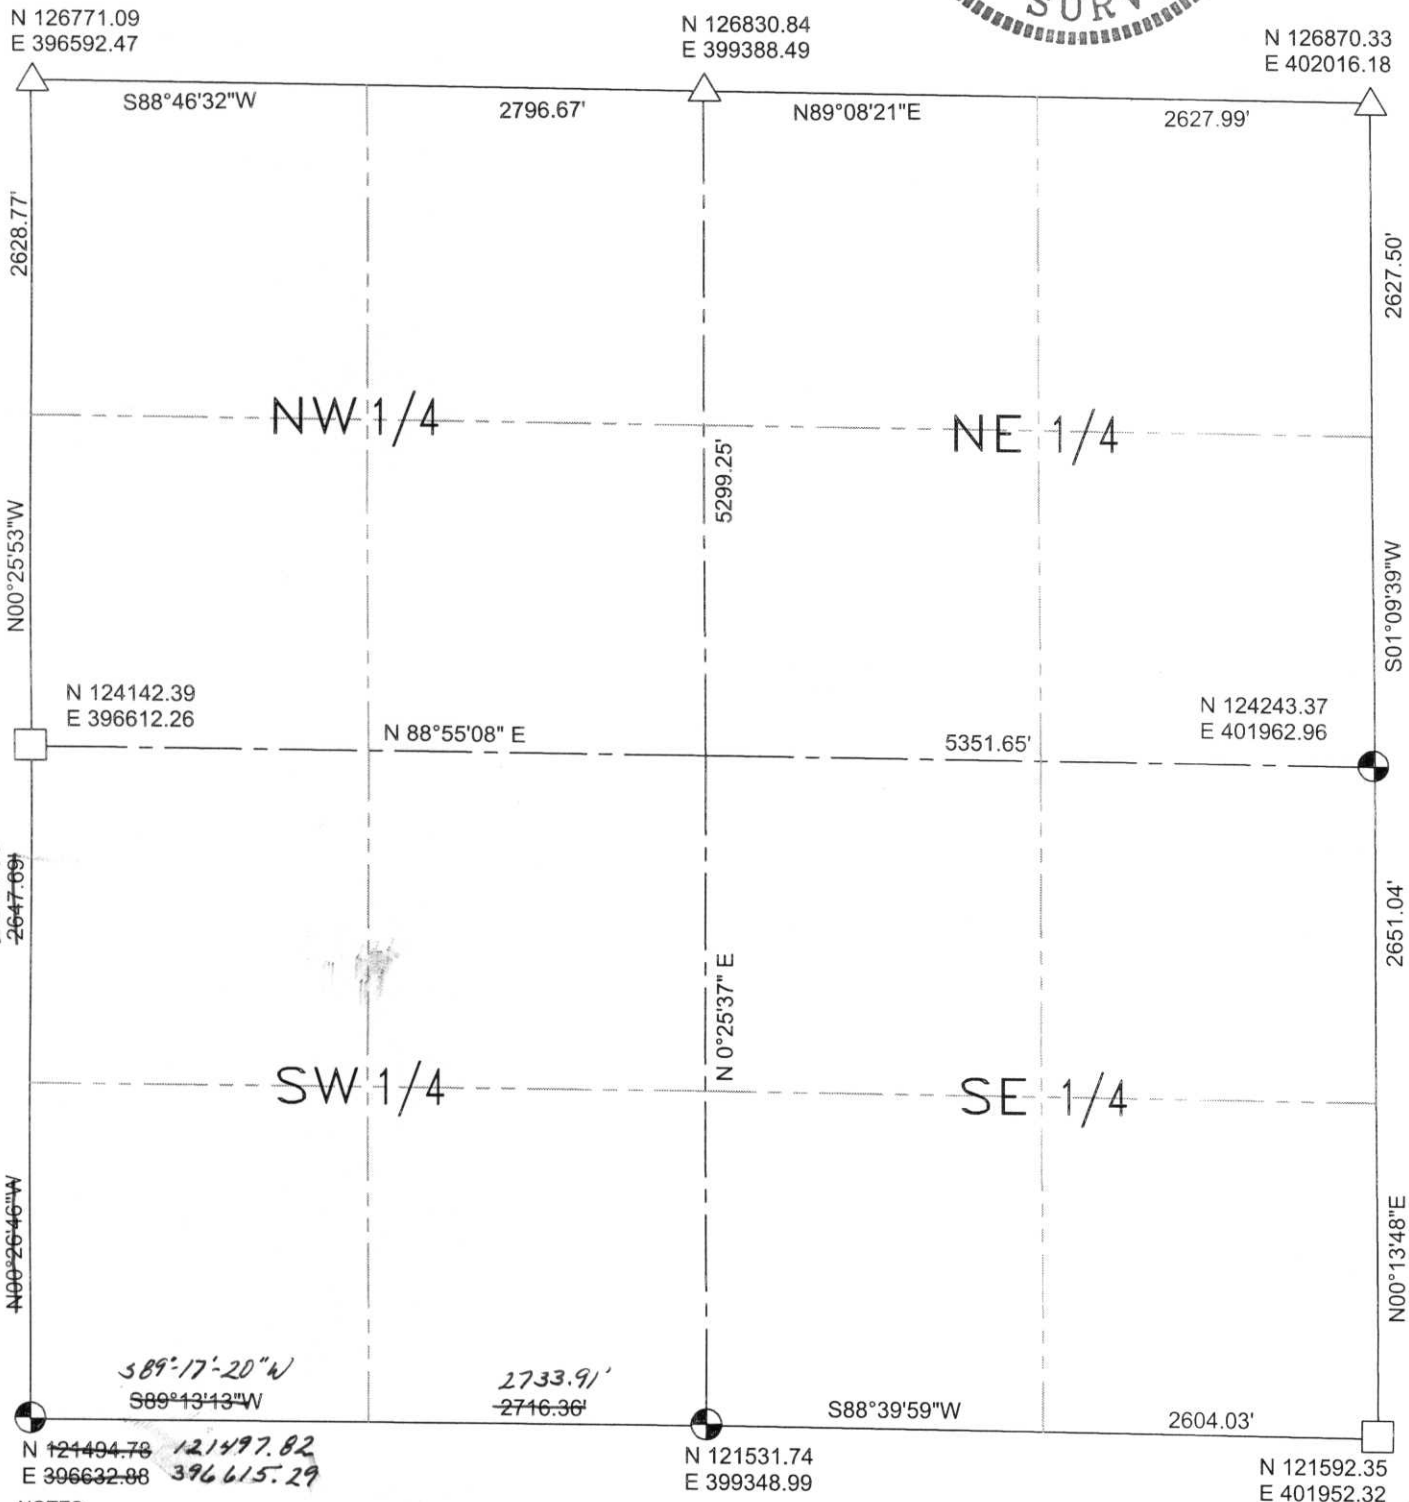


SECTION SUMMARY

7 - 31N - 7E
 Section Township Range
 CITY OF MERRILL
 Town

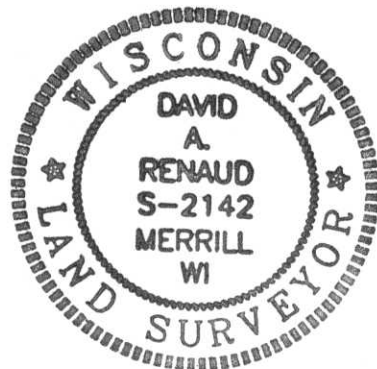

Revised 12/13/01 ARD

NOTES:

COORDINATES AND BEARINGS ARE REFERENCED TO THE LINCOLN COUNTY COORDINATE SYSTEM AS DEVELOPED BY THE WISCONSIN DEPARTMENT OF TRANSPORTATION AND WERE DETERMINED BY GPS OBSERVATIONS ON CONTROL POINTS AS SUPPLIED BY THE WDOT.

LEGEND

- ⊕ -BERNSTEN ALUMINUM Monument
- -BERNSTEN SURVEY NAIL
- -1" Iron Pipe
- -Iron Bar
- △ -FOUND P.K. NAIL

RECEIVED AT LINCOLN COUNTY
 COURTHOUSE THIS 25TH DAY
 OF June 20 01
 Tony Walker
 LAND INFORMATION OFFICE

CERTIFIED CORRECT:

David A. Renaud
 RLS S-2142

DATE: 6/18/01 Registered Land Surveyor

E.I.-15