



LINCOLN CO

SECTION
SUMMARY

12
Sect

Township


Sec 12-31-7

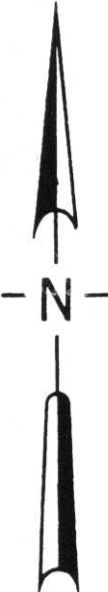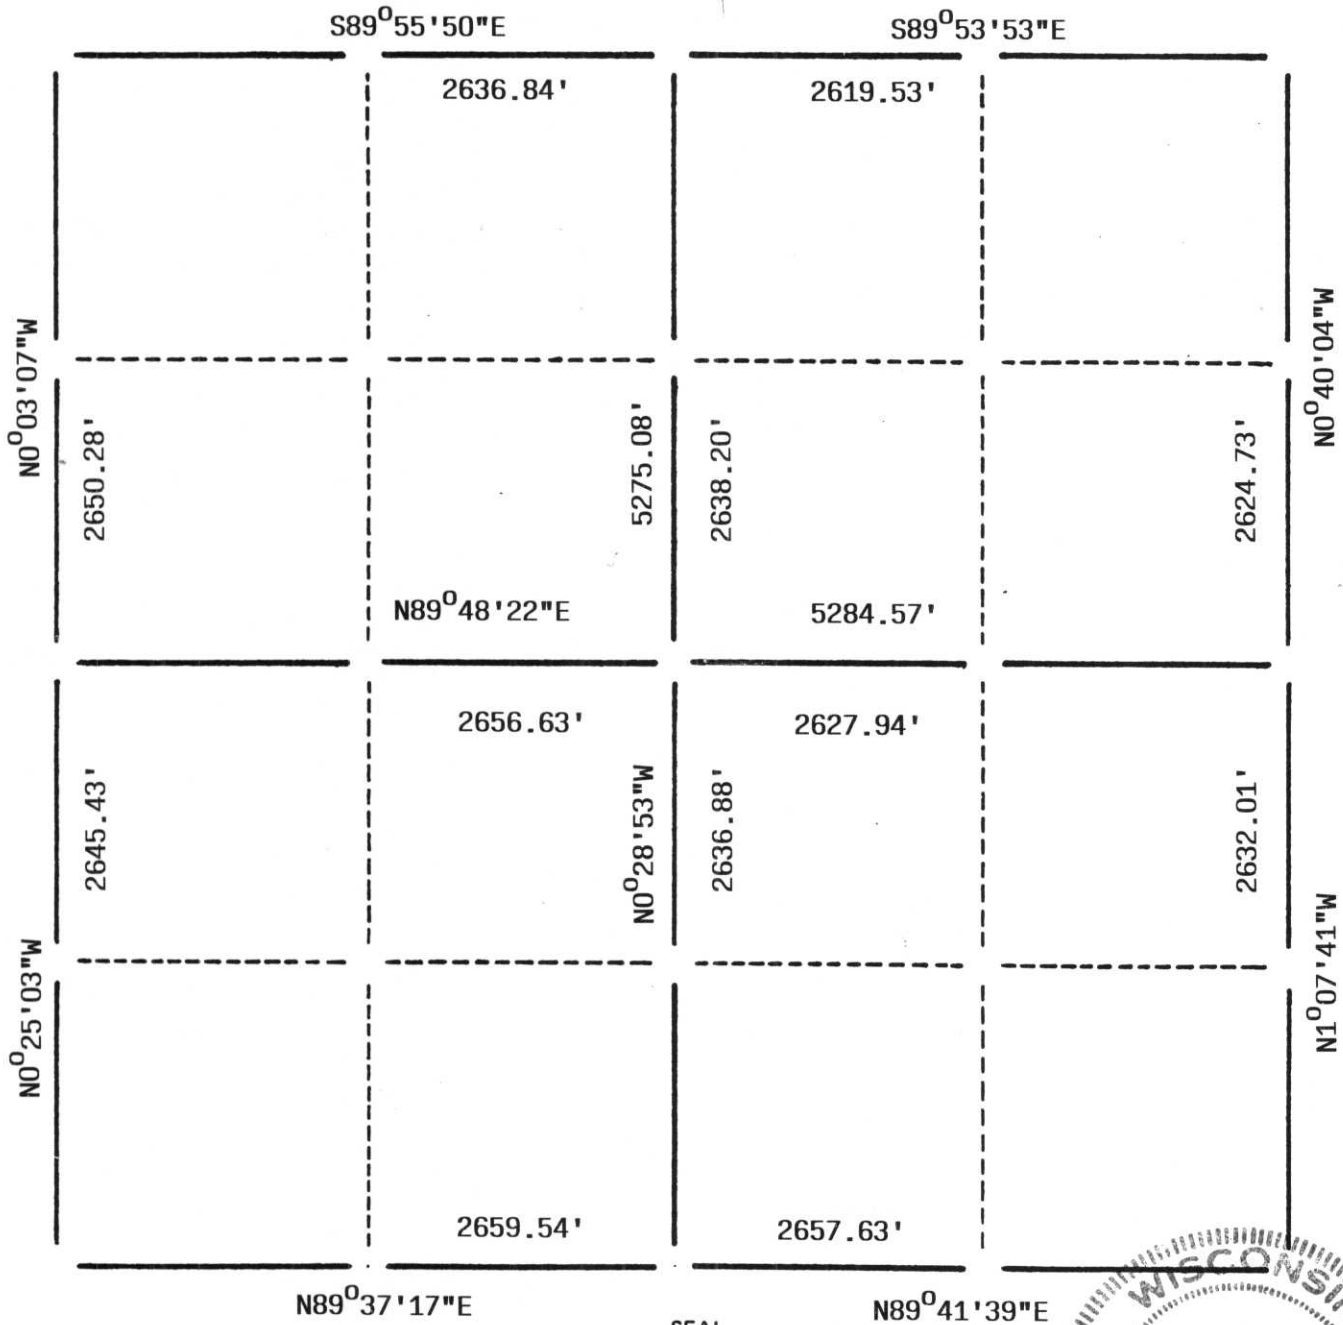

LEGEND

- ⊕ - Harrison Cast Iron Monument
- - Stone or Concrete Monument
- - 2" Iron Pipe
- - 1" Iron Pipe
- - Iron Bar
- - Other

SEAL

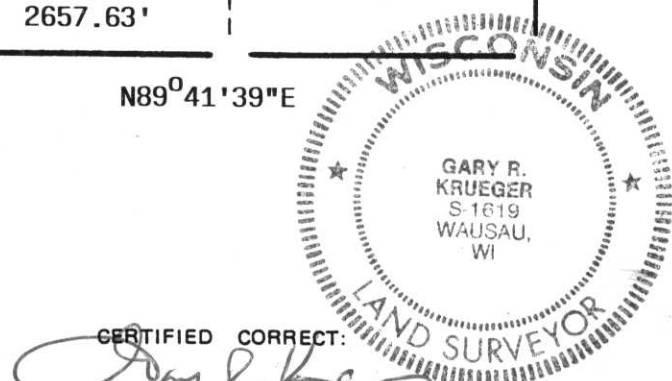

CERTIFIED CORRECT:

Gary R. Krueger

Gary R. Krueger RLS NO. 1619

Registered Land Surveyor

DATE: 12-19-96

EL-11-25