


LINCOLN COUNTY



16 - 31 - 7
Section Town Range

PINE RIVER
Township

SECTION SUMMARY

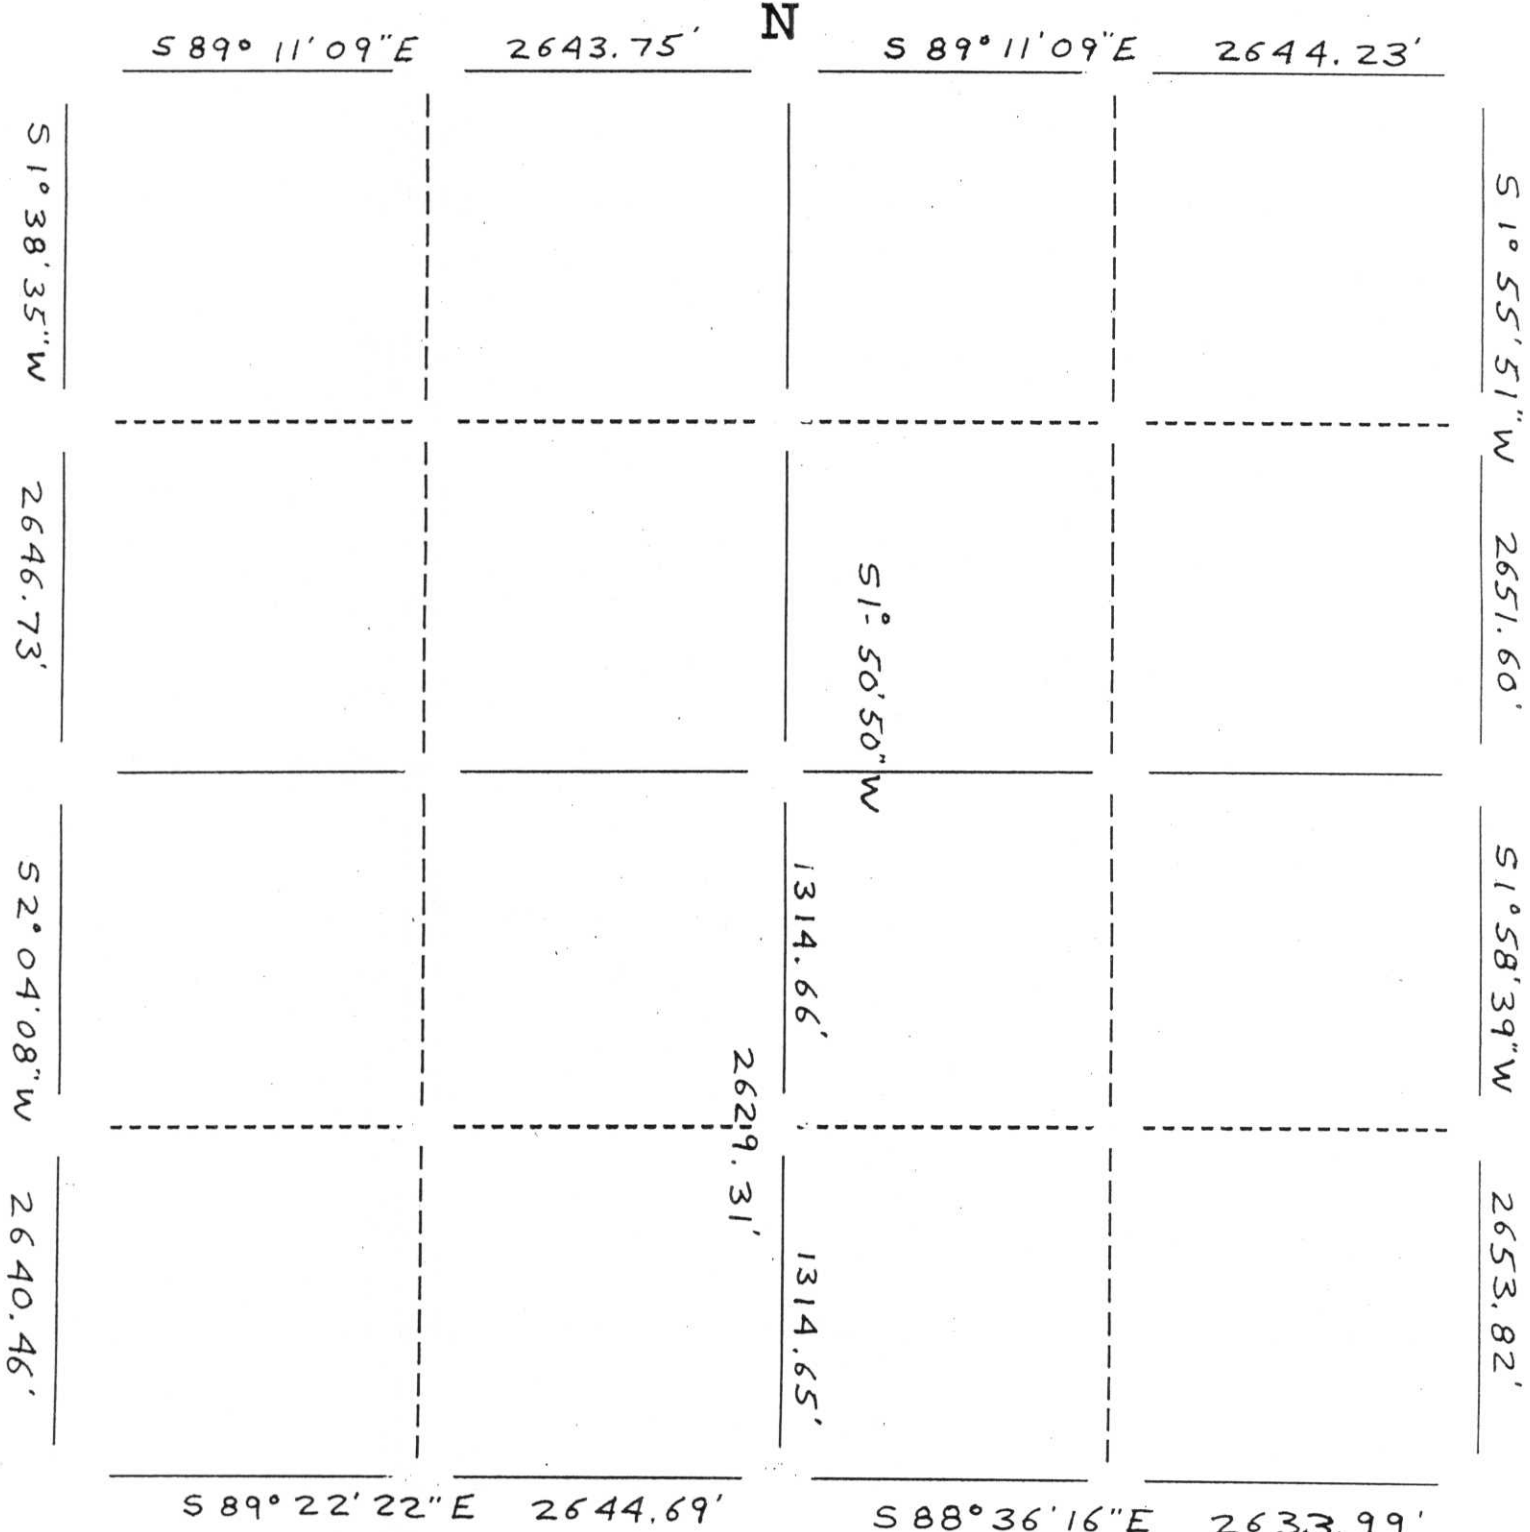

LEGEND

- Berntsen Monument
- 2" Iron Pipe
- Stone or Concrete Monument
- 1" Iron Pipe
- Iron Pipe
- Other

S 88° 36' 16" E 2633.99'
RECEIVED BY LINCOLN COUNTY
SURVEYOR THIS 9TH DAY
OF November 20 05
Tommy Dall
COUNTY SURVEYOR

CERTIFIED CORRECT:
David Holin

Registered Land Surveyor
DATE: 9-28-04

I, M: 9/13