


LINCOLN COUNTY



17 - 31 - 7
Section Town Range

Pine River
Township

SECTION SUMMARY

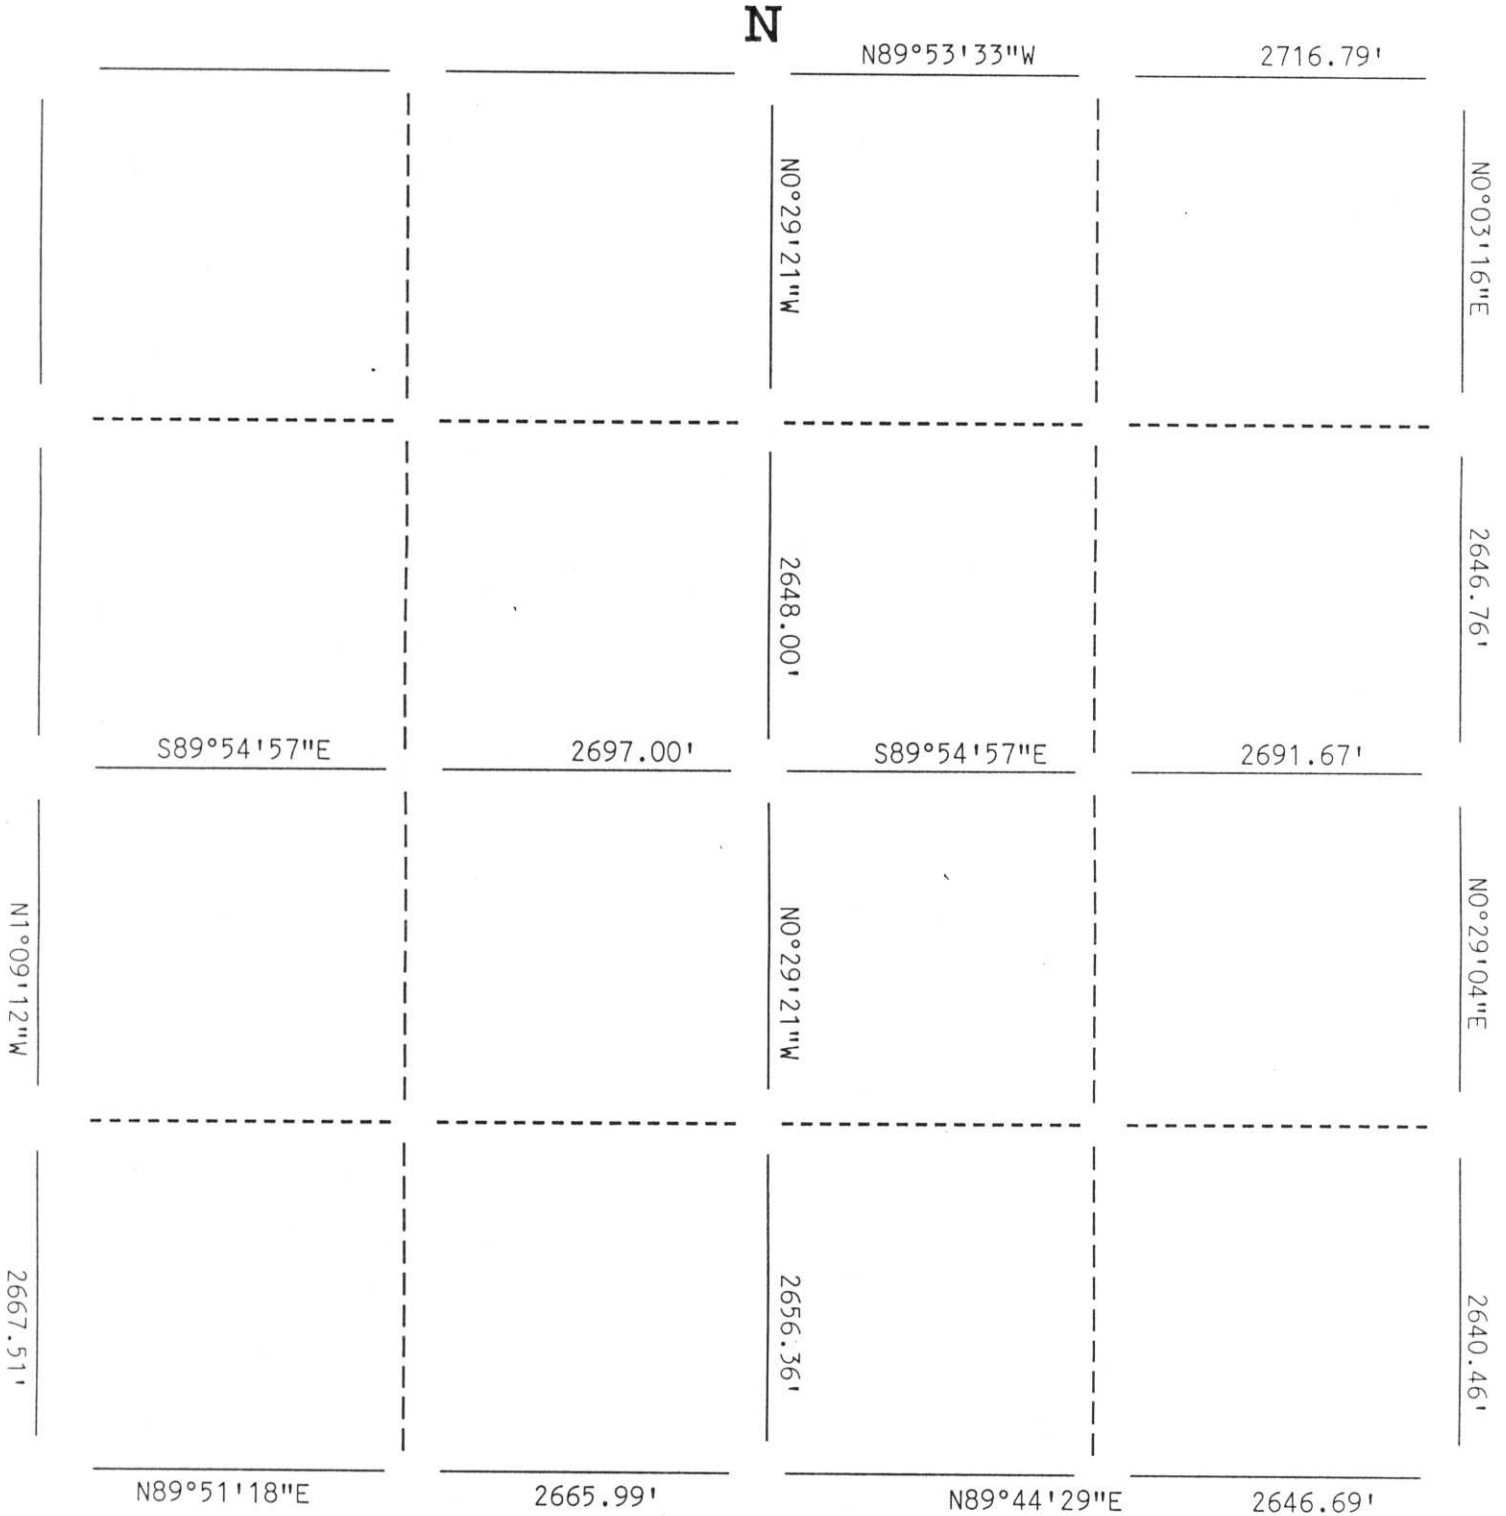

LEGEND

- Berntsen Monument
- 2" Iron Pipe
- Stone or Concrete Monument
- 1" Iron Pipe
- Iron Pipe
- Other




RECEIVED BY LINCOLN COUNTY SURVEYOR THIS 9TH DAY OF November 2005
Tony Doh
COUNTY SURVEYOR

CERTIFIED CORRECT:
David J. Goslin
Registered Land Surveyor


DATE: 1-12-01

I.M.: 5,9

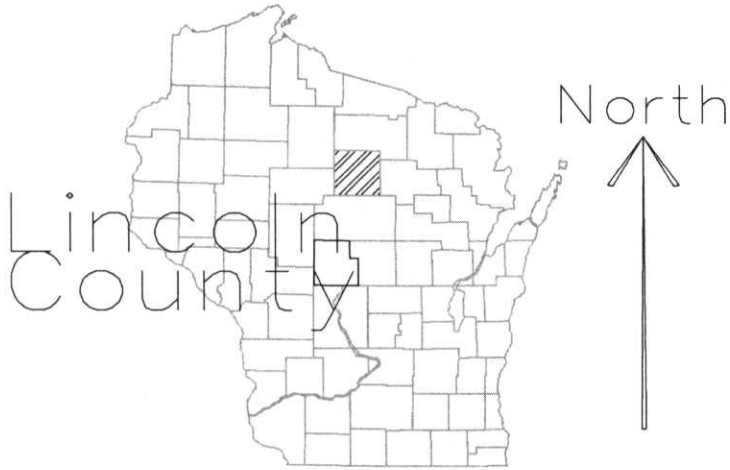


SECTION SUMMARY

17 - T31N - R7E
Section Township Range
Pine River
Town

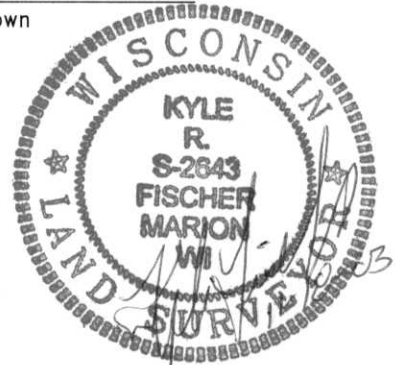

CALCULATED POSITION FROM
TIES AS SHOWN ON LAND SURVEY
MONUMENT RECORD SHEET

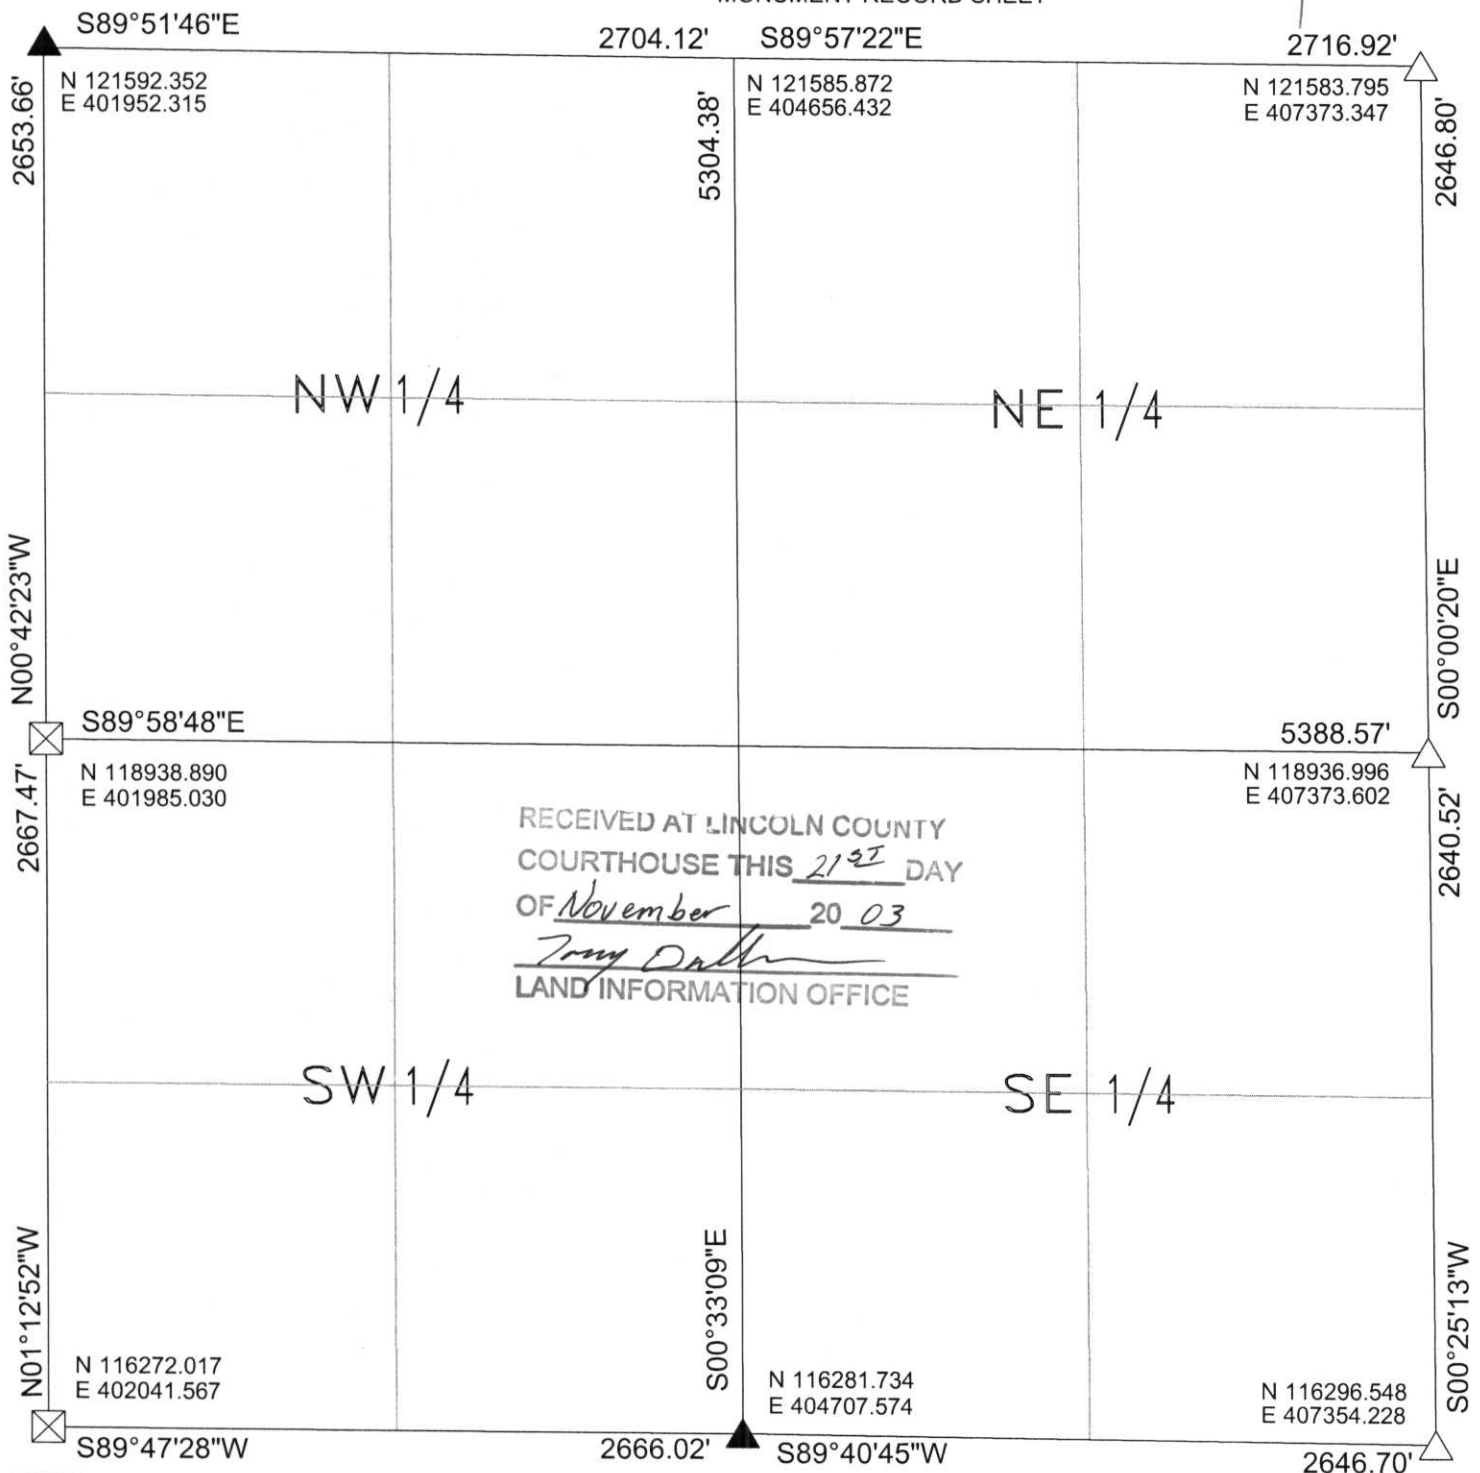

RECEIVED AT LINCOLN COUNTY
COURTHOUSE THIS 21ST DAY
OF November 20 03
Troy Dalko
LAND INFORMATION OFFICE

NOTES:
1.) COORDINATES & BEARINGS BASED ON LINCOLN COUNTY COORDINATE SYSTEM AS MONUMENTED BY LINCOLN COUNTY

LEGEND

- ⊗ -6"X6" Stone Found
- △ -Found PK Nail
- ▲ -Found Survey Marking Pin

CERTIFIED CORRECT:
Kyle R. Fischer

Kyle R. Fischer
Registered Land Surveyor
DATE: 11-10-03

I m - 59