


LINCOLN COUNTY



19 - 31 - 7
Section Town Range

SCOTT
Township

SECTION SUMMARY

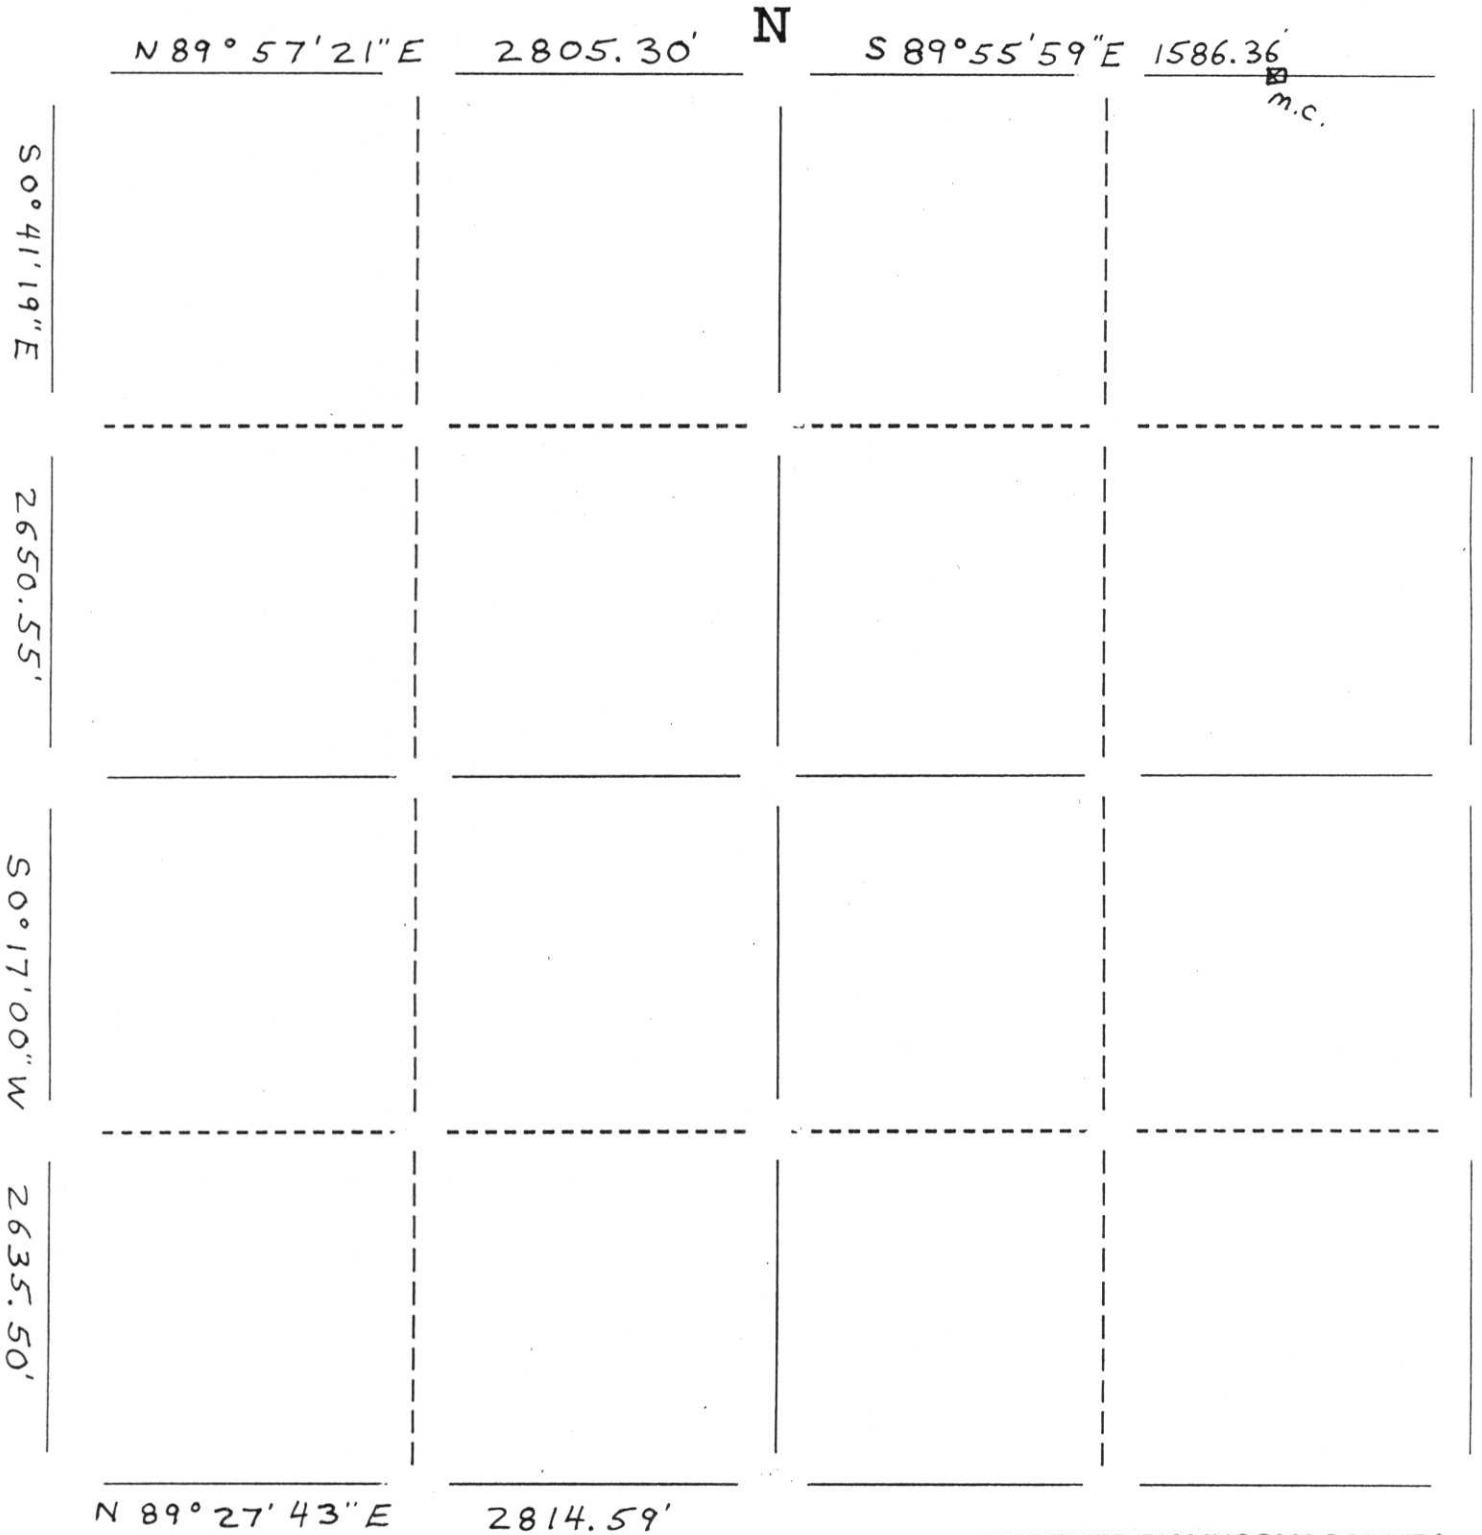

LEGEND


- Berntsen Monument
- 2" Iron Pipe
- Stone or Concrete Monument
- 1" Iron Pipe
- Iron Pipe
- Other



RECEIVED BY LINCOLN COUNTY
SURVEYOR THIS 9TH DAY
OF November 20 05
Tony Dahn
COUNTY SURVEYOR

CERTIFIED CORRECT:
David J. Goslin
Registered Land Surveyor
DATE: 10-27-99



M.O.: 15

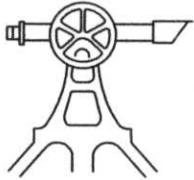

Lincoln County

SECTION SUMMARY

19	31N	7E
Section	Township	Range
PINE RIVER		
Town		

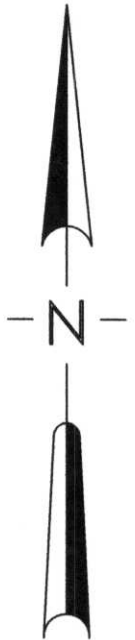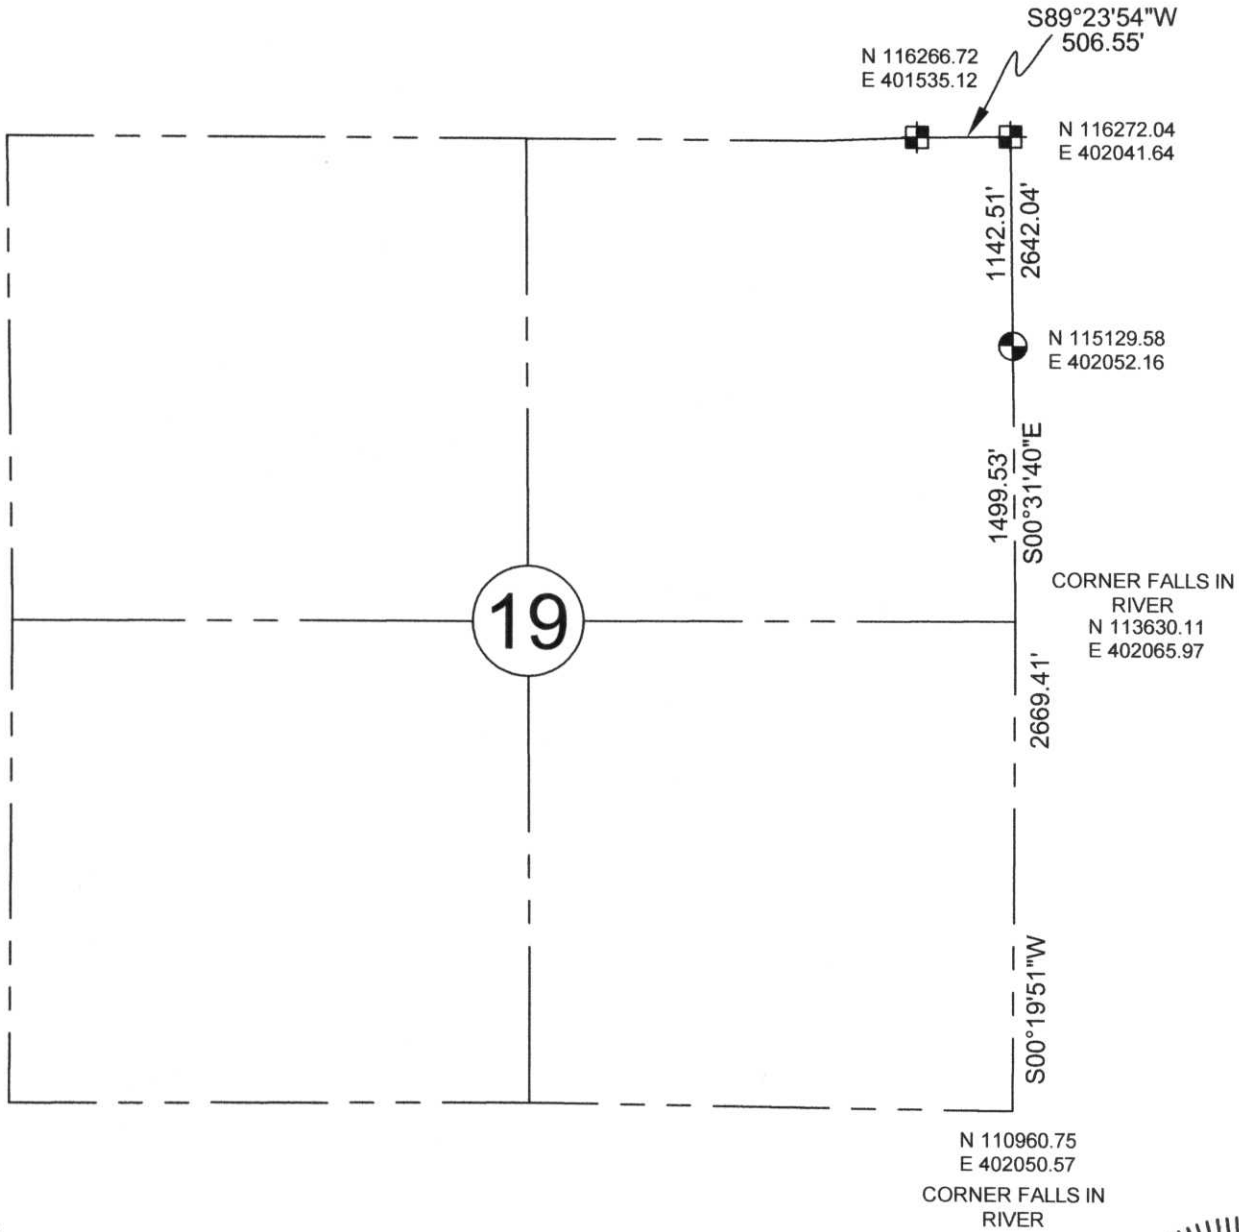

NOTE:
BEARINGS AND COORDINATES ARE BASED ON THE LINCOLN COUNTY COORDINATE SYSTEM AND REFERENCED TO THE PINE RIVER AND PINE DELLS GPS STATIONS.

LEGEND

- BERNSTEN MONUMENT
- SET MAG NAIL
- FOUND GRANITE STONE
- SURVEY MARKING PIN

SEAL

RECEIVED BY LINCOLN COUNTY
SURVEYOR THIS 6TH DAY
OF January 20 06
Tom Dally
COUNTY SURVEYOR



CERTIFIED CORRECT:

Keith J. Walkowski
KEITH J. WALKOWSKI
Registered Land Surveyor
DATE: Jan 6TH, 2006

M.O.: 1.5