


LINCOLN COUNTY



24 - 31 - 7
Section Town Range

PINE RIVER
Township

SECTION SUMMARY

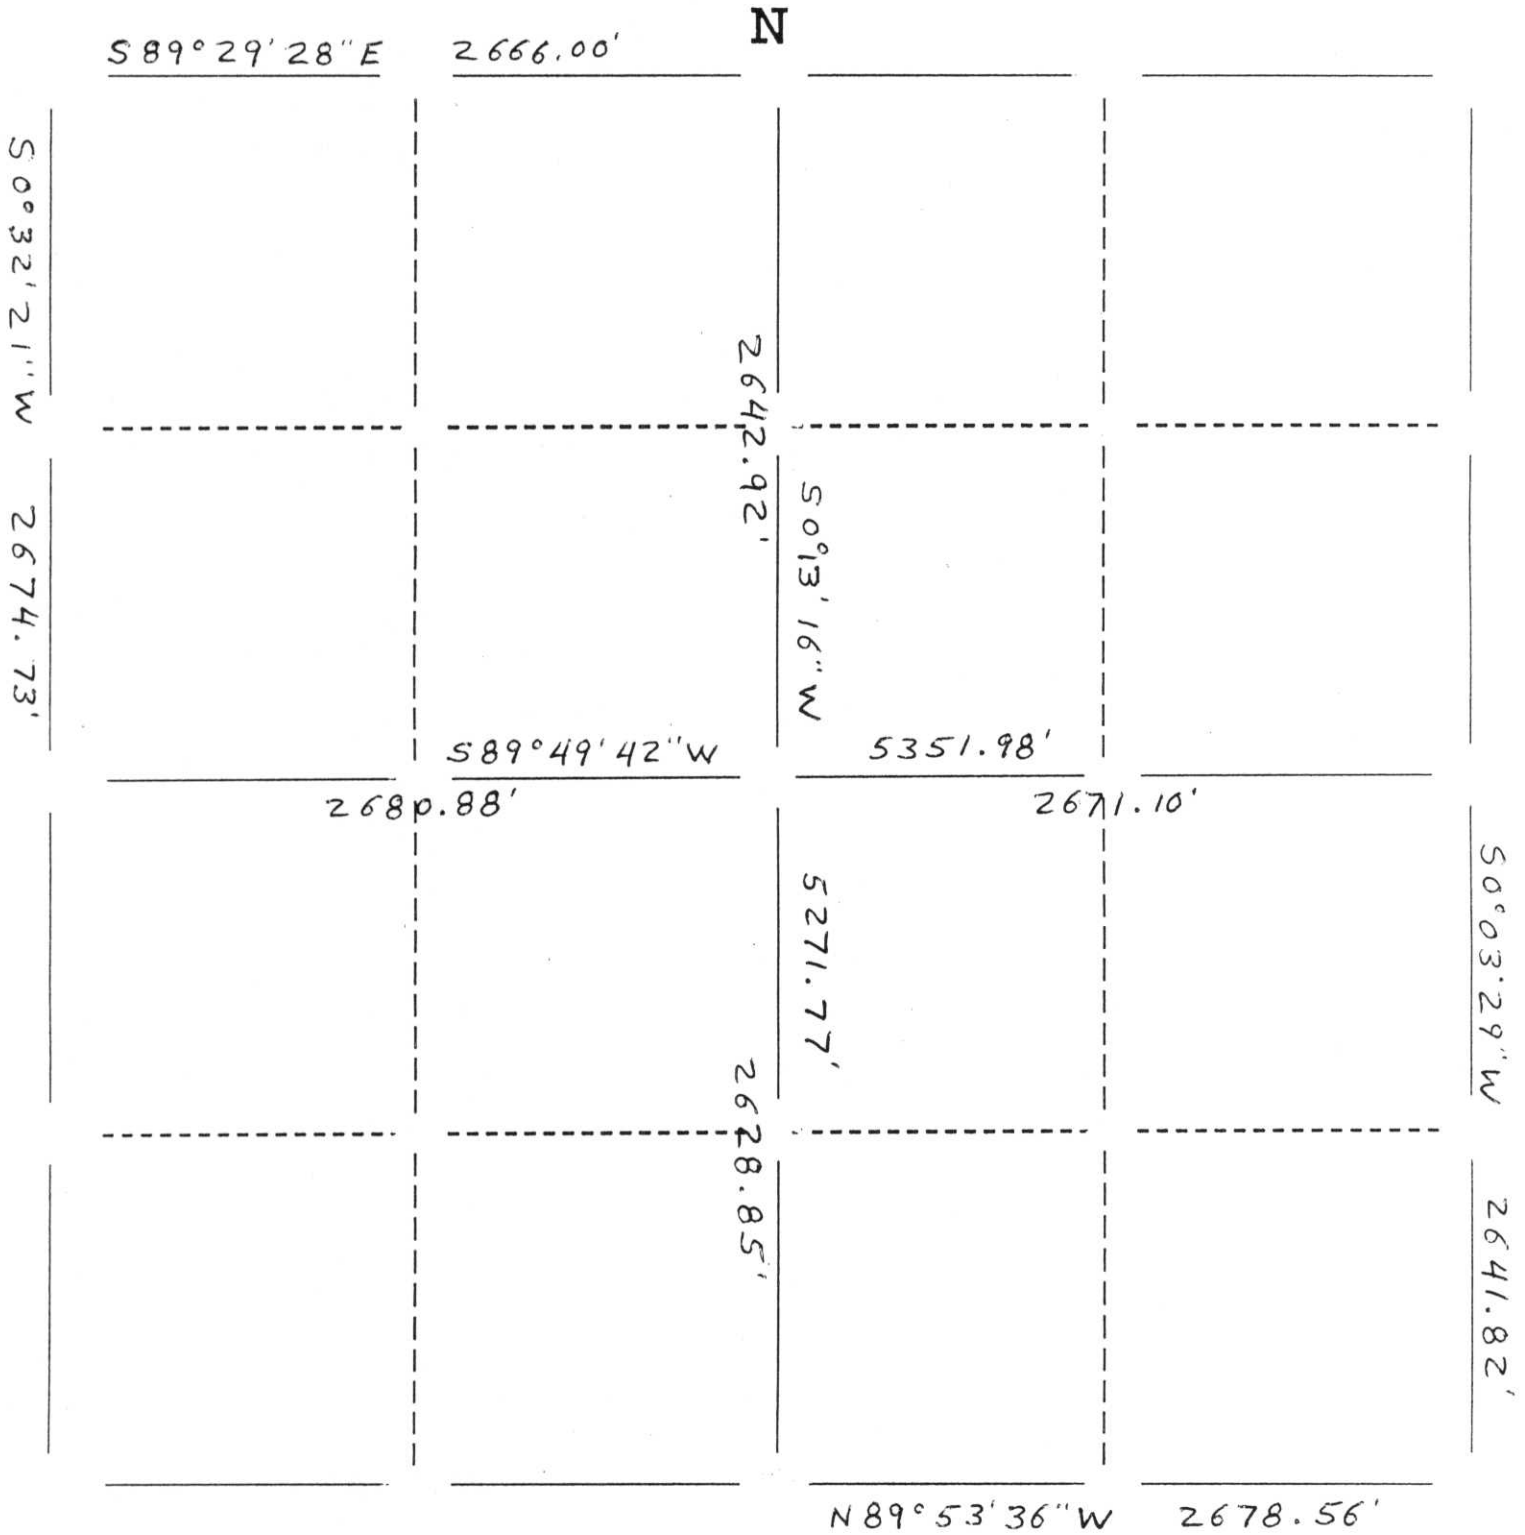

LEGEND

- Berntsen Monument
- 2" Iron Pipe
- Stone or Concrete Monument
- 1" Iron Pipe
- Iron Pipe
- Other



RECEIVED BY LINCOLN COUNTY SURVEYOR THIS 9TH DAY OF November 20 05
Tony Dath
COUNTY SURVEYOR

CERTIFIED CORRECT: David Dohlin

DATE: 10-02 Registered Land Surveyor

M.O.: 21, 25