
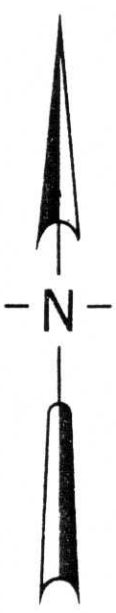


marathon
county
surveyor

SECTION
SUMMARY


25 - 31 - 7
Section - Town - Range
PINE RIVER/LINCOLN CO.
Township

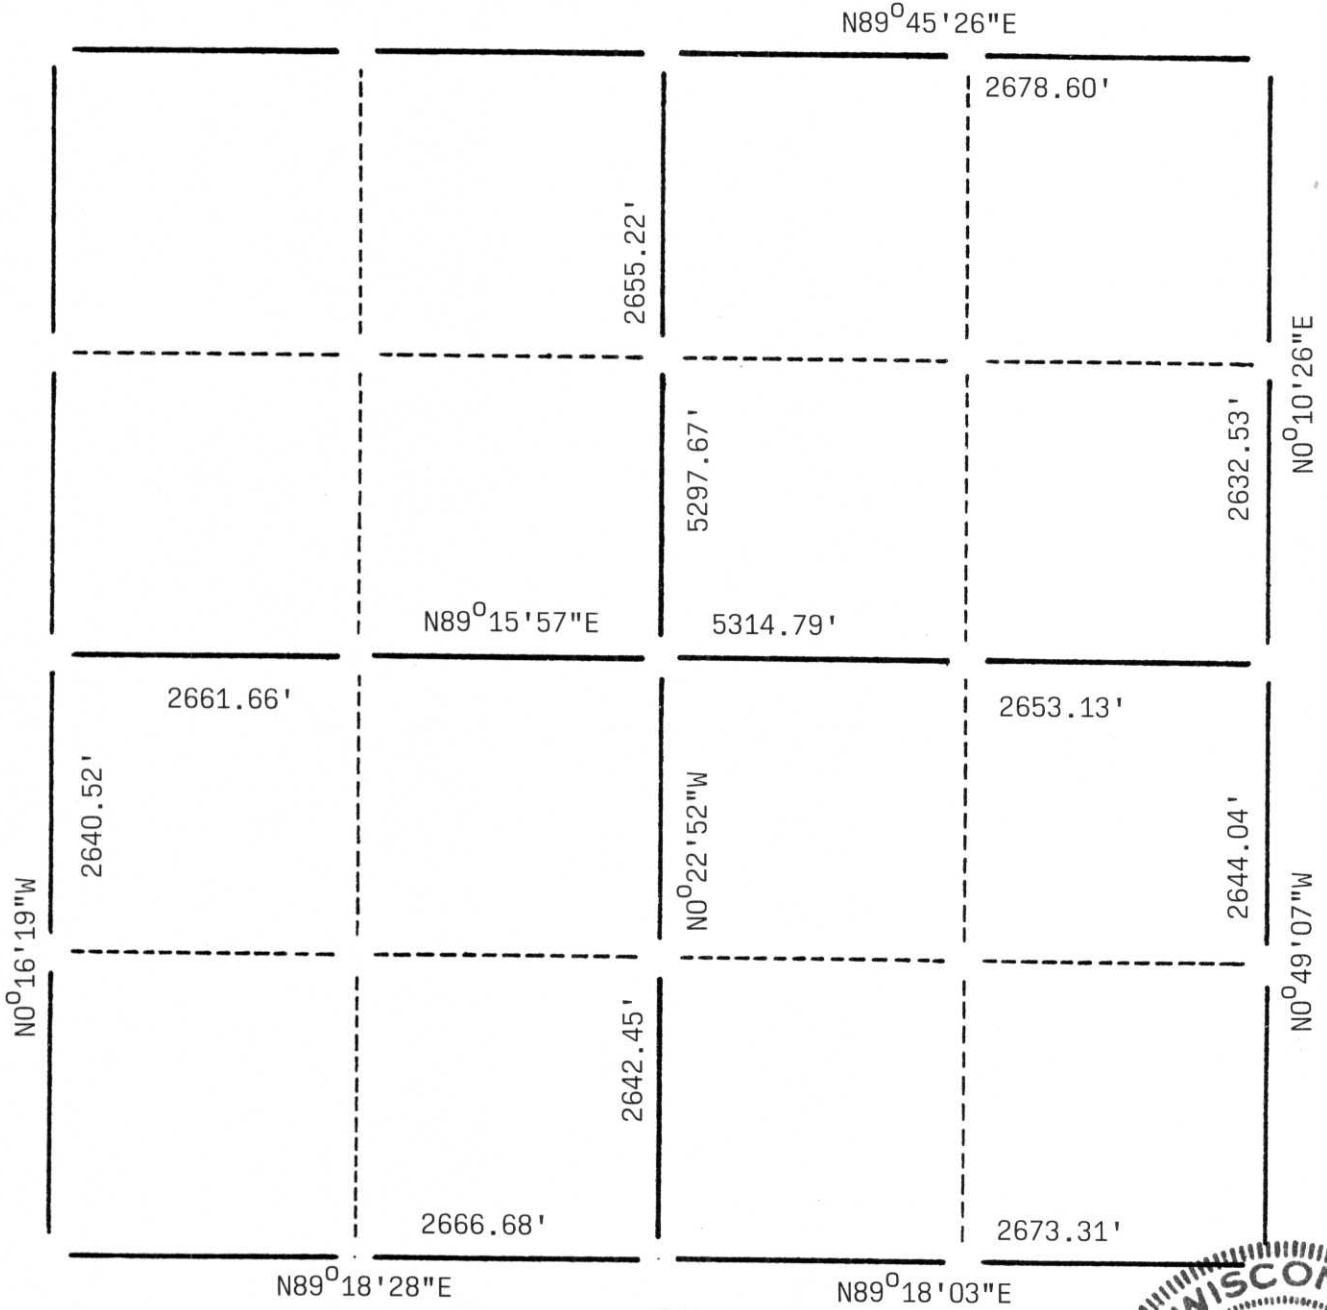

LEGEND

- Harrison Cast Iron Monument
- Stone or Concrete Monument
- 2" Iron Pipe
- 1" Iron Pipe
- Iron Bar
- Other

SEAL

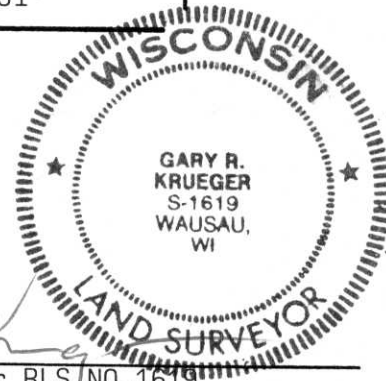

CERTIFIED CORRECT:
Gary R. Krueger
Gary R. Krueger RLS/NO.1619
Registered Land Surveyor
DATE: 8-20-95

QU-21,25