


Lincoln County

SECTION SUMMARY

5	31N	8E
Section	Township	Range
PINE RIVER		
Town		

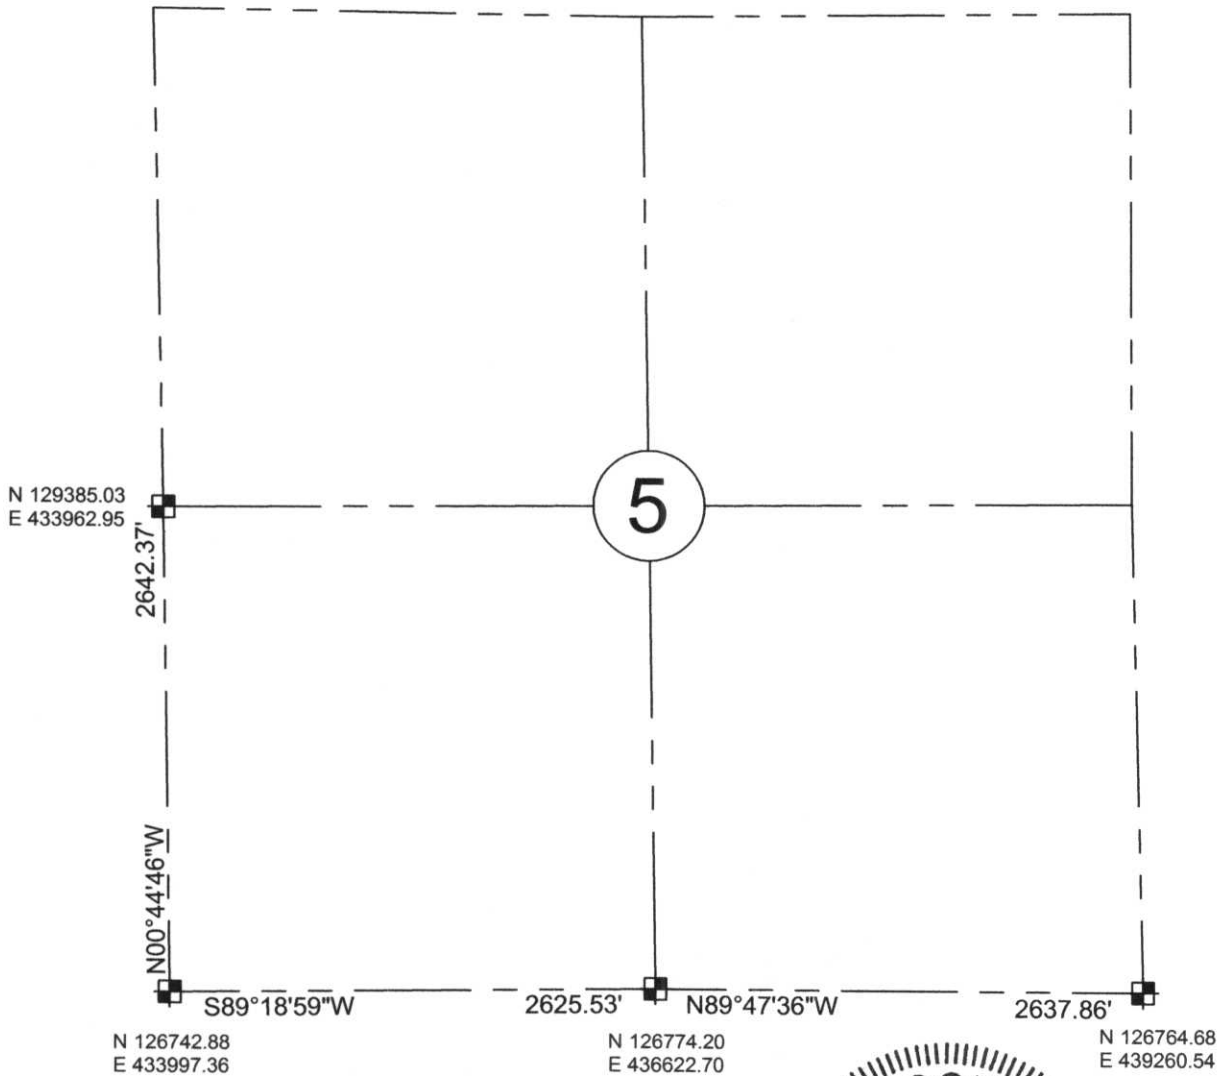

NOTE:
BEARINGS AND COORDINATES ARE BASED ON THE LINCOLN COUNTY COORDINATE SYSTEM AND REFERENCED TO THE PINE RIVER AND PINE DELLS GPS STATIONS.



SEAL

RECEIVED BY LINCOLN COUNTY
SURVEYOR THIS 6TH DAY

LEGEND

- ⊕ - BERNSTEIN MONUMENT
- - FOUND MAG NAIL
- ⊠ - FOUND GRANITE STONE
- - SURVEY MARKING PIN

OF January 20, 06
Tom Walker
COUNTY SURVEYOR

CERTIFIED CORRECT:

Keith J. Walkowski
KEITH J. WALKOWSKI
Registered Land Surveyor
DATE: Jan. 4TH, 2006

H.E.59