


Lincoln County

SECTION SUMMARY

| | | |
|------------|----------|-------|
| 8 | 31N | 8E |
| Section | Township | Range |
| PINE RIVER | | |
| Town | | |

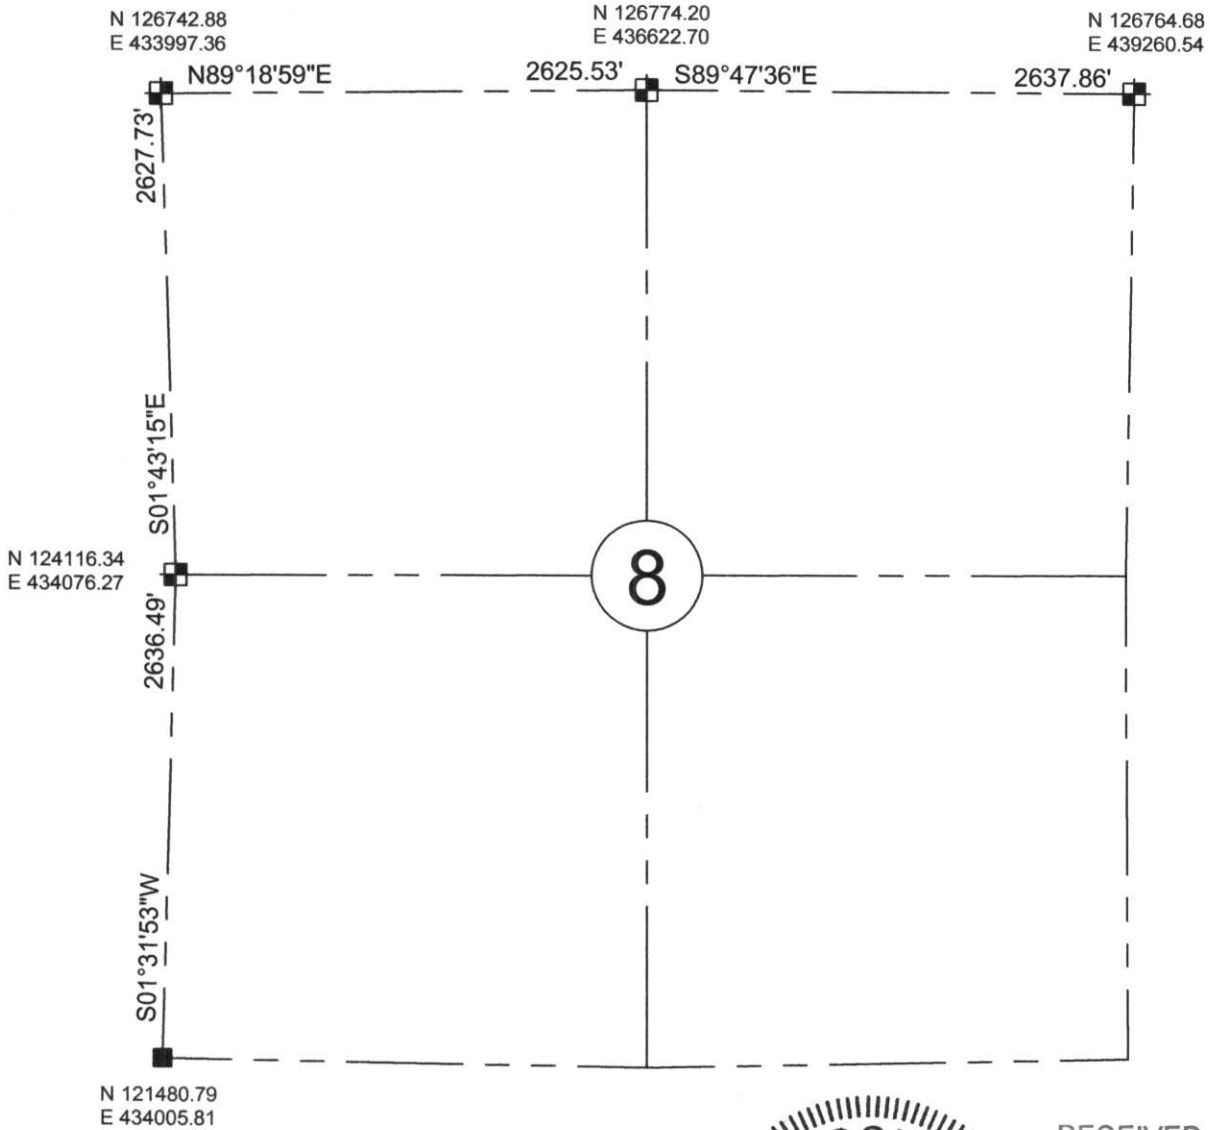

NOTE:
BEARINGS AND COORDINATES ARE BASED ON THE LINCOLN COUNTY COORDINATE SYSTEM AND REFERENCED TO THE PINE RIVER AND PINE DELLS GPS STATIONS.

LEGEND

- BERNSTEN MONUMENT
- FOUND MAG NAIL
- FOUND GRANITE STONE
- SURVEY MARKING PIN

SEAL




RECEIVED BY LINCOLN COUNTY SURVEYOR THIS 6TH DAY OF January 20 06
Tony Walker
COUNTY SURVEYOR

CERTIFIED CORRECT:

Keith J. Walkowski
KEITH J. WALKOWSKI
Registered Land Surveyor
DATE: Jan. 4TH, 2006

FI: 59


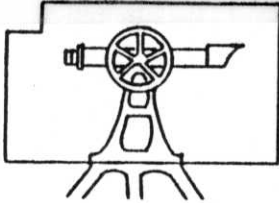


LINCOLN county surveyor

SECTION SUMMARY

8 - 31 - 8
Section Town Range

PINE RIVER (EAST)
Township

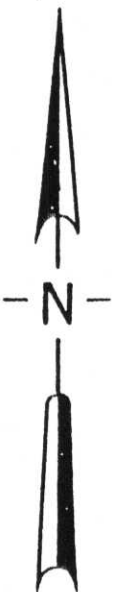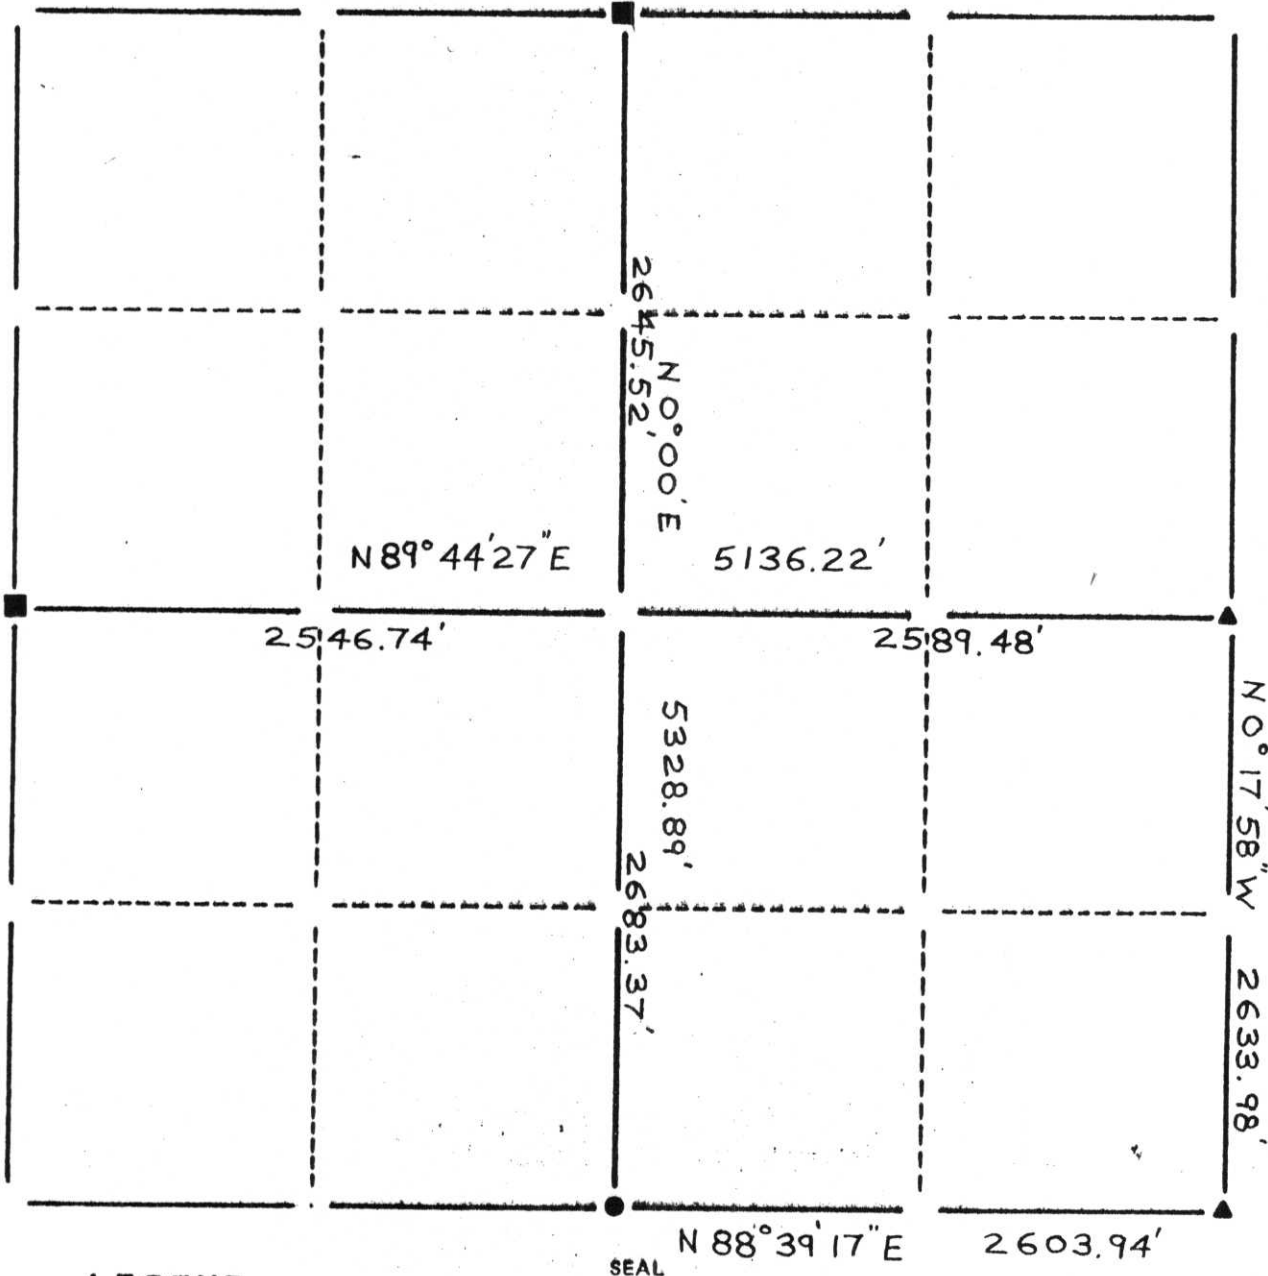

LEGEND

- ⊕ - Harrison Cast Iron Monument
- - Stone or Concrete Monument
- - 2" Iron Pipe
- - 1" Iron Pipe
- - Iron Bar
- ▲ - Other RAILROAD SPIKE

RECEIVED AT LINCOLN COUNTY
COURTHOUSE THIS _____ DAY
OF _____ 19 _____

CERTIFIED CORRECT

Edmund R. Ahendroth

S-798

TAX DESCRIPTION OFFICE

Registered Land Surveyor
DATE: 9-27-95

E-I: 5,9