


Lincoln County

SECTION SUMMARY

11	31N	8E
Section	Township	Range
PINE RIVER		
Town		

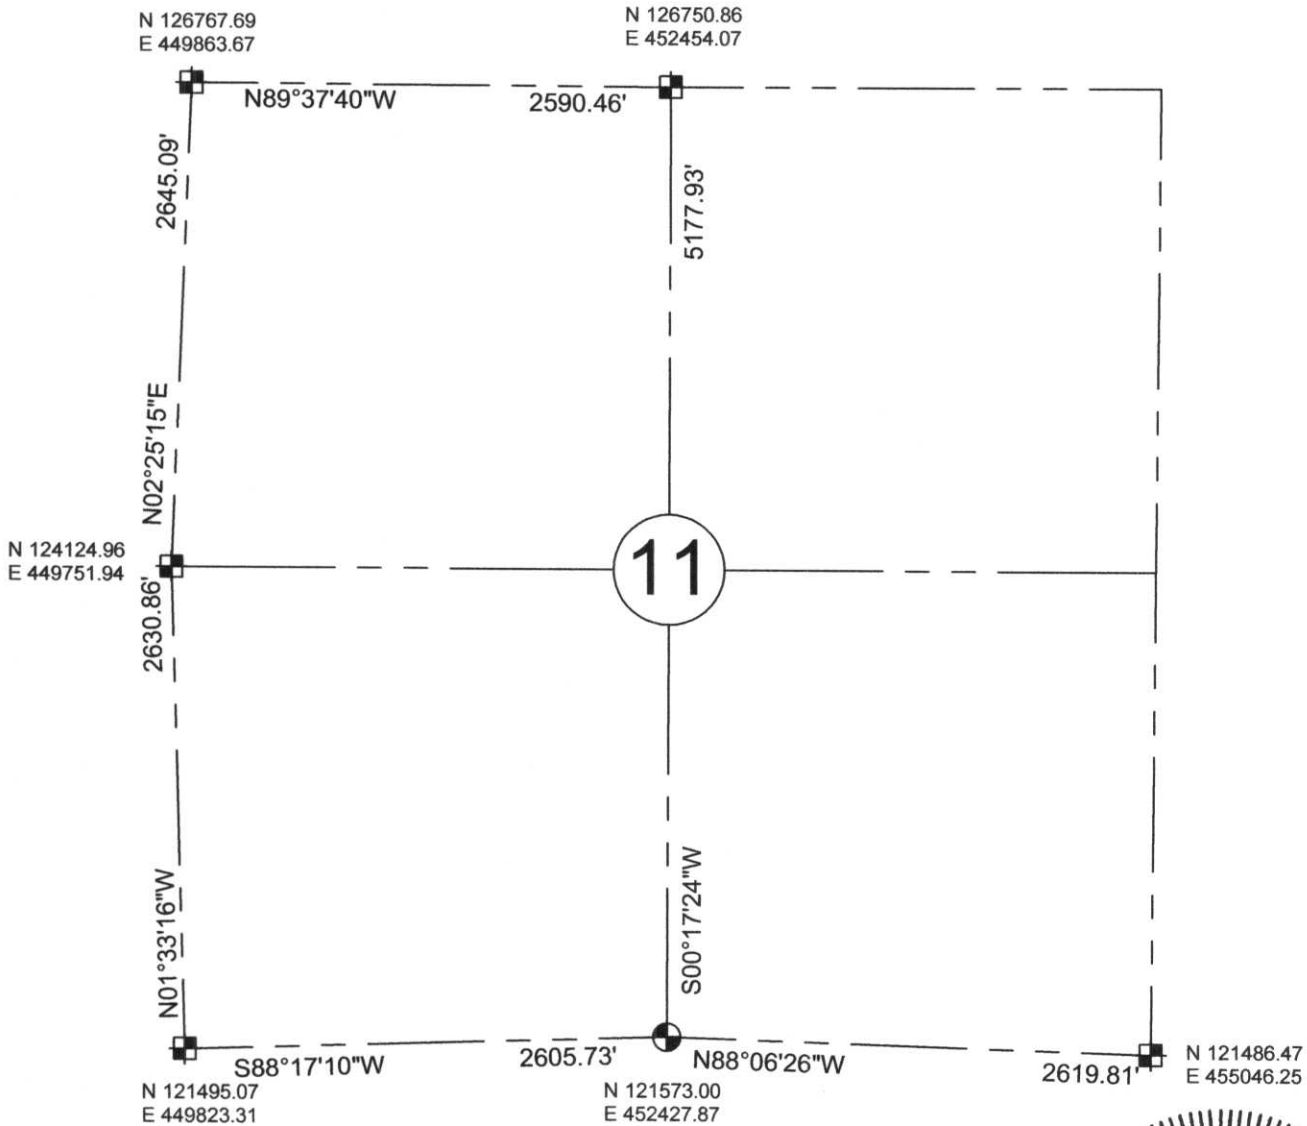

NOTE:
BEARINGS AND COORDINATES ARE BASED ON THE LINCOLN COUNTY COORDINATE SYSTEM AND REFERENCED TO THE PINE RIVER AND PINE DELLS GPS STATIONS.

LEGEND

- ⊕ - BERNSTEIN MONUMENT
- - FOUND MAG NAIL
- ⊠ - FOUND GRANITE STONE
- - SURVEY MARKING PIN

SEAL

RECEIVED BY LINCOLN COUNTY
SURVEYOR THIS 6TH
OF January 2006
Keith J. Walkowski
COUNTY SURVEYOR



CERTIFIED CORRECT:

Keith J. Walkowski
KEITH J. WALKOWSKI
Registered Land Surveyor
DATE: Jan. 4TH 2006

E.I.: 17.21