


Lincoln County

SECTION SUMMARY

14	31N	8E
Section	Township	Range
PINE RIVER		
Town		

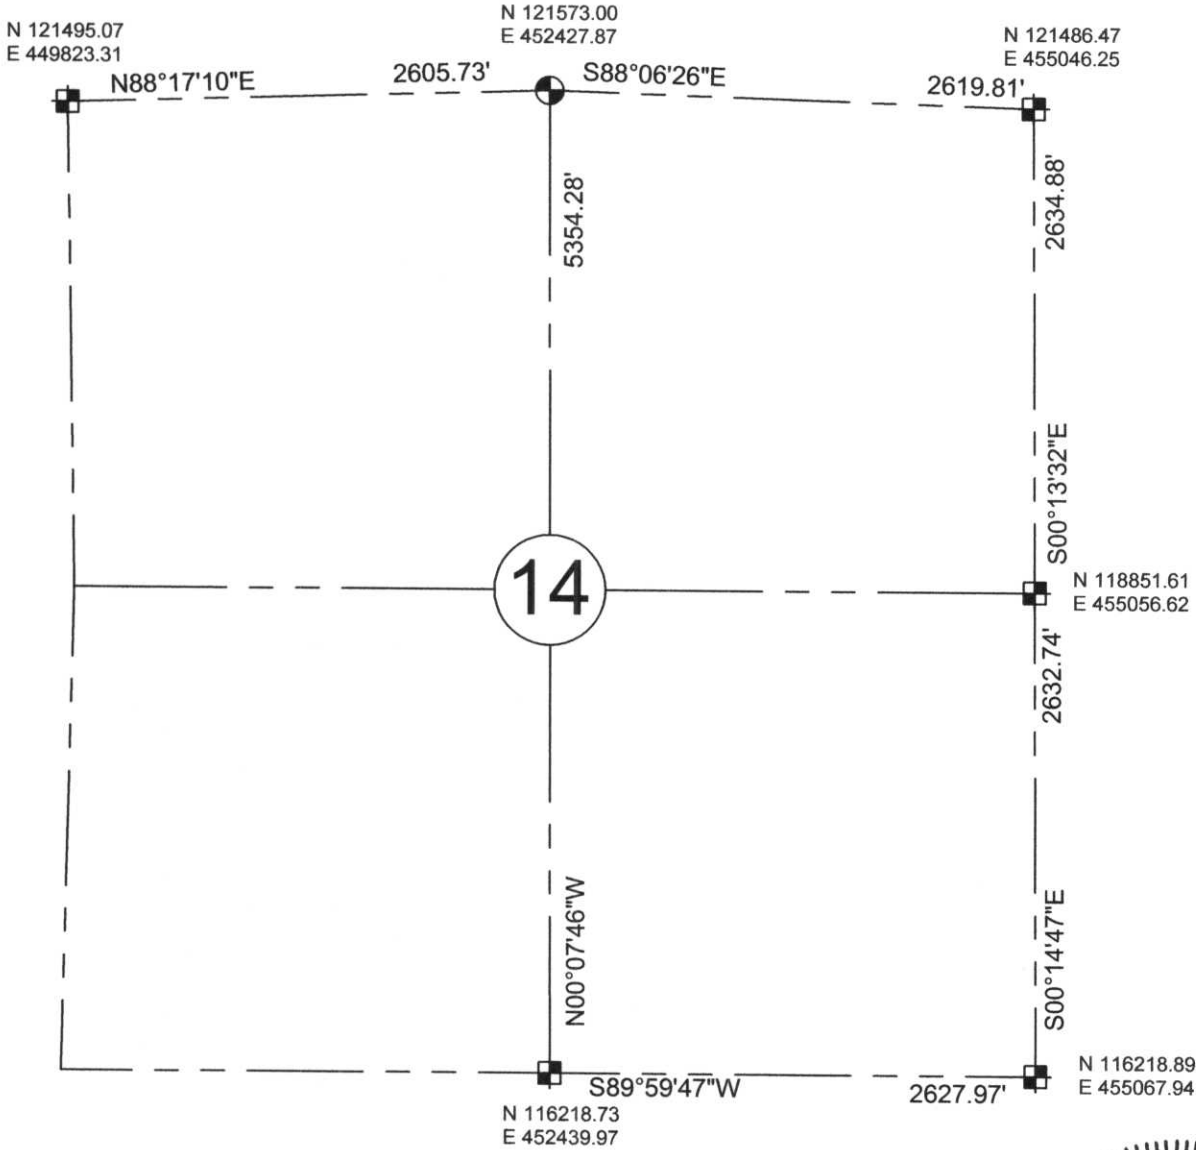

NOTE:
BEARINGS AND COORDINATES ARE BASED ON THE LINCOLN COUNTY COORDINATE SYSTEM AND REFERENCED TO THE PINE RIVER AND PINE DELLS GPS STATIONS.

LEGEND

- BERNSTEN MONUMENT
- FOUND MAG NAIL
- FOUND GRANITE STONE
- SURVEY MARKING PIN

RECEIVED BY LINCOLN COUNTY
SURVEYOR THIS 6TH DAY
OF January 20 06
Tony Dall
COUNTY SURVEYOR



CERTIFIED CORRECT:

Keith J. Walkowski
KEITH J. WALKOWSKI
Registered Land Surveyor
DATE: Jan. 4TH, 2006

I, M: 12, 21