


# Lincoln County

## SECTION SUMMARY

18	31N	8E
Section	Township	Range
PINE RIVER		
Town		

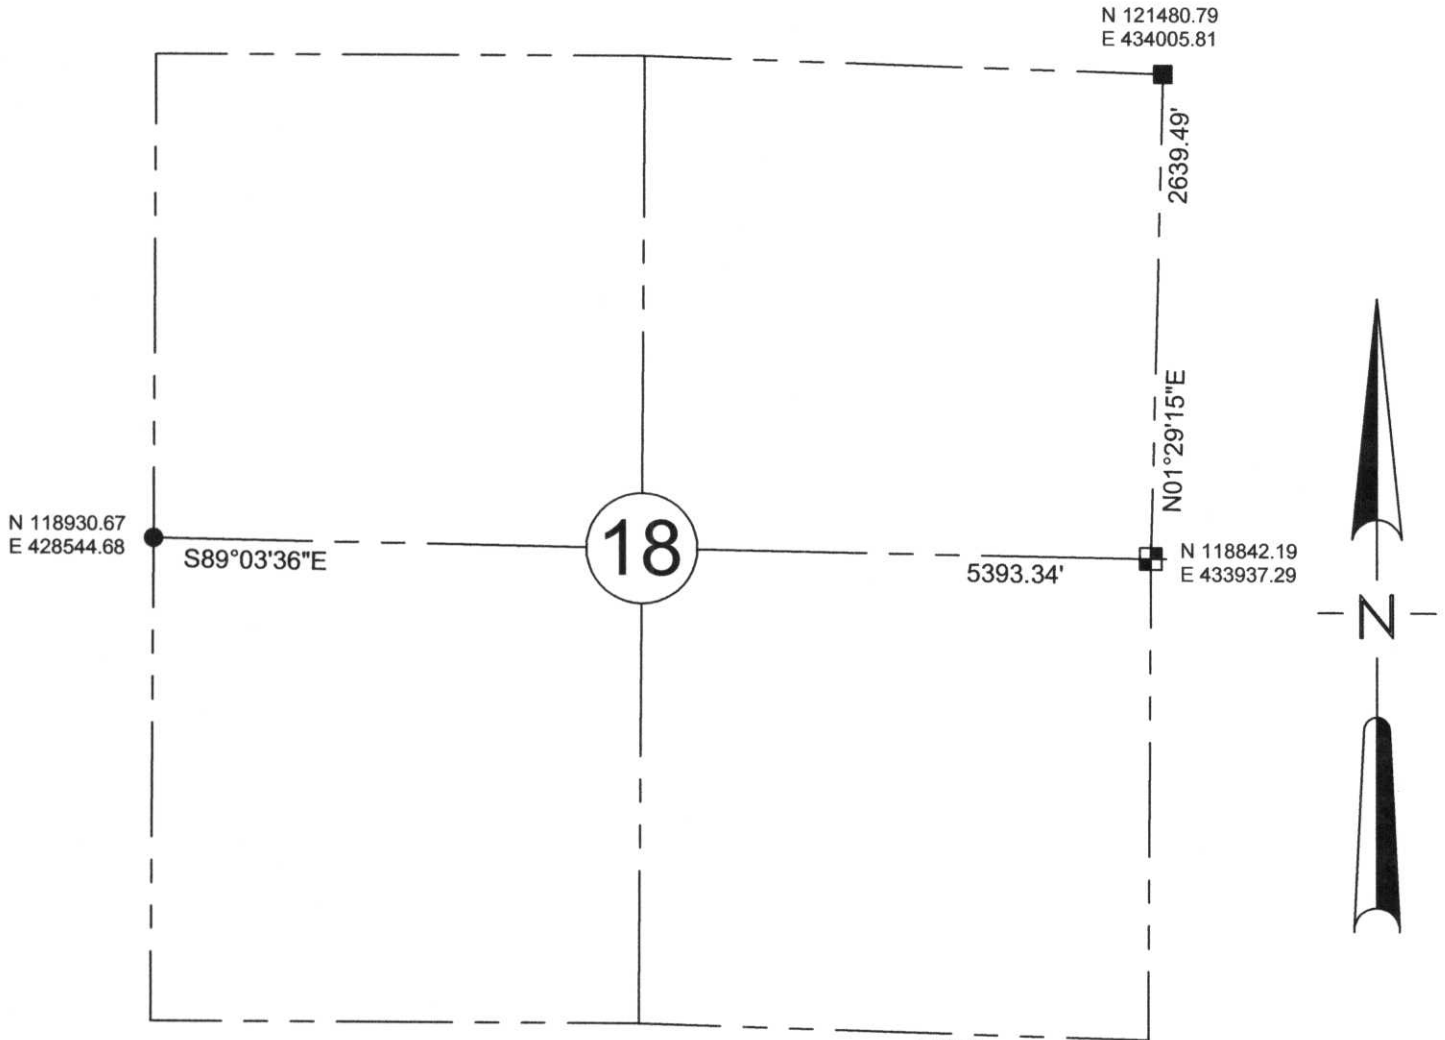

NOTE:  
BEARINGS AND COORDINATES ARE BASED ON THE LINCOLN COUNTY COORDINATE SYSTEM AND REFERENCED TO THE PINE RIVER AND PINE DELLS GPS STATIONS.



SEAL  
RECEIVED BY LINCOLN COUNTY SURVEYOR THIS 6<sup>TH</sup> DAY

### LEGEND

- ⊕ - BERNSTEIN MONUMENT
- - FOUND 1 1/4" BAR
- ⊞ - FOUND GRANITE STONE
- - SURVEY MARKING PIN

OF January 20 06  
Tony Dall  
COUNTY SURVEYOR

CERTIFIED CORRECT:  
Keith J. Walkowski  
KEITH J. WALKOWSKI  
Registered Land Surveyor  
DATE: Jan. 4TH, 2006

I.M.: 1.5