

LINCOLN COUNTY


19 - 31 - 8
Section Town Range

PINE RIVER
Township



SECTION SUMMARY

N

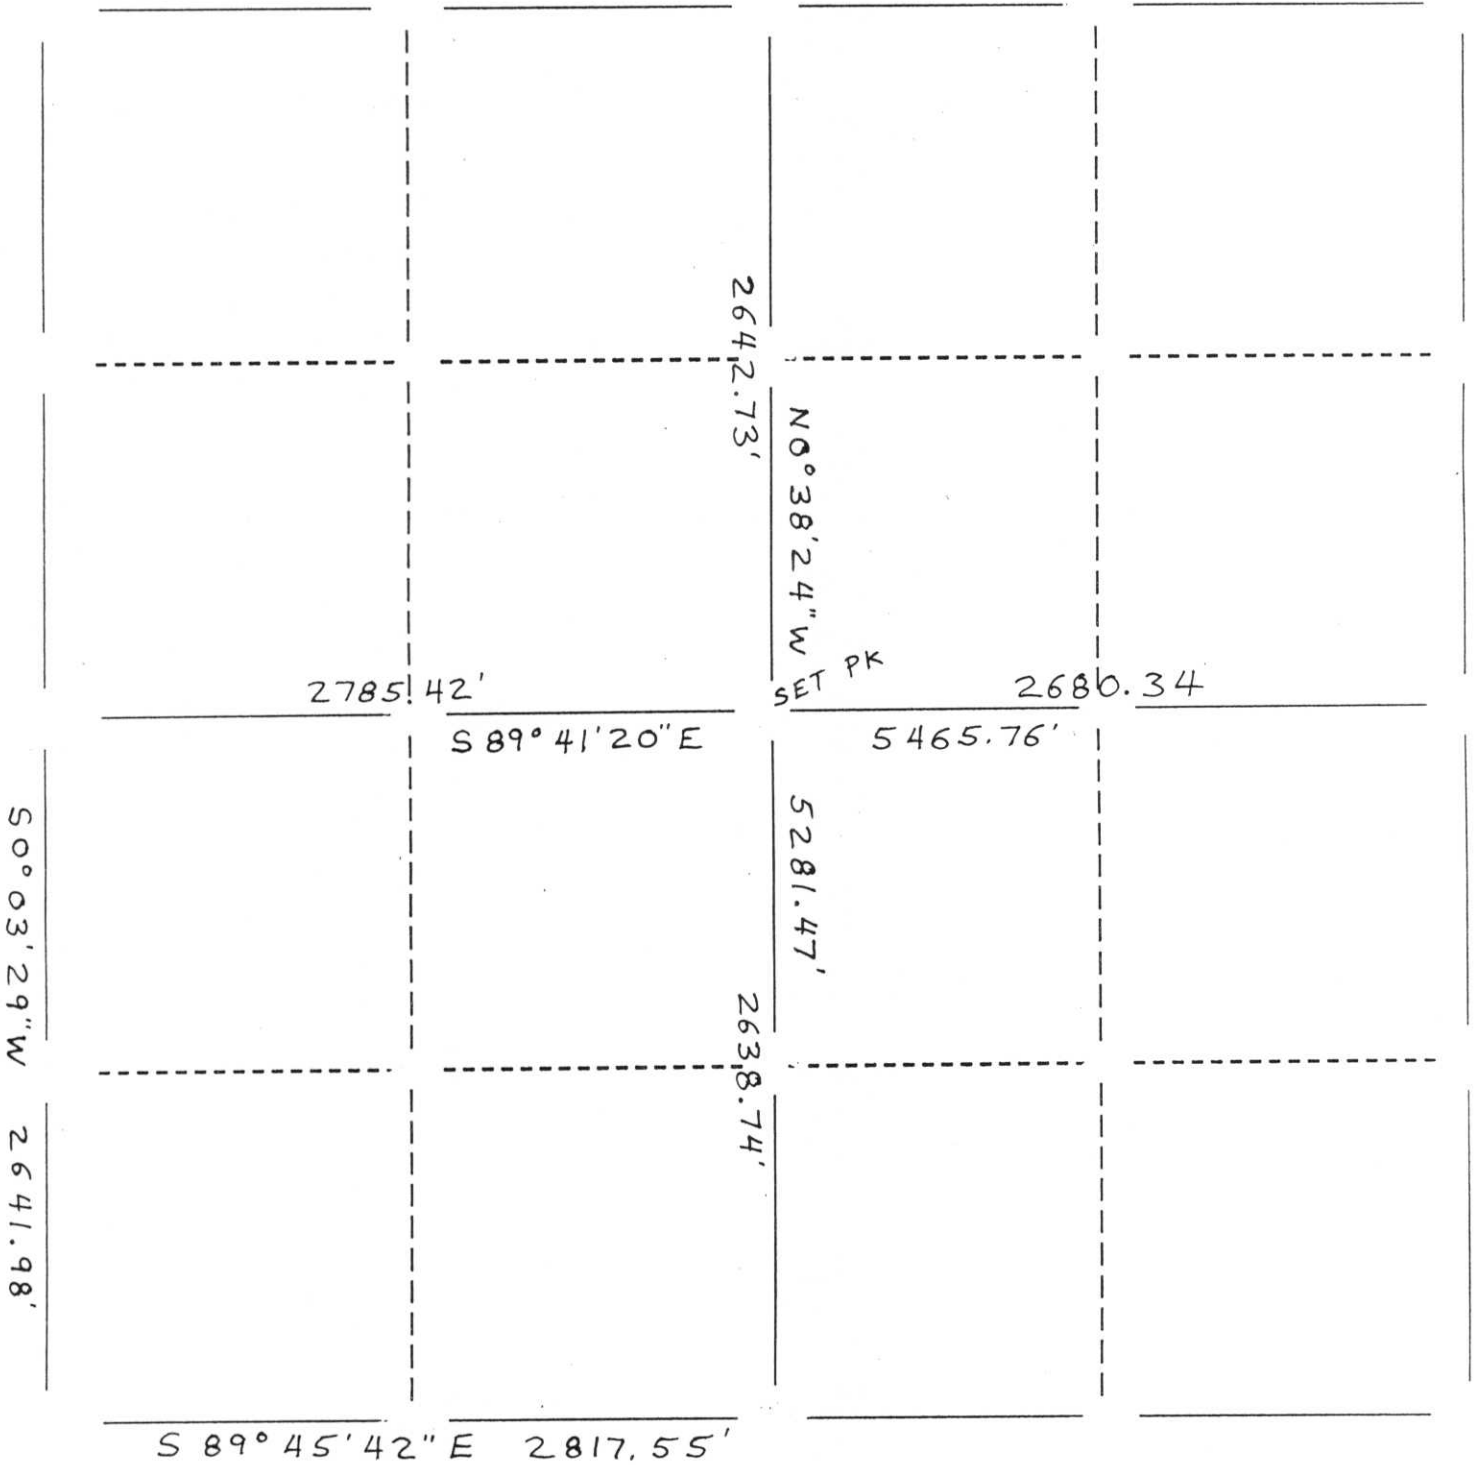

LEGEND

- ⊕ Berntsen Monument
- 2" Iron Pipe
- Stone or Concrete Monument
- 1" Iron Pipe
- Iron Pipe
- Other



RECEIVED BY LINCOLN COUNTY
SURVEYOR THIS 9TH DAY
OF November 20 05
Tony Dull
COUNTY SURVEYOR

CERTIFIED CORRECT

David Goslin

DATE: 10-23-00 Registered Land Surveyor

M.D.: 15