


Lincoln County

SECTION SUMMARY

20	31N	8E
Section	Township	Range
PINE RIVER		
Town		

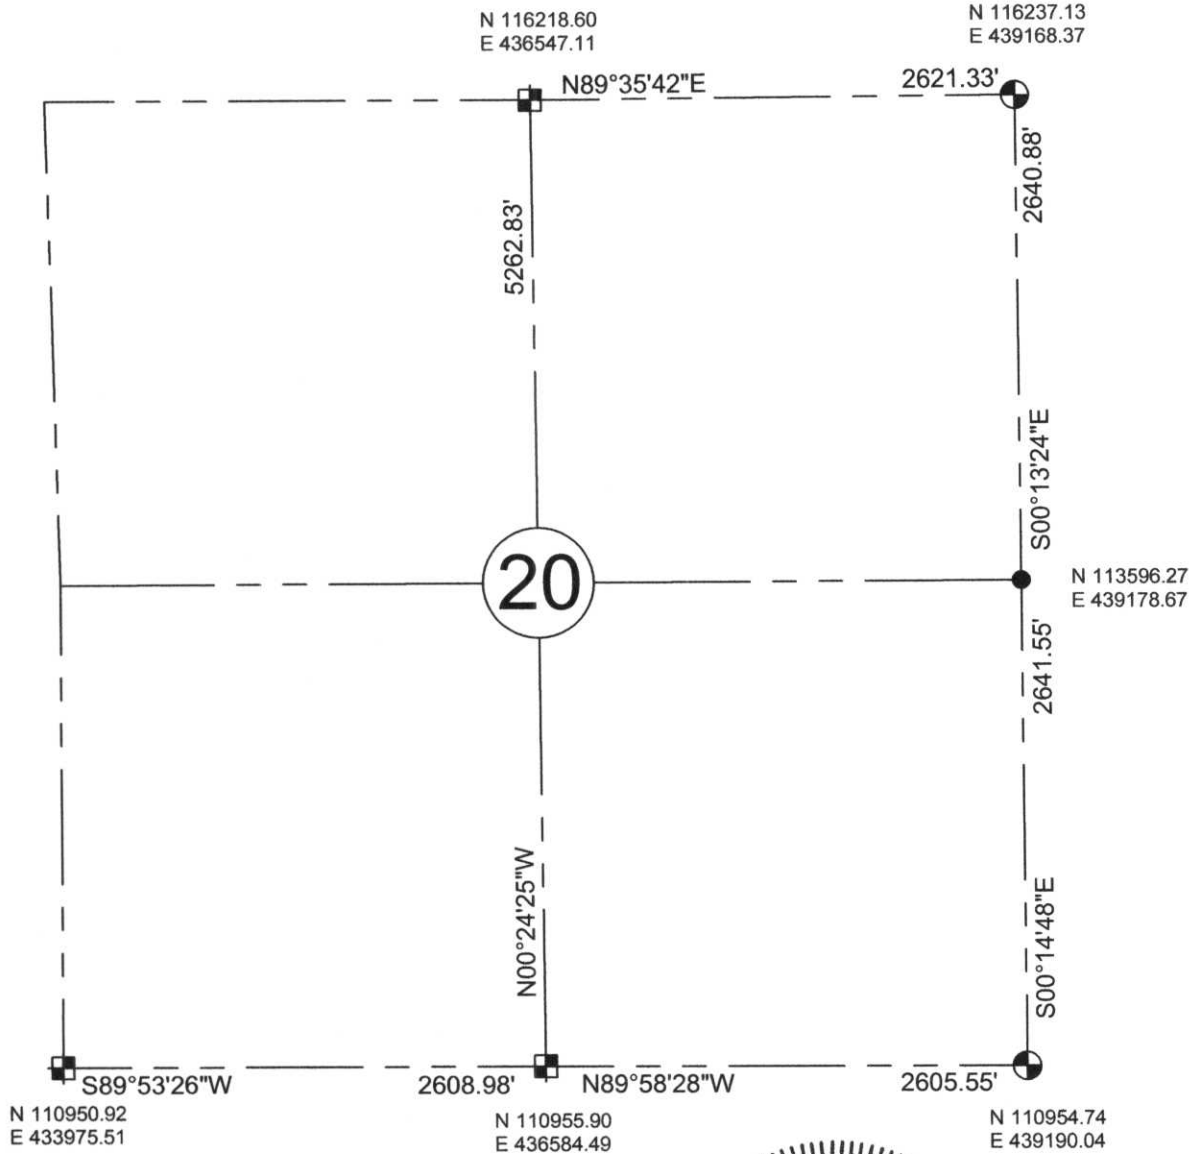

NOTE:
BEARINGS AND COORDINATES ARE BASED ON THE LINCOLN COUNTY COORDINATE SYSTEM AND REFERENCED TO THE PINE RIVER AND PINE DELLS GPS STATIONS.



SEAL
RECEIVED BY LINCOLN COUNTY
SURVEYOR THIS 6TH DAY


- LEGEND**
- ⊕ - BERNSTEIN MONUMENT
 - - SET MAG NAIL
 - ⊞ - FOUND GRANITE STONE
 - - SURVEY MARKING PIN

OF January 20 06
 COUNTY SURVEYOR Zany Dall CERTIFIED CORRECT:
Keith J. Walkowski
 KEITH J. WALKOWSKI
 Registered Land Surveyor
 DATE: Jan. 4TH, 2006

6'5" : 8'1" : 1/2"

Lincoln County Surveyor

SECTION SUMMARY 20 — 31 — 8E
 Section Township Range
PINE RIVER
 Town

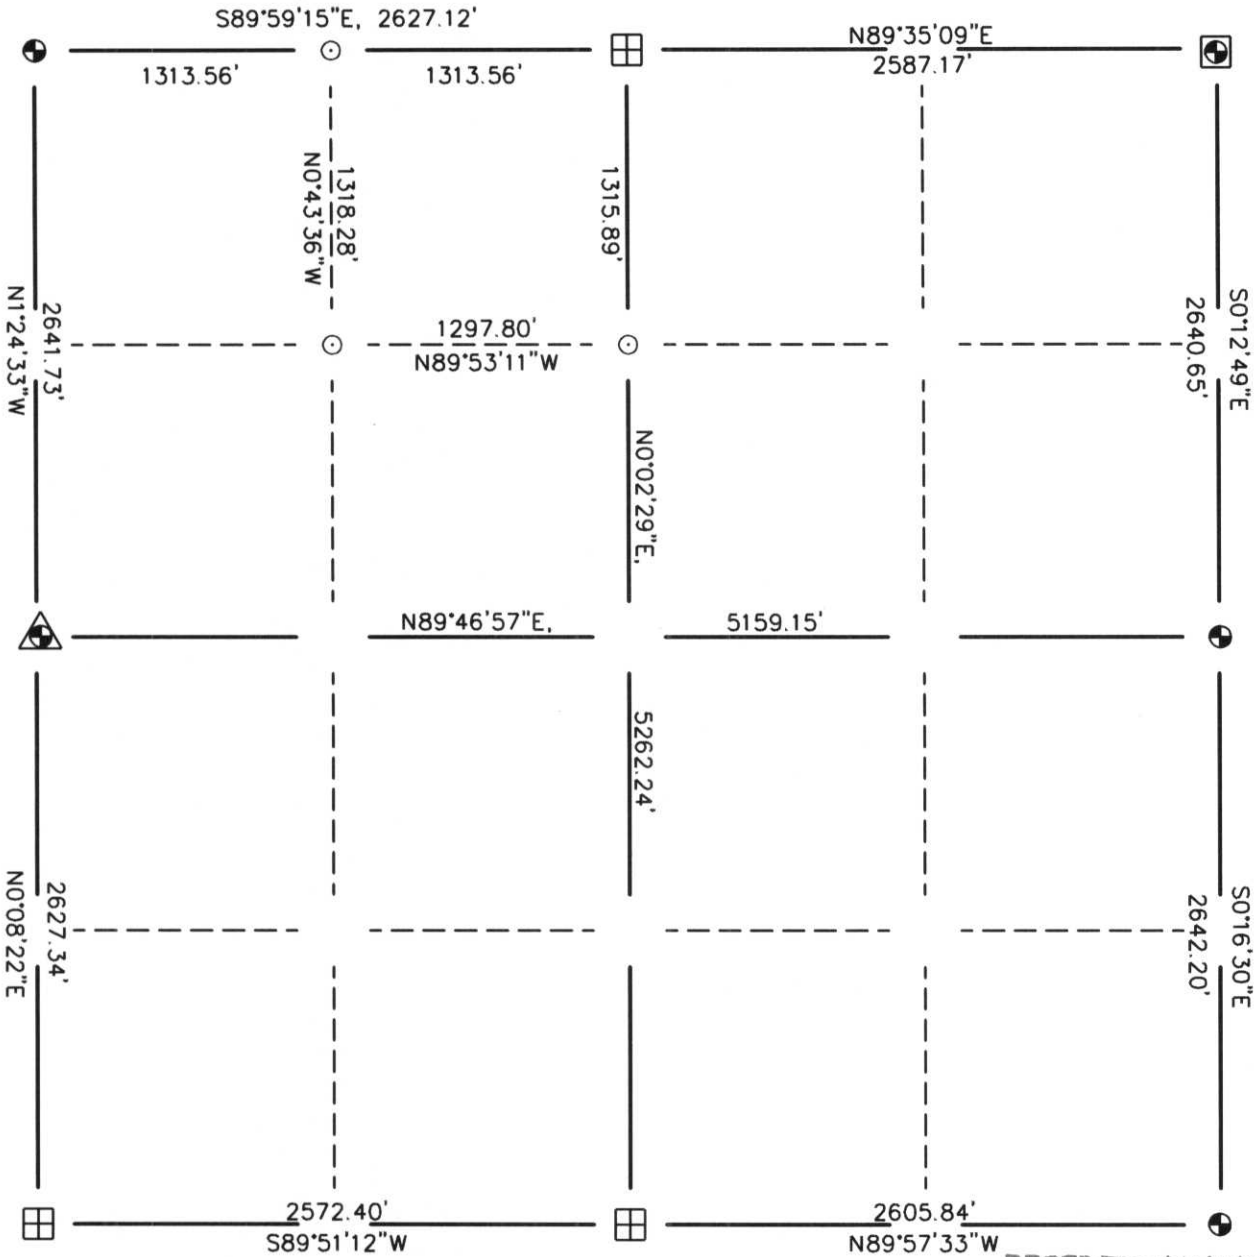

LEGEND

- ⊕ - Berntsen Monument
- ⊞ - 6" x 6" Red Granite Stone
- ⊞ - Berntsen Monument over White Stone
- ⊞ - Drag Tooth over a Berntsen Monument
- - Set 1" (ld) x 24" Iron Pipe



RECEIVED AT LINCOLN COUNTY
 COURTHOUSE THIS 13TH DAY
 OF March 2003

Tommy Dalko
 LAND INFORMATION OFFICE
 CERTIFIED CORRECT:
William W. Nutter, RLS

William W. Nutter
 Registered Land Surveyor

DATE: 3-10-2003