


LINCOLN COUNTY



28 - 31 - 8
Section Town Range

PINE RIVER
Township

SECTION SUMMARY

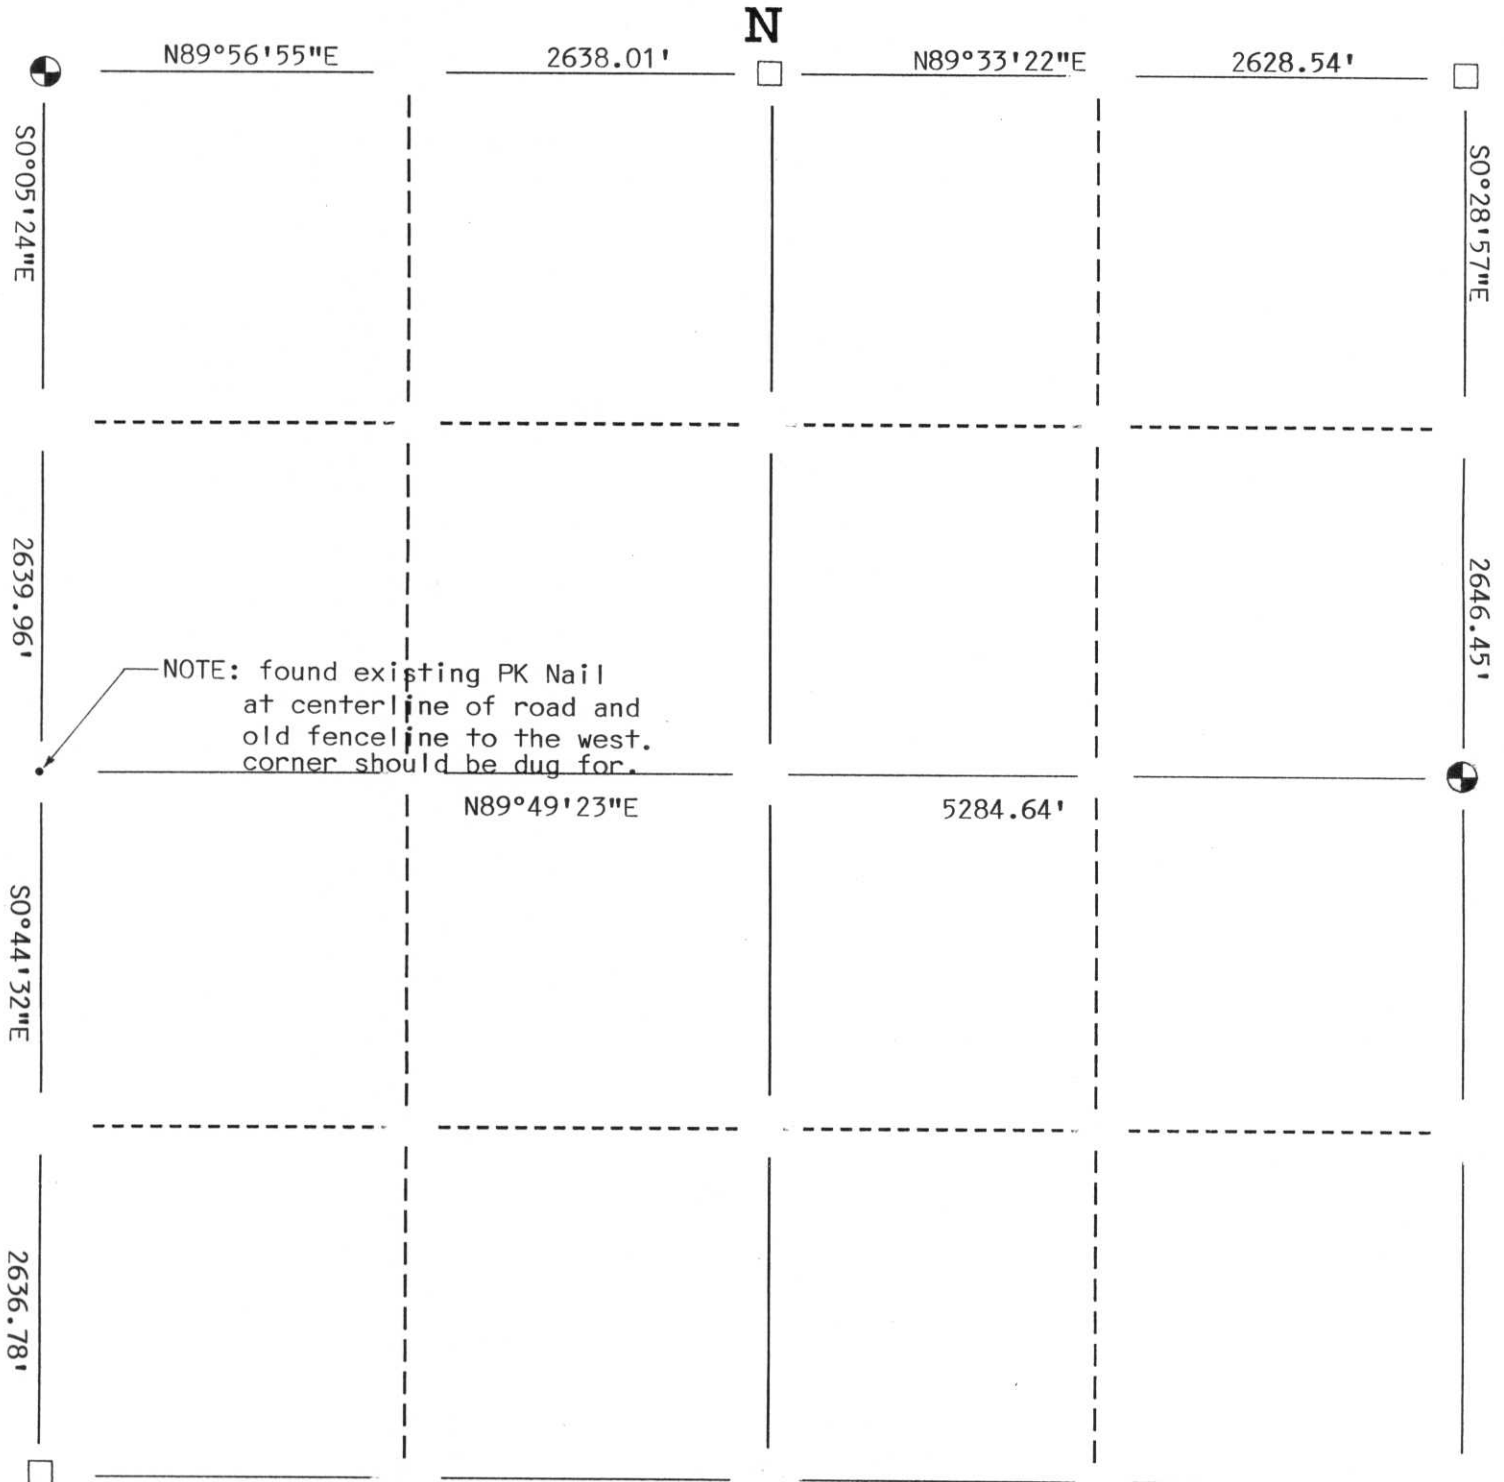

LEGEND

- Berntsen Monument
- 2" Iron Pipe
- Stone or Concrete Monument
- 1" Iron Pipe
- Iron Pipe
- Other



RECEIVED AT LINCOLN COUNTY
COURTHOUSE THIS 2ND DAY
OF April 20 03
Zony Dalko
LAND INFORMATION OFFICE

CERTIFIED CORRECT:

David J. Goslin
David J. Goslin

DATE: March 28, 2003 Registered Land Surveyor

Q-C: 9,13