

LEGEND

- ⊕ - Harrison Cast Iron Monument
- - Stone or Concrete Monument
- - 2" Iron Pipe
- - 1" Iron Pipe
- - Iron Bar

- △ - RR Spike
- - PK Nail
- ◆ - Other _____
- ◇ - _____
- ▲ - _____

5/15

LHM SURVEYING

6006 HILGEMAN STREET • SCHOFIELD, WI 54476

LINCOLN COUNTY




31 - T31N - R8E
Section Town Range

PINE RIVER
Township

SECTION SUMMARY

N

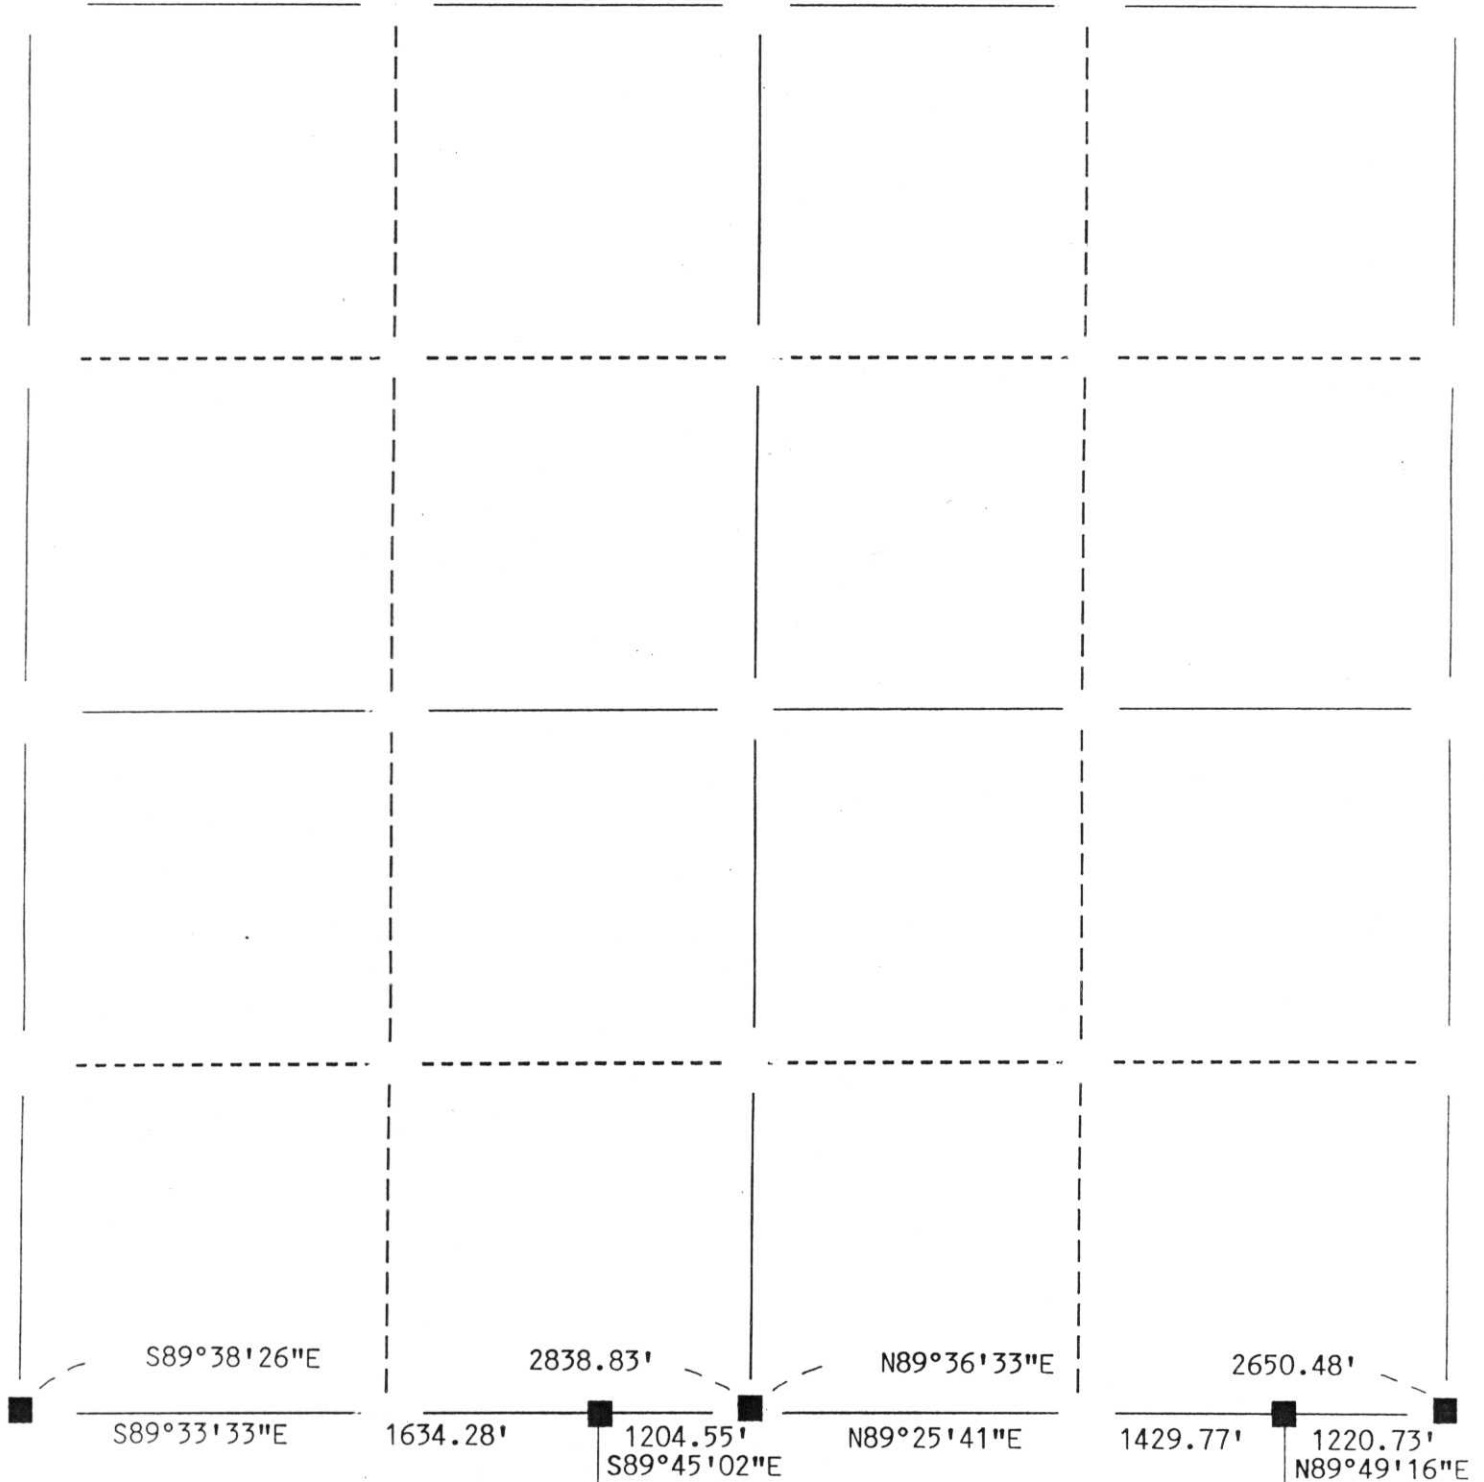

LEGEND

- ⊕ Berntsen Monument
- 2" Iron Pipe
- Stone or Concrete Monument
- 1" Iron Pipe
- Iron Pipe
- Other

Section 3 T30N, R8E

RECEIVED AT LINCOLN COUNTY
COURTHOUSE THIS 24TH DAY
OF October 20 03
Tommy Dahl
LAND INFORMATION OFFICE

Section 2

CERTIFIED CORRECT:

David J. Goslin
David J. Goslin

DATE: March 28, 2003 Registered Land Surveyor

44-15

LINCOLN COUNTY



31 - T31N - R8E
Section Town Range

PINE RIVER
Township

SECTION SUMMARY

N

RECEIVED AT LINCOLN COUNTY
COURTHOUSE THIS 2ND DAY
OF April 20 03
Tony Wall
LAND INFORMATION OFFICE

S89°38'26"E 2838.83' N89°36'33"E 2650.48'
S89°33'33"E 1634.28' 1204.55' N89°25'41"E 1429.77' 1220.73'
S89°45'02"E N89°49'16"E

LEGEND

- ⊕ Berntsen Monument
- 2" Iron Pipe
- Stone or Concrete Monument
- 1" Iron Pipe
- Iron Pipe
- Other

Section 3 T30N, R8E

Section 2



CERTIFIED CORRECT:

David J. Goslin

David J. Goslin

DATE: March 28, 2003 Registered Land Surveyor

U-9: 1,5