


Lincoln County

SECTION SUMMARY

33	31N	8E
Section	Township	Range
PINE RIVER		
Town		

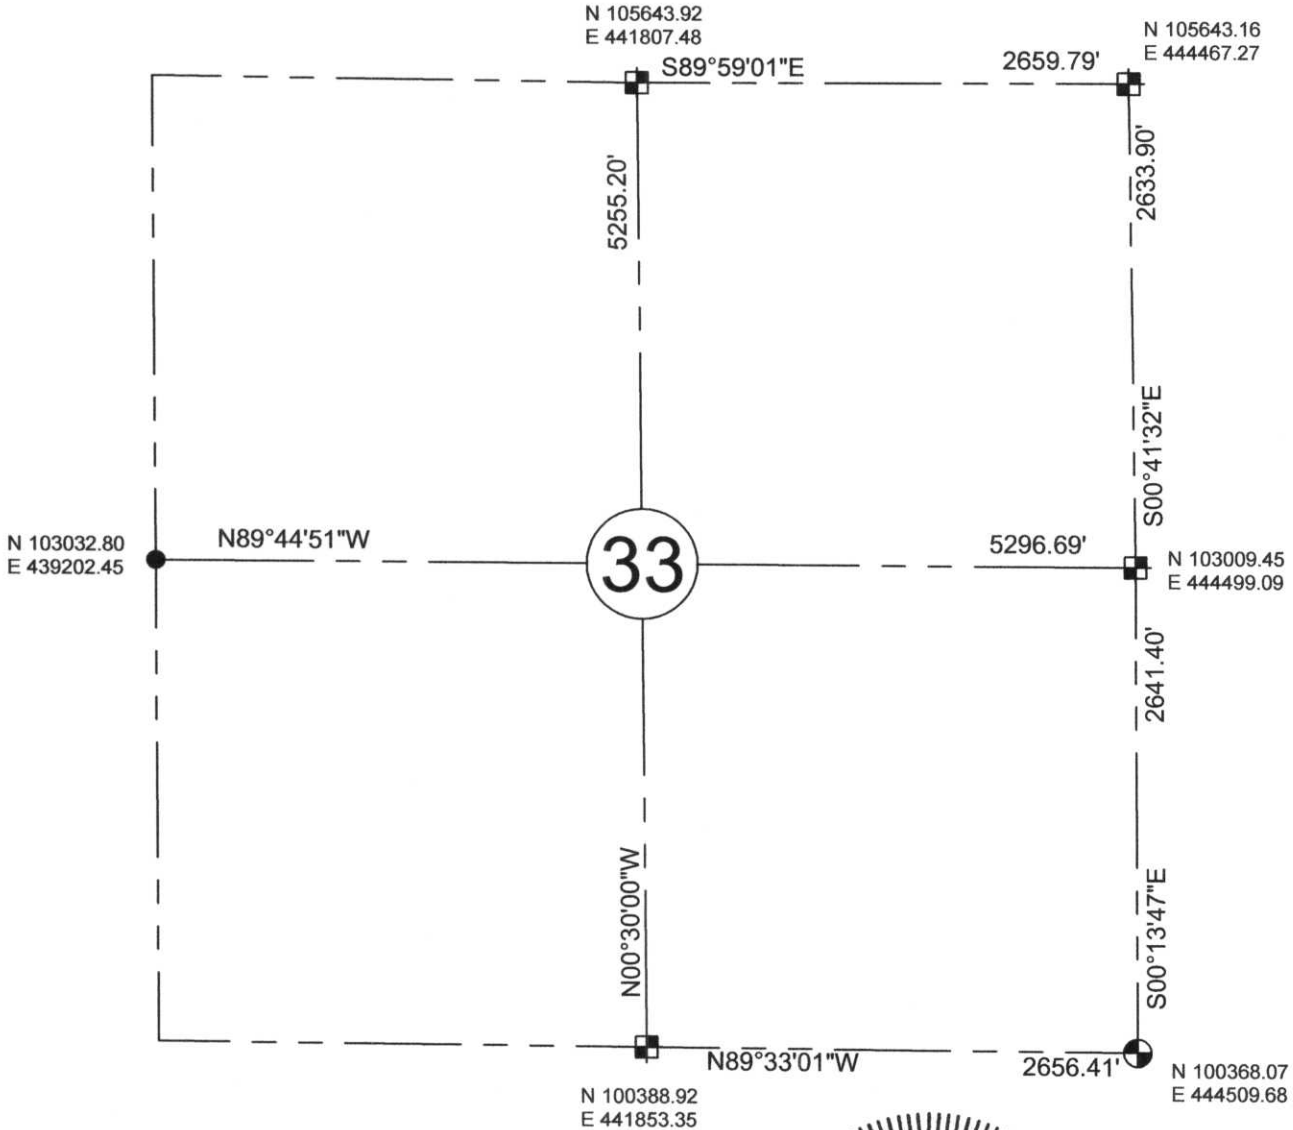

NOTE:
 BEARINGS AND COORDINATES ARE BASED ON THE
 LINCOLN COUNTY COORDINATE SYSTEM AND
 REFERENCED TO THE PINE RIVER AND PINE DELLS
 GPS STATIONS.

LEGEND

- ⊕ - BERNSTEIN MONUMENT
- - FOUND 3/4" REBAR
- ⊠ - FOUND GRANITE STONE
- - SURVEY MARKING PIN

SEAL
 RECEIVED BY LINCOLN COUNTY
 SURVEYOR THIS 6TH DAY

OF January 20 06

Tony Walker
 COUNTY SURVEYOR



CERTIFIED CORRECT:

Keith J. Walkowski
 KEITH J. WALKOWSKI
 Registered Land Surveyor
 DATE: Jan 4TH, 2006

M.P.: 9.13