



# Lincoln County Surveyor

SECTION SUMMARY 22 — 32 — 4E  
 Section Township Range  
CORNING  
 Town

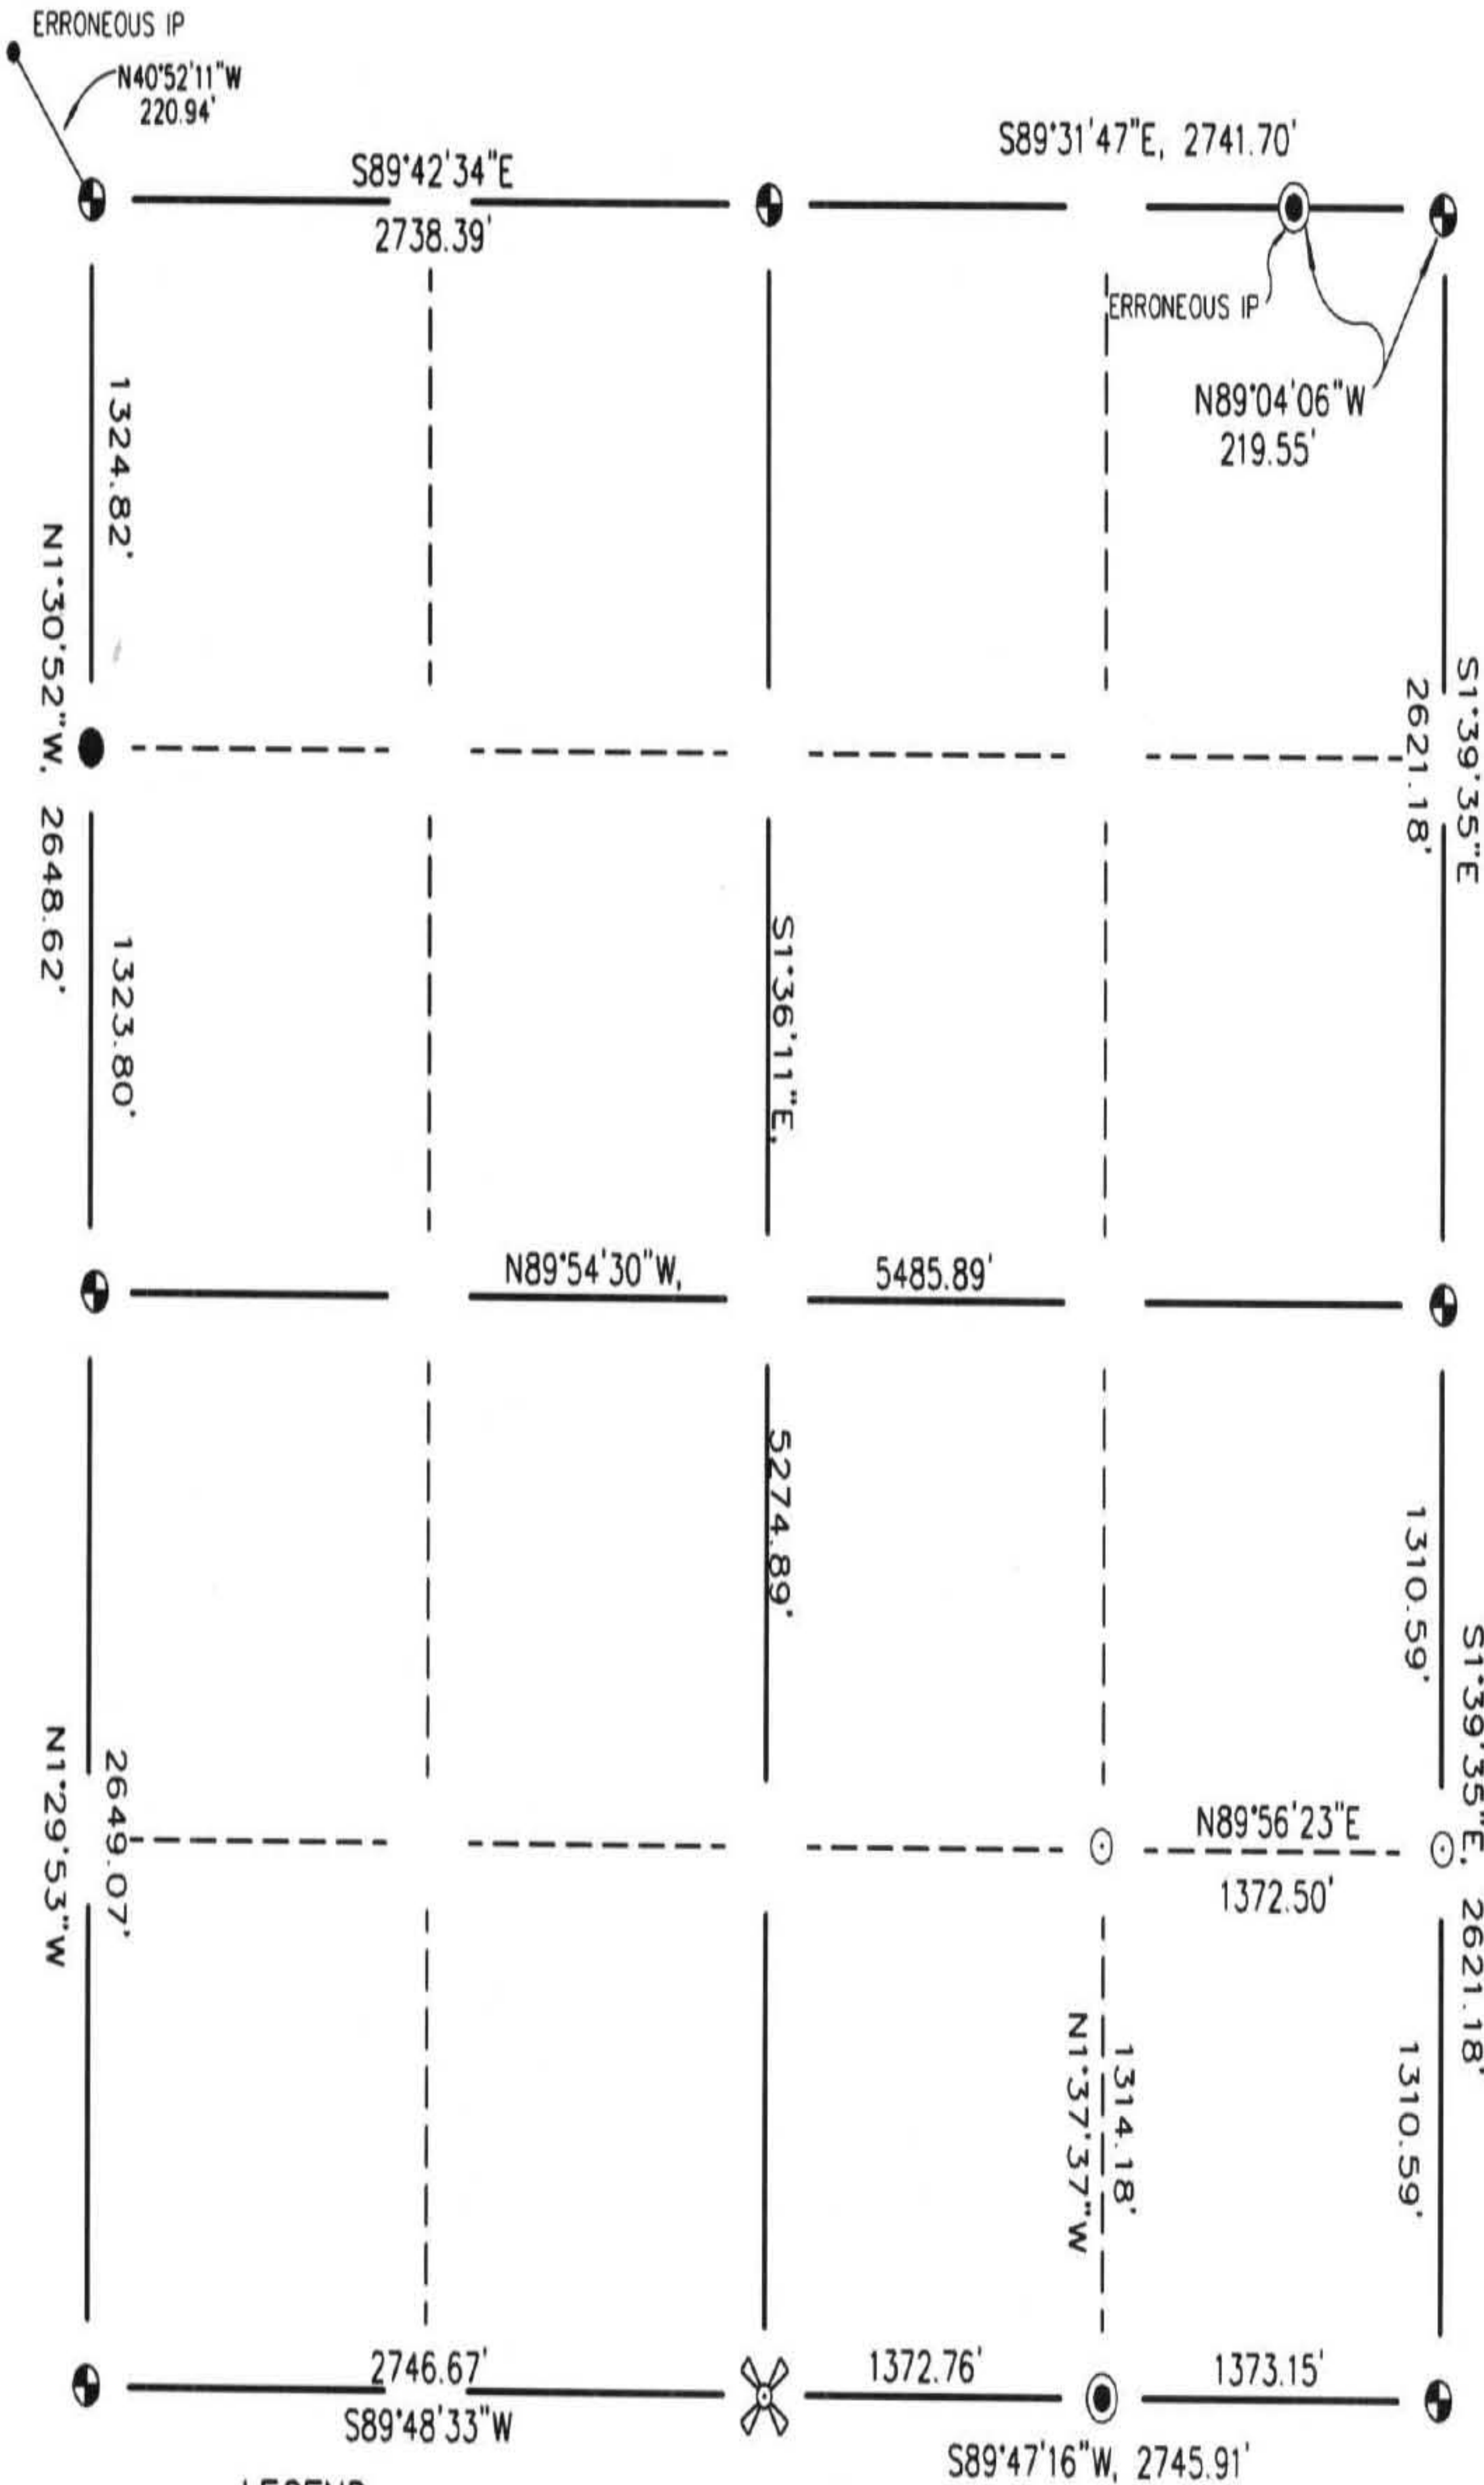

**LEGEND**

- ⊕ - Berntsen Monument
- ⊗ - Harrison Monument
- - Found 1-1/2" (id) Iron Pipe
- - Found 1" (od) Iron Pipe
- ⊙ - Found 1-1/4" (id) Iron Pipe
- - Set 1" (id) x 24" Iron Pipe

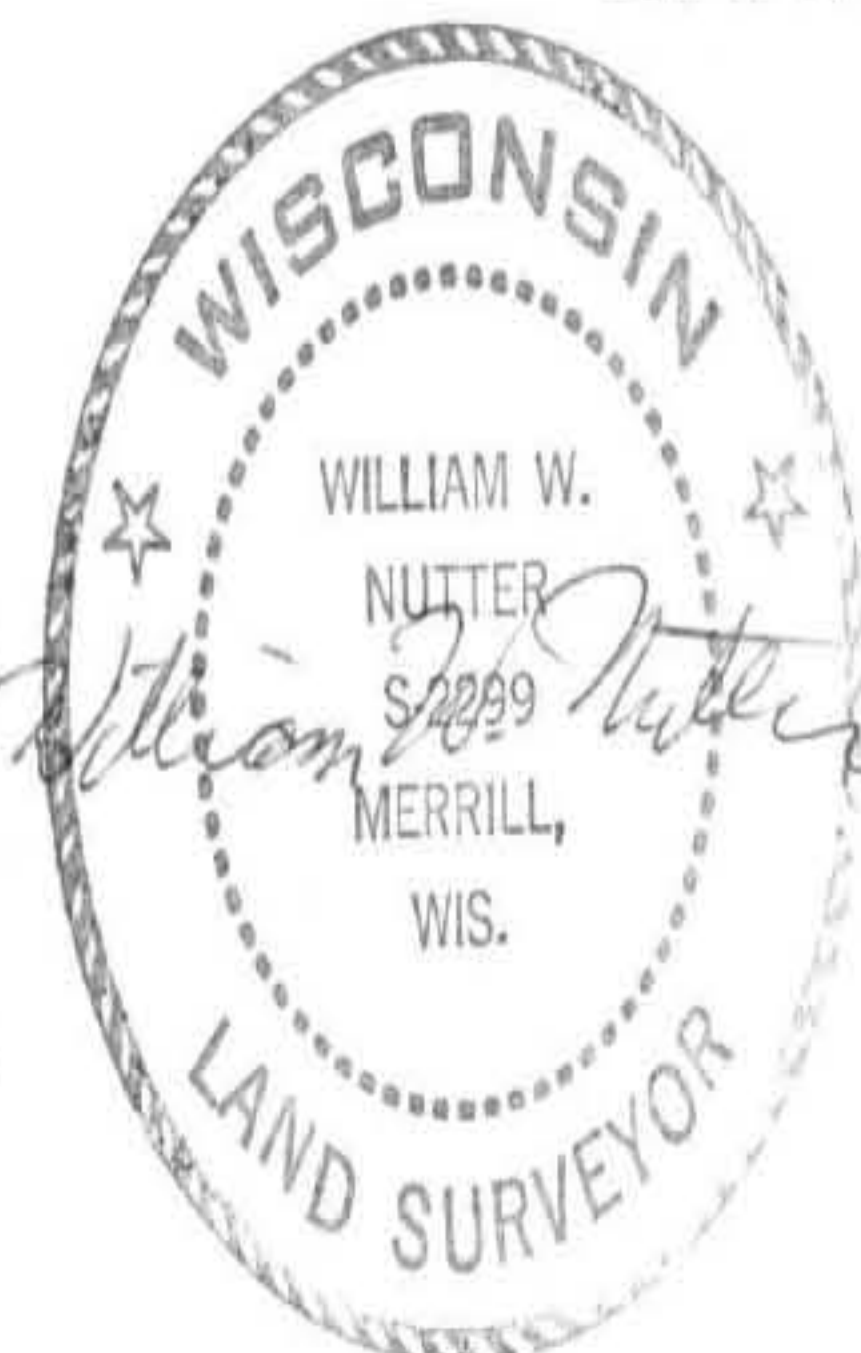

CERTIFIED CORRECT:  
 William W. Nutter, RLS

*William W. Nutter*  
 Registered Land Surveyor

DATE: 3-4-2003

M:G - 13:17