


**LINCOLN
county
surveyor**

**SECTION
SUMMARY**

1 - 32 - 6
Section - Town - Range

MERRILL
Township

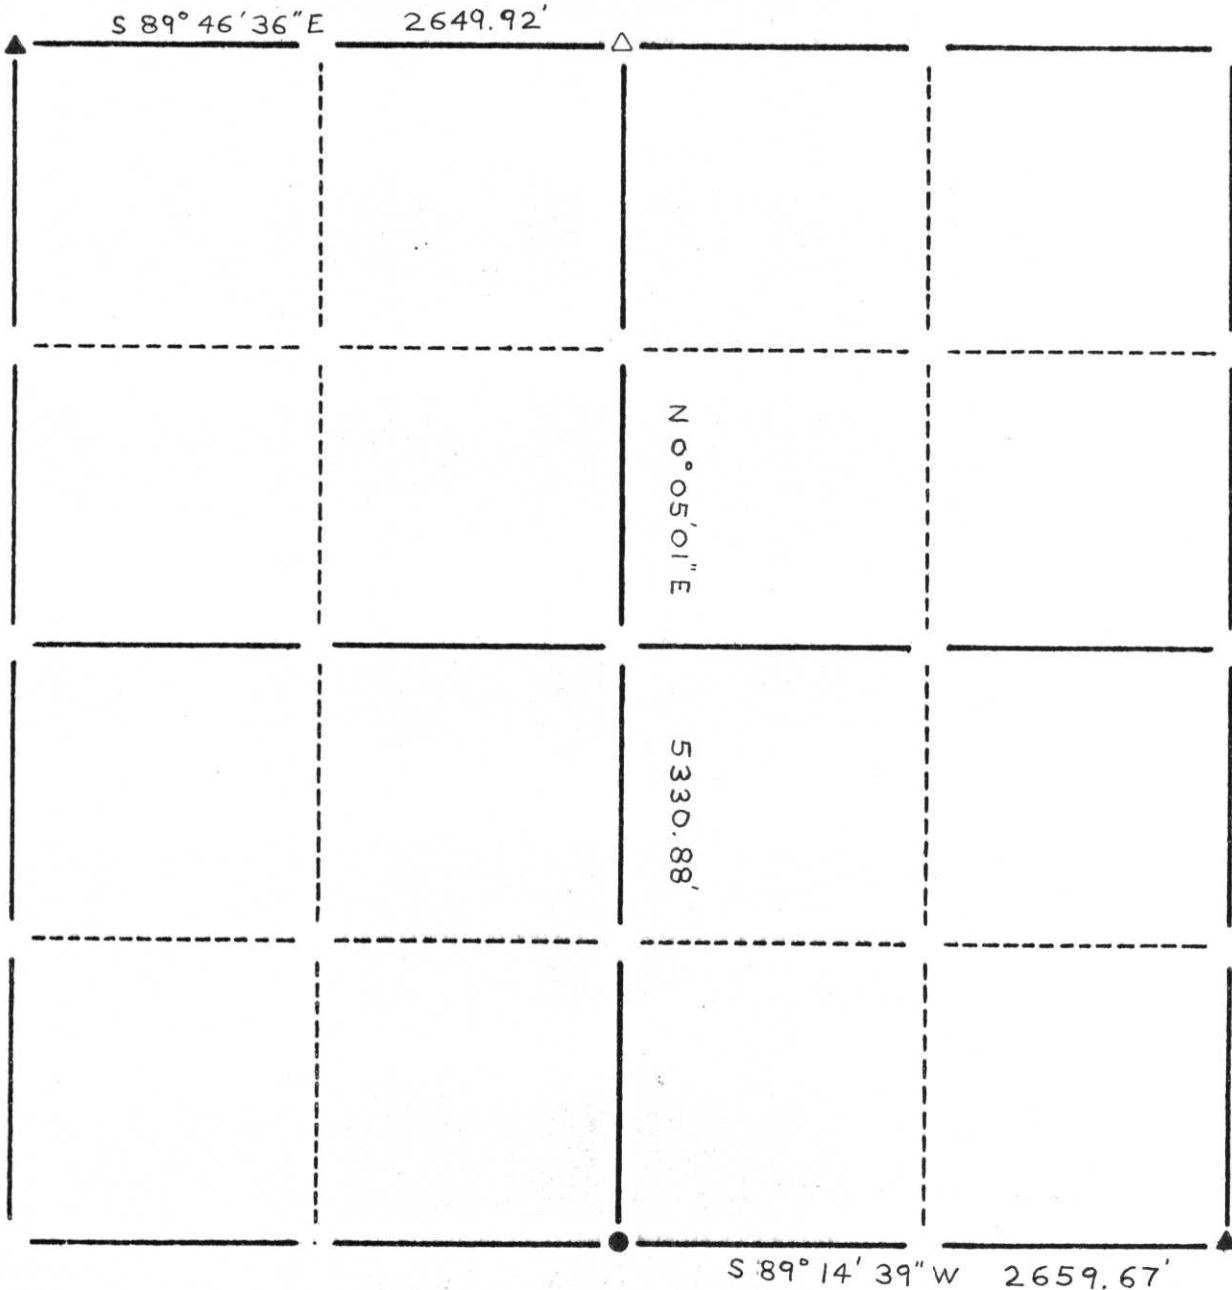

LEGEND

- ⊙ - Stone or Concrete Monument
- - 2" Iron Pipe
- - 1" Iron Pipe
- - Iron Bar
- Other
- △ recovered from State ties
- ▲ " " County ties

SEAL

CERTIFIED CORRECT:

Edwin R. Abendroth

Edwin R. Abendroth S-798

Registered Land Surveyor

DATE: August 19, 1996

RECEIVED AT LINCOLN COUNTY
COURTHOUSE THIS 23rd DAY
OF Aug 19 96
Pat Chamber
TAX DESCRIPTION OFFICE



H.E - 21:25