




SECTION
SUMMARY

15 - 32 - 6E
Section Township Range
MERRILL
Town

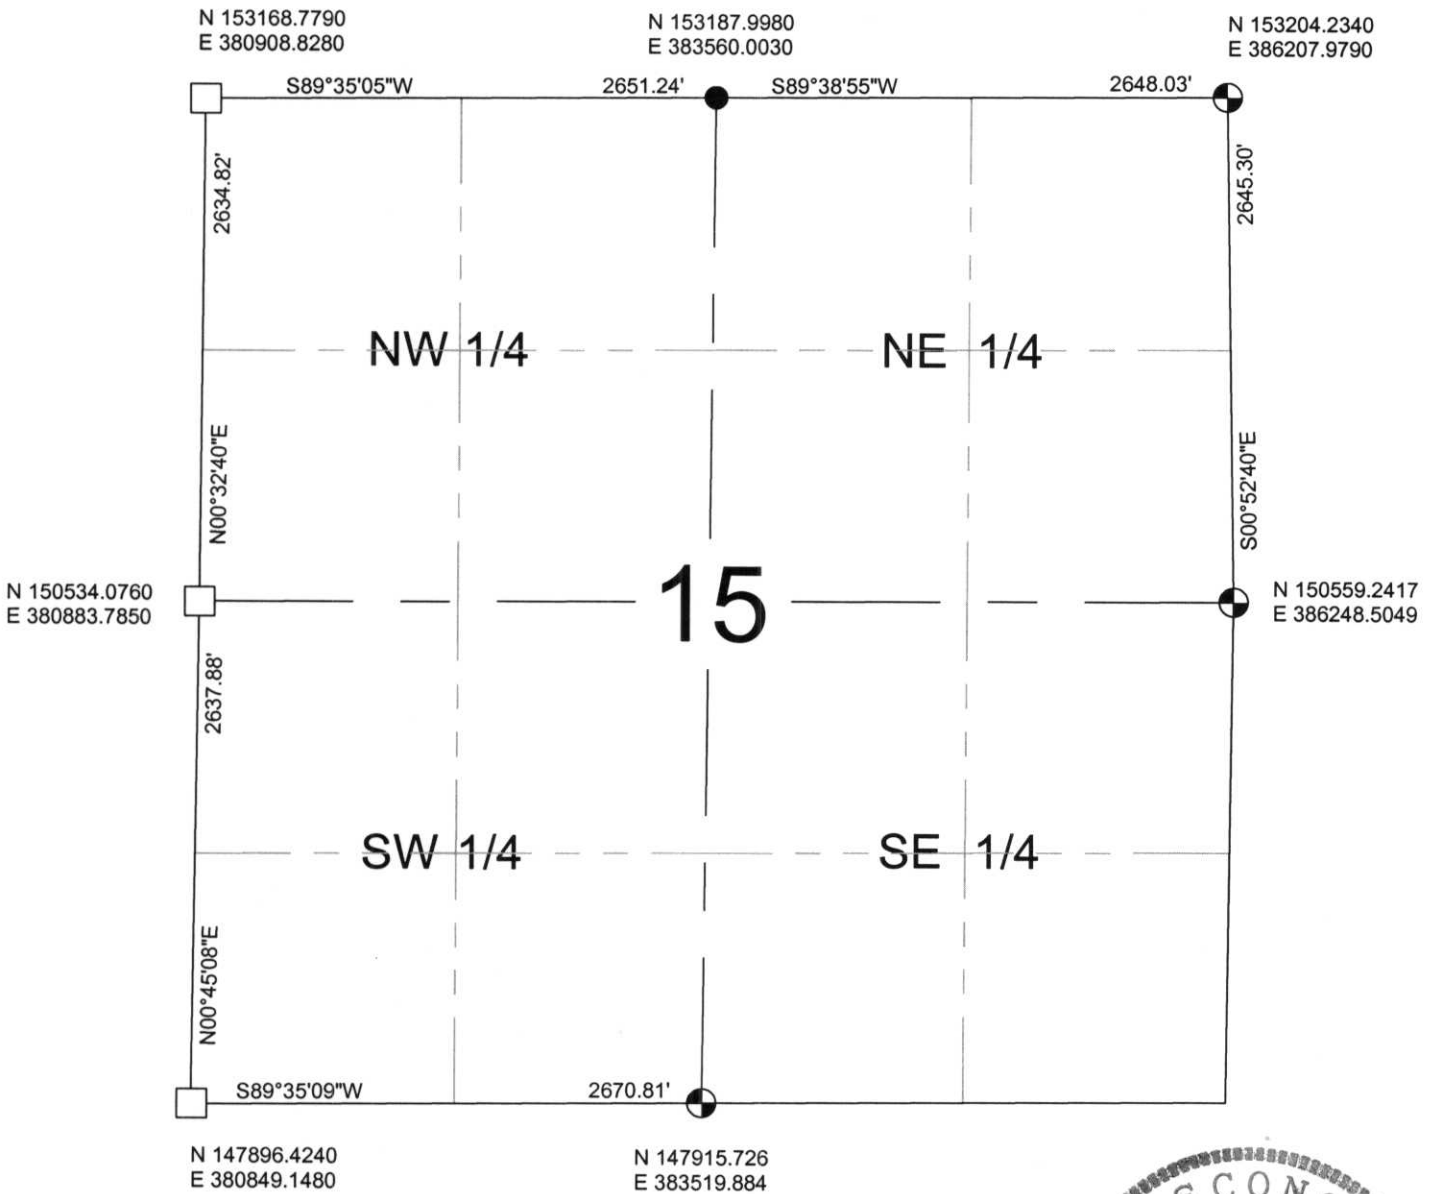

NOTES:
COORDINATES AND BEARINGS ARE REFERENCED TO THE LINCOLN COUNTY COORDINATE SYSTEM AS DEVELOPED BY THE WISCONSIN DEPARTMENT OF TRANSPORTATION AND WERE DETERMINED BY GPS OBSERVATIONS ON CONTROL POINTS AS SUPPLIED BY THE DOT.

- LEGEND**
- ⊙ - Lincoln County Monument
 - - Stone or Concrete Monument
 - - 1" Iron Pipe
 - - Iron Bar
 - △ - P.K. Nail

RECEIVED AT LINCOLN COUNTY
COURTHOUSE THIS 310 DAY
OF December 20 02
Tony Dahn
LAND INFORMATION OFFICE

CERTIFIED CORRECT:
David Renaud
DATE: 11-29-02 Registered Land Surveyor



I, M - 13, 17