





# SECTION SUMMARY

25 - 32  
Section Town Range

Merrill  
Township


LINCOLN COUNTY

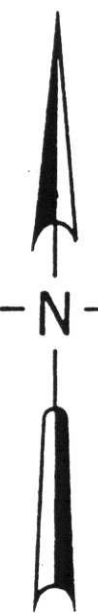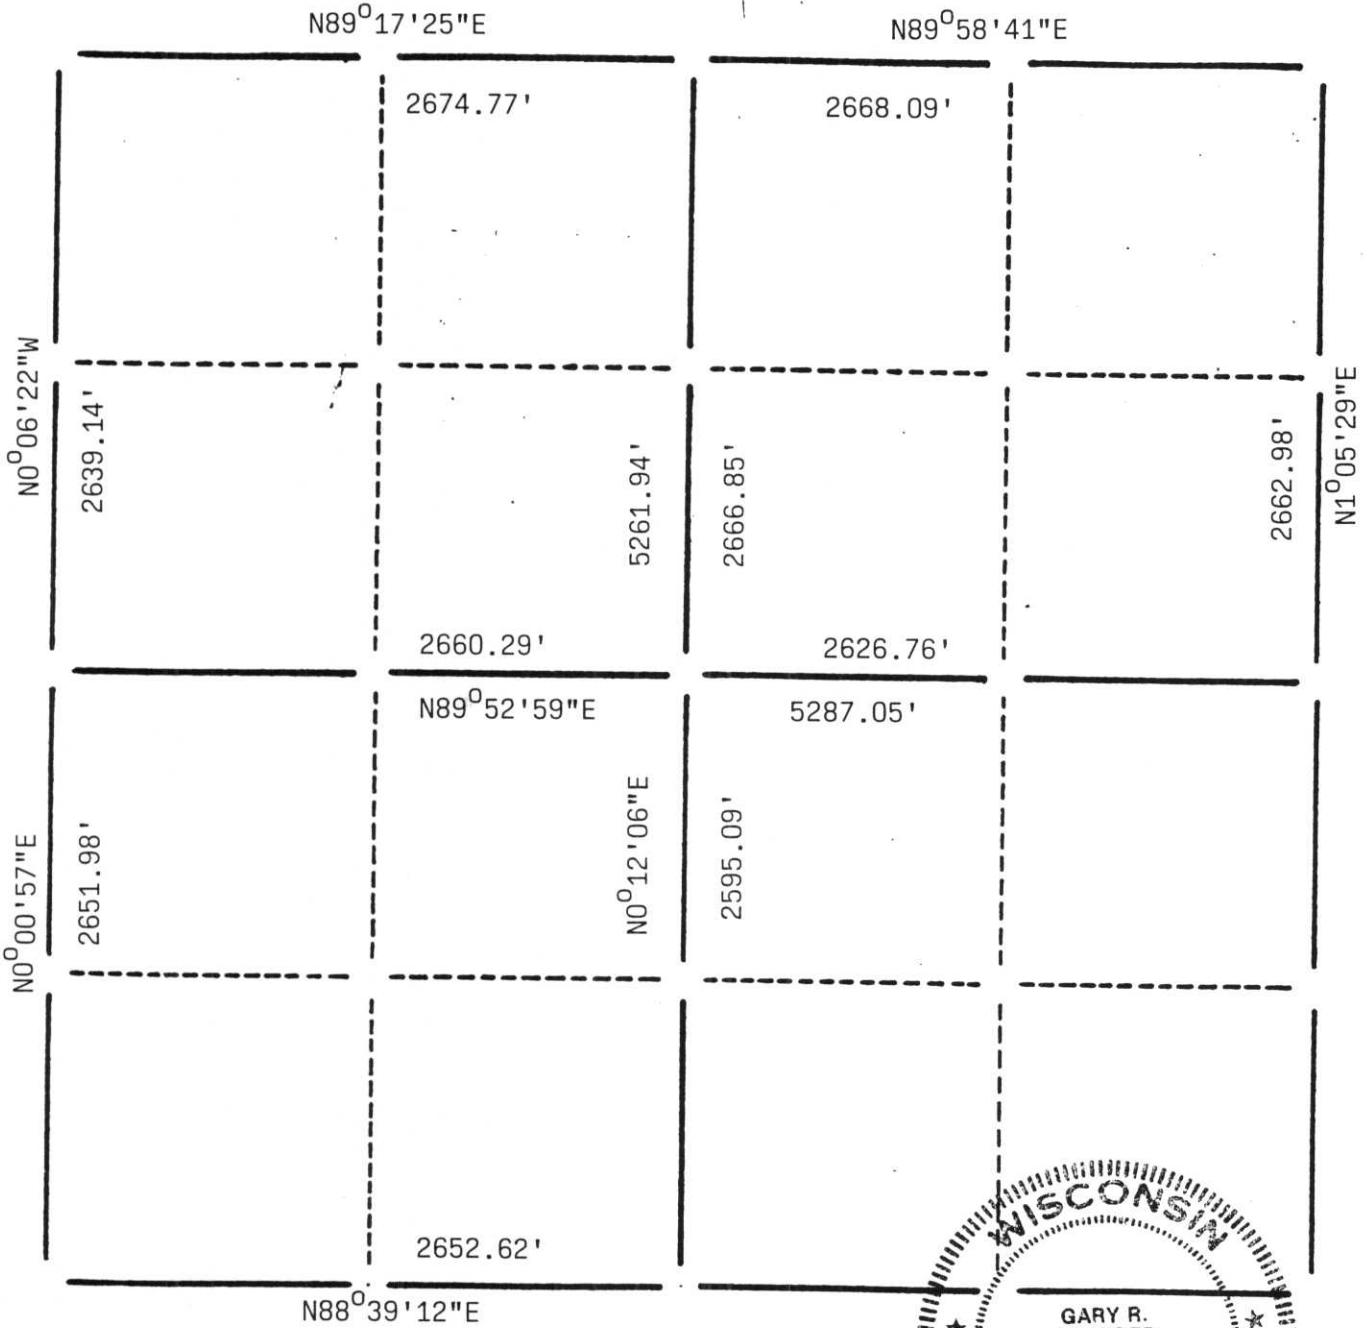

## LEGEND

- Harrison Cast Iron Monument
- Stone or Concrete Monument
- 2" Iron Pipe
- 1" Iron Pipe
- Iron Bar
- Other

SEAL

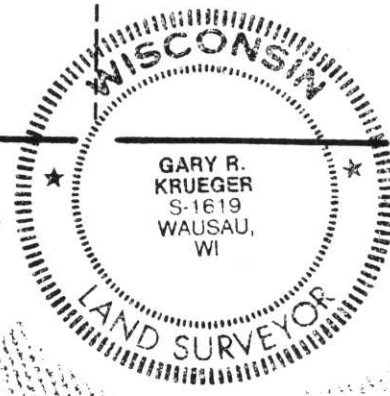

CERTIFIED CORRECT:  
Gary R. Krueger RLS NO.1619

DATE: 3-27-98 Registered Land Surveyor

Q:11-21:25