


LINCOLN COUNTY

SECTION SUMMARY

26 - 32 - 6
Section Town Range

MERRILL
Township

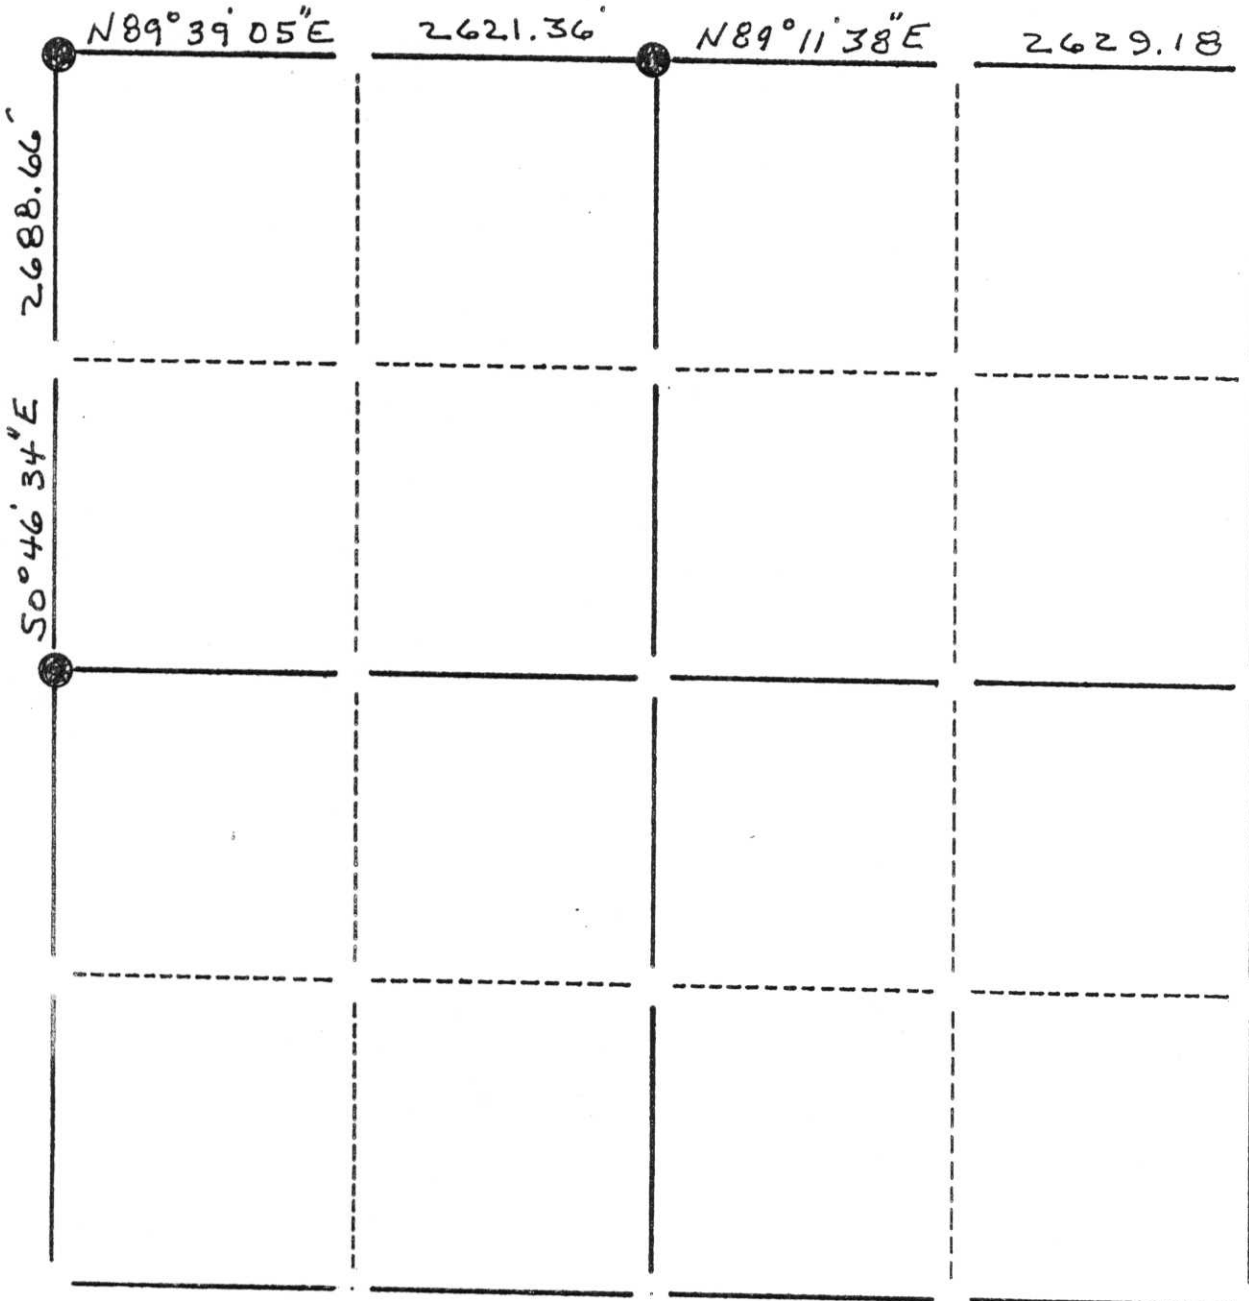

LEGEND

- ⊕ - Harrison Cast Iron Monument
- - Stone or Concrete Monument
- - 2" Iron Pipe
- - 1" Iron Pipe
- - Iron Bar
- △ - RR Spike
- - PK Nail
- - Other - Berntsen Monument
- ◇ - _____
- ▲ - _____



Revised 6-18-98 RKF

Robert K. Fergot
April 22, 1998


RECEIVED AT LINCOLN COUNTY
COURTHOUSE THIS 22nd DAY
OF June 19 98
Pat Orsick
TAX DESCRIPTION OFFICE

Q:4-17:21



SECTION
SUMMARY

26 - 32 - 6E
Section Township Range
MERRILL
Town

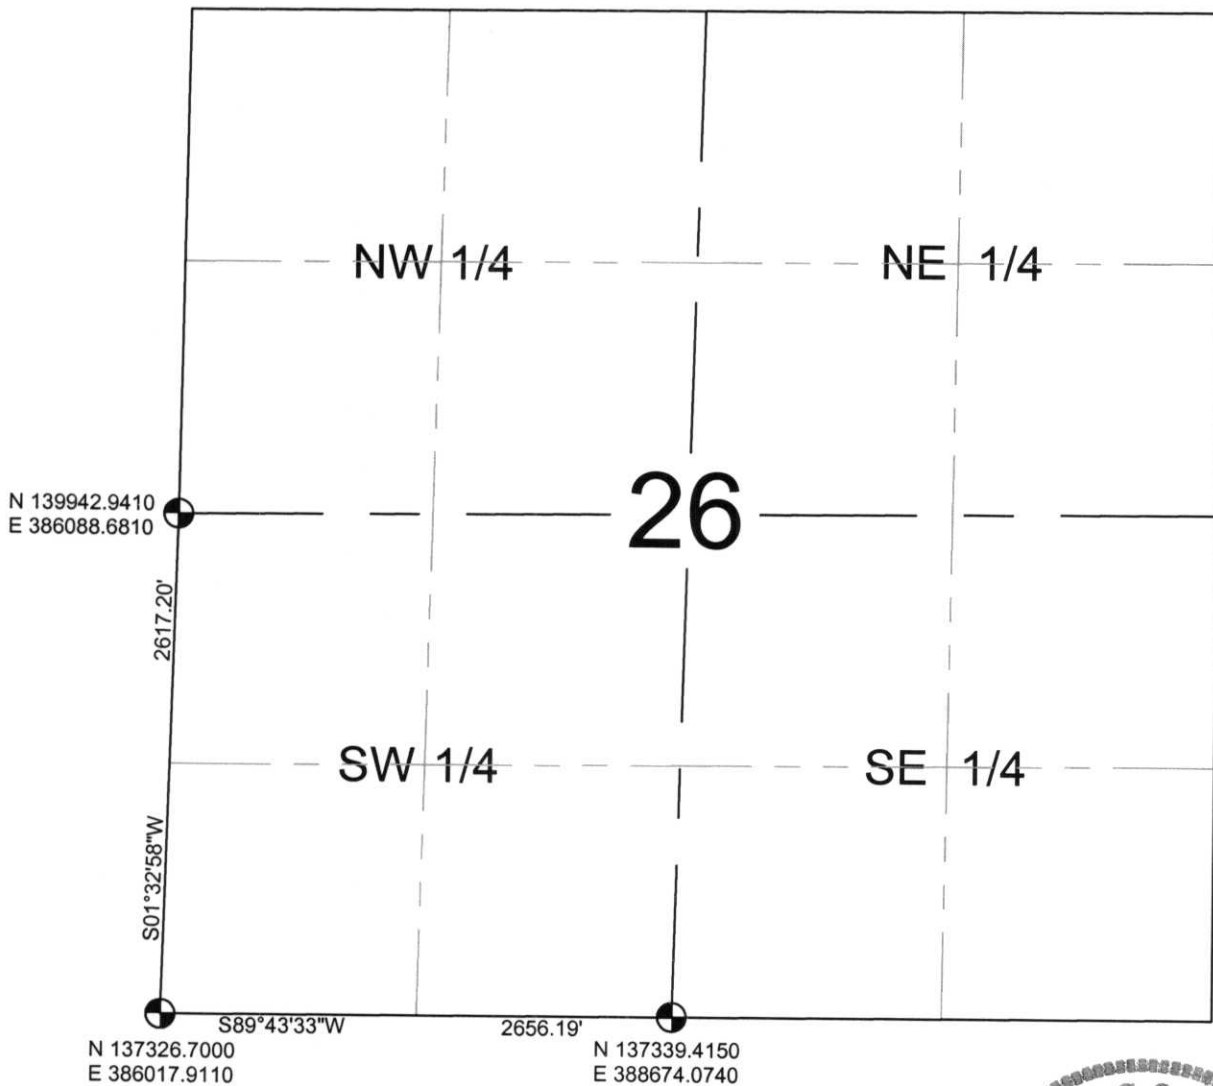

NOTES:
COORDINATES AND BEARINGS ARE REFERENCED TO THE LINCOLN COUNTY COORDINATE SYSTEM AS DEVELOPED BY THE WISCONSIN DEPARTMENT OF TRANSPORTATION AND WERE DETERMINED BY GPS OBSERVATIONS ON CONTROL POINTS AS SUPPLIED BY THE DOT.

- LEGEND**
- ⊕ - Lincoln County Monument
 - - Stone or Concrete Monument
 - - 1" Iron Pipe
 - - Iron Bar
 - △ - P.K. Nail

RECEIVED AT LINCOLN COUNTY
COURTHOUSE THIS 3RD DAY
OF December 20 02
Tony Dabbs
LAND INFORMATION OFFICE

CERTIFIED CORRECT:

David Renaud
DATE: 11-29-02 Registered Land Surveyor



R.U. - 17, 21