
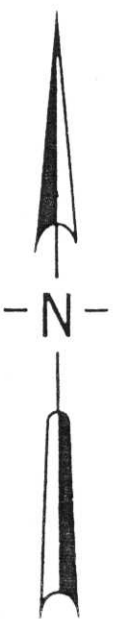


LINCOLN COUNTY

SECTION SUMMARY

27 - 32 - 6  
Section Town Range

MERRILL  
Township

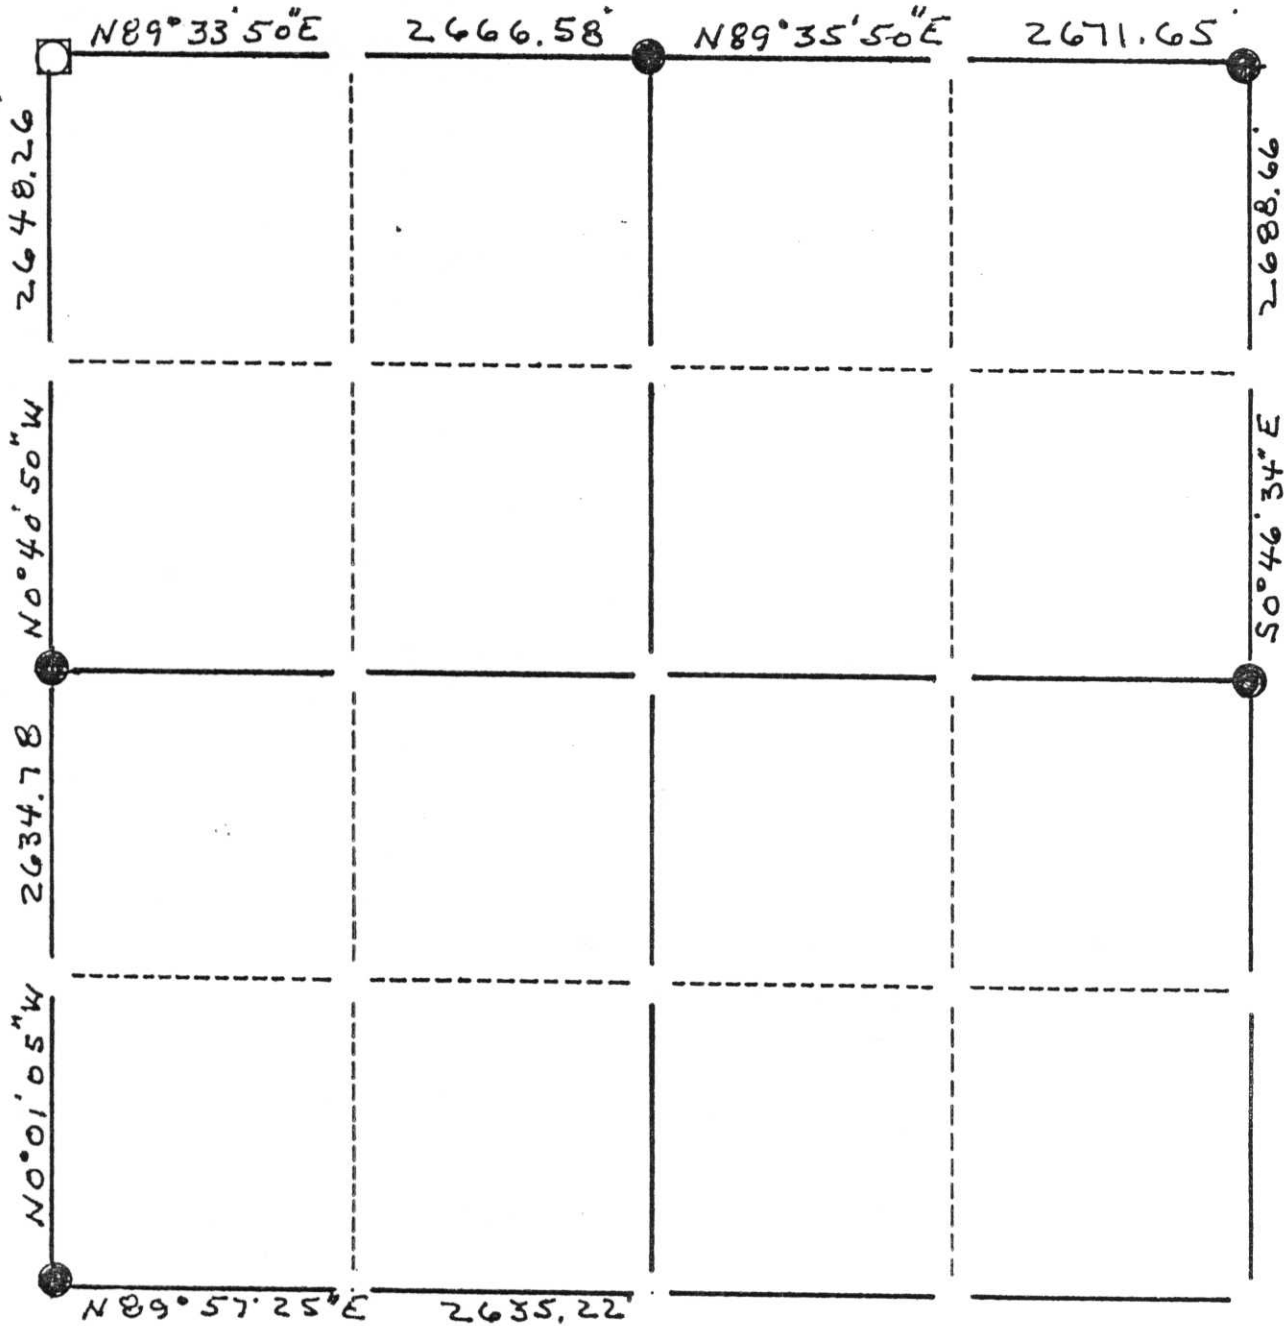

LEGEND

- ⊕ - Harrison Cast Iron Monument
- - Stone or Concrete Monument
- - 2" Iron Pipe
- - 1" Iron Pipe
- - Iron Bar
- △ - RR Spike
- - PK Nail
- - Other - Berntsen Monument
- ◇ - \_\_\_\_\_
- ▲ - \_\_\_\_\_



Revised 6-18-98 RKF

Robert K. Fergot  
April 22, 1998


RECEIVED AT LINCOLN COUNTY  
COURTHOUSE THIS 23rd DAY  
OF June 19 98  
Pat Pribe  
TAX DESCRIPTION OFFICE

Q:V-13:17



SECTION  
SUMMARY


27 - 32 - 6E  
Section Township Range  
**MERRILL**  
Town

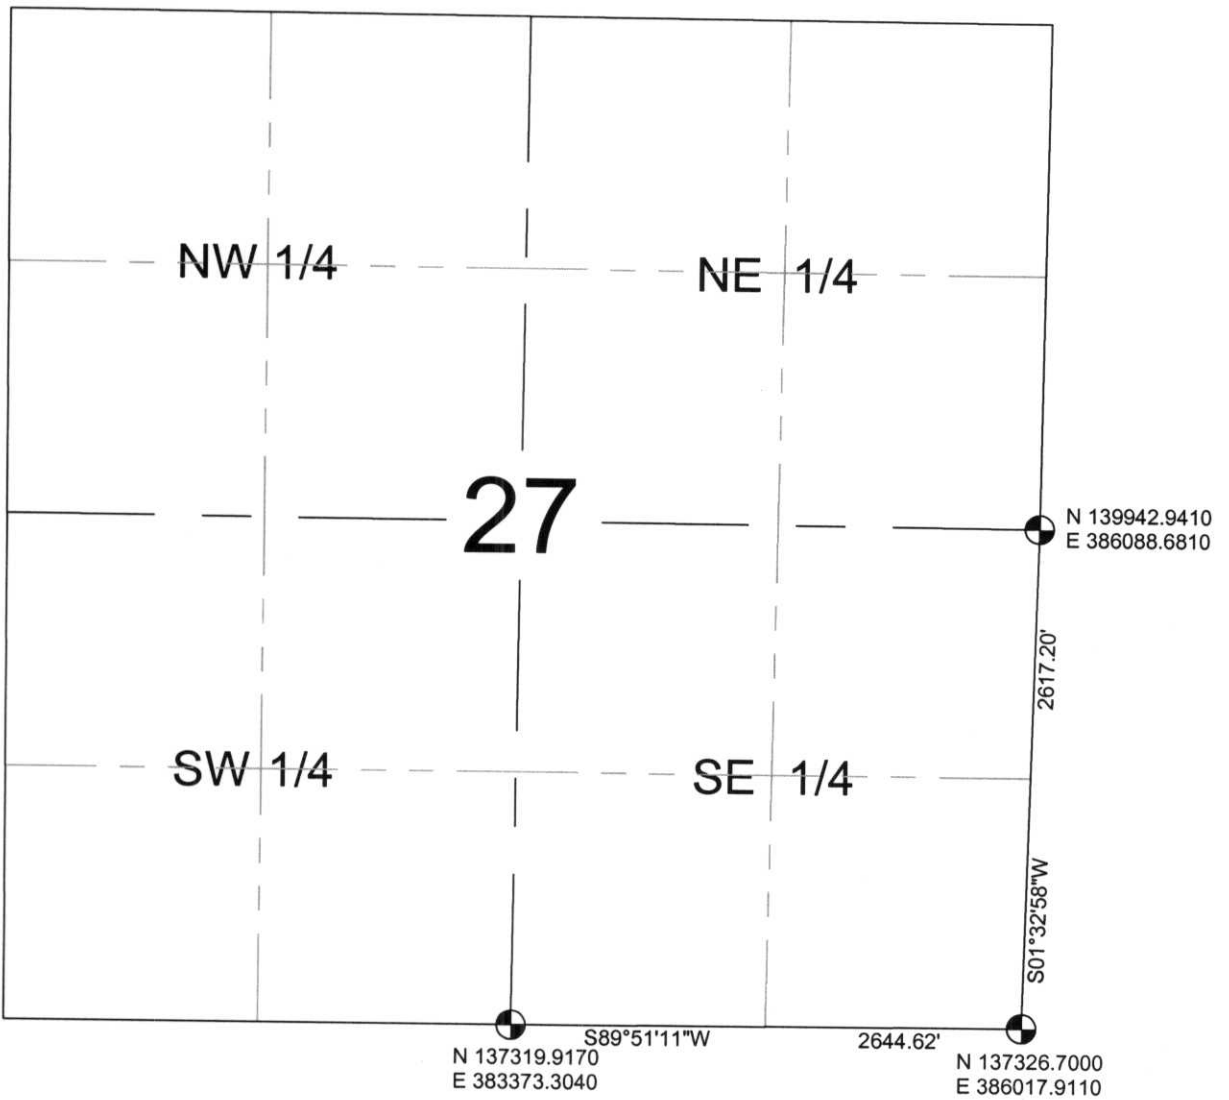

NOTES:  
COORDINATES AND BEARINGS ARE REFERENCED TO THE LINCOLN COUNTY COORDINATE SYSTEM AS DEVELOPED BY THE WISCONSIN DEPARTMENT OF TRANSPORTATION AND WERE DETERMINED BY GPS OBSERVATIONS ON CONTROL POINTS AS SUPPLIED BY THE DOT.

- LEGEND**
- ⊕ - Lincoln County Monument
  - - Stone or Concrete Monument
  - - 1" Iron Pipe
  - - Iron Bar
  - △ - P.K. Nail

RECEIVED AT LINCOLN COUNTY  
COURTHOUSE THIS 3<sup>RD</sup> DAY  
OF December 20 02  
*Tony Dabbs*  
LAND INFORMATION OFFICE

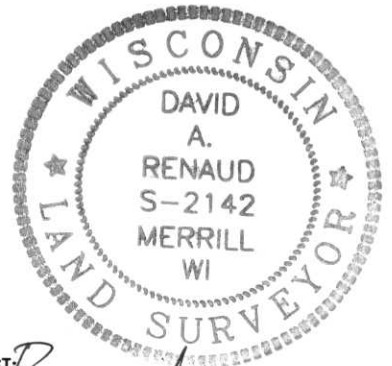

CERTIFIED CORRECT:  
*David Renaud*  
Registered Land Surveyor  
DATE: 11-29-02

4,4 - 13,17