
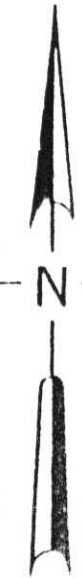


LINCOLN COUNTY

SECTION SUMMARY

33 - 32 - 6
Section Town Range

MERRILL
Township

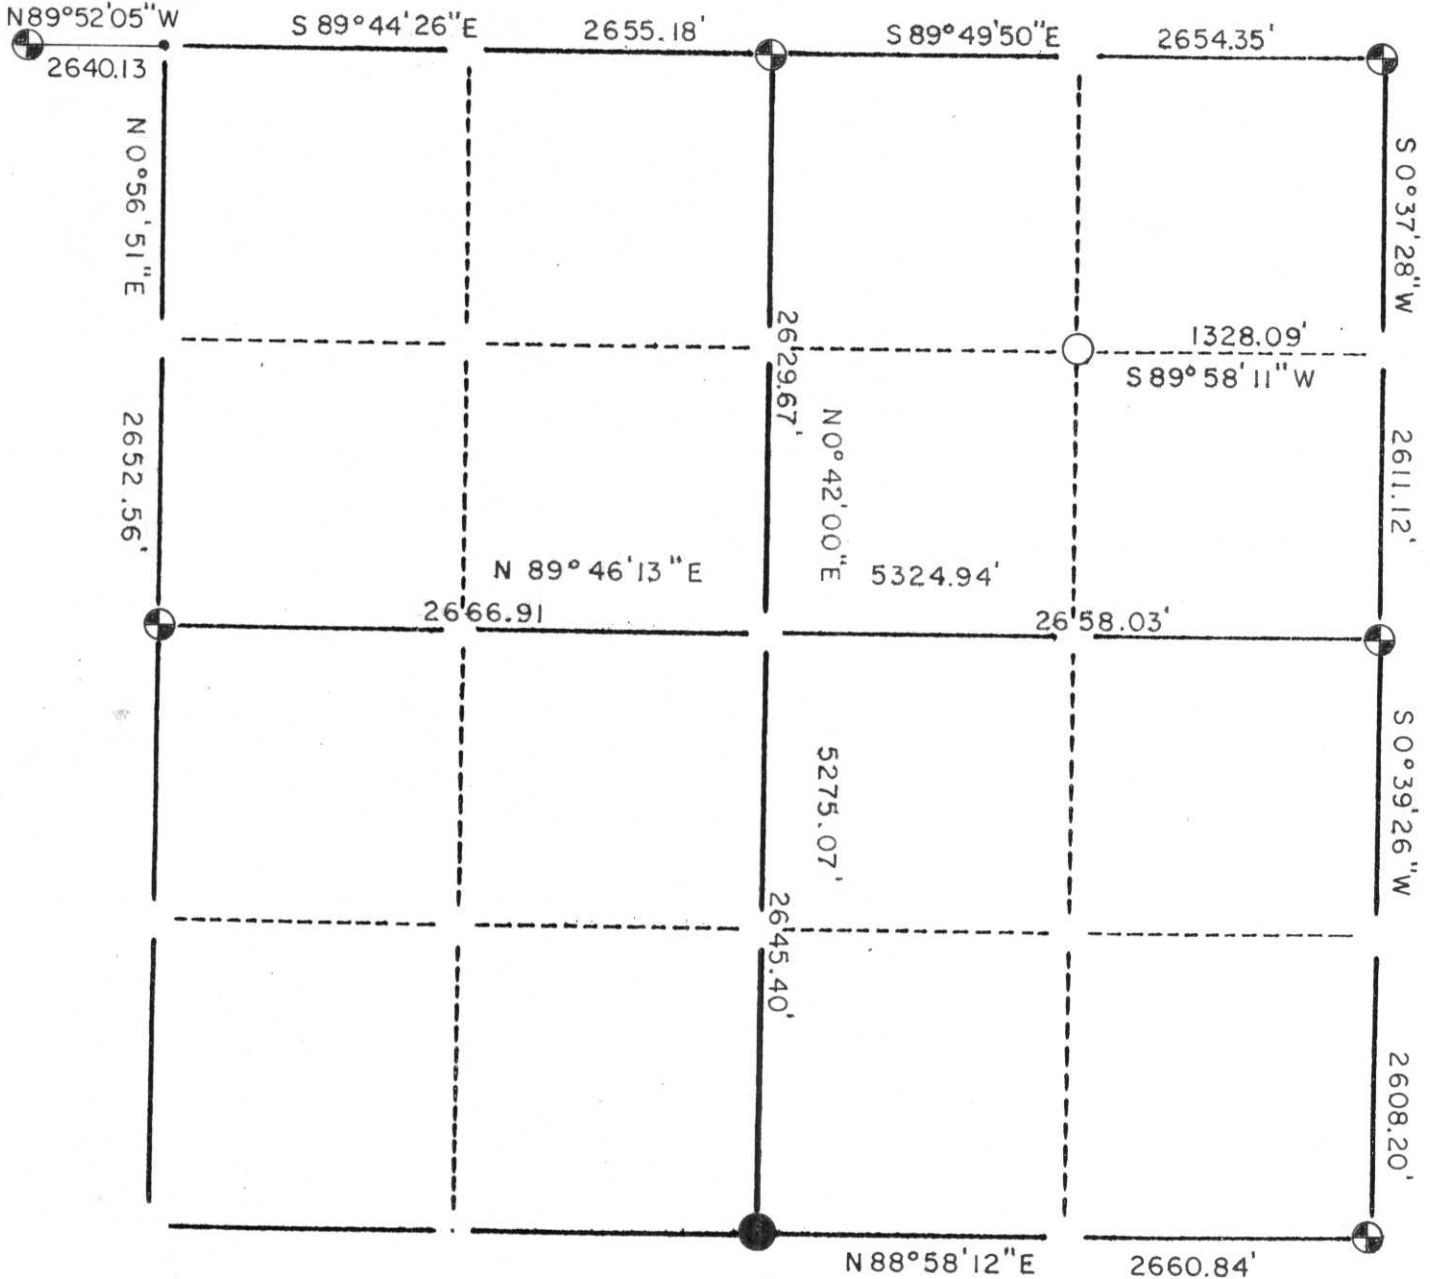

LEGEND

- - Harrison Cast Iron Monument OR BERNTSEN MON.
- - Stone or Concrete Monument
- - 2" Iron Pipe
- - 1" Iron Pipe
- - Iron Bar
- - Other NAIL
- - 4" IRON PIPE

CERTIFIED CORRECT:
Edwin R. Abendroth
 Edwin R. Abendroth RLS No. S-798
 Registered Land Surveyor
 DATE: July 7, 1997

RECEIVED AT LINCOLN COUNTY
 COURTHOUSE THIS 9th DAY
 OF July 1997
Art Krabe
 TAX DESCRIPTION OFFICE




U:R-9:13



SECTION SUMMARY

33	-	32	-	6E
Section		Township		Range
MERRILL				
Town				

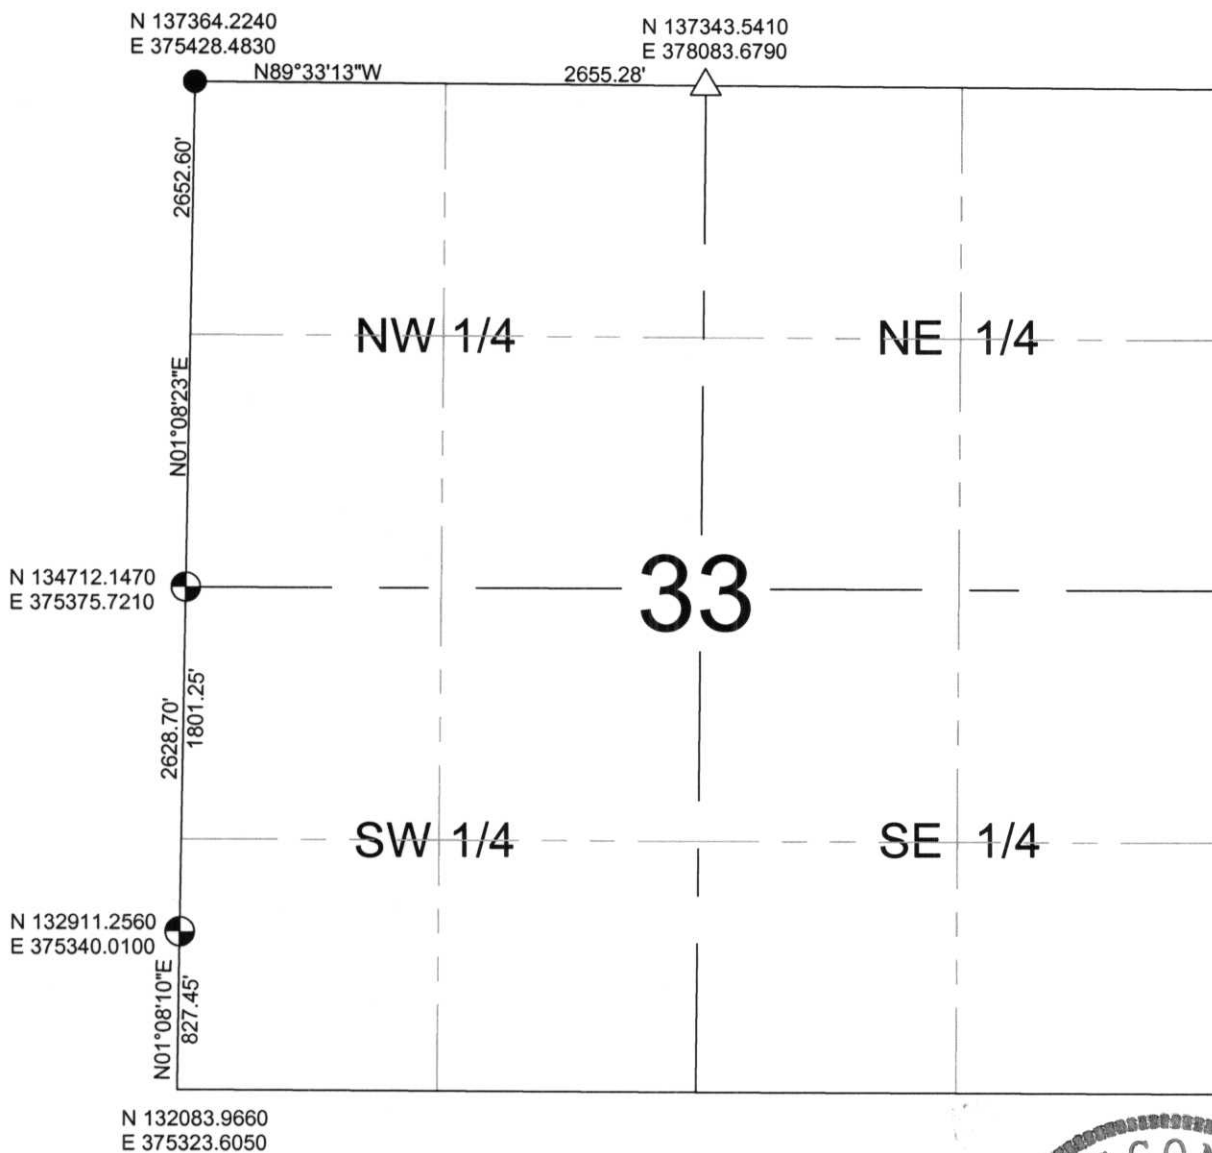


NOTES:
 COORDINATES AND BEARINGS ARE REFERENCED TO THE LINCOLN COUNTY COORDINATE SYSTEM AS DEVELOPED BY THE WISCONSIN DEPARTMENT OF TRANSPORTATION AND WERE DETERMINED BY GPS OBSERVATIONS ON CONTROL POINTS AS SUPPLIED BY THE DOT.

LEGEND

- ⊕ - Lincoln County Monument
- - Stone or Concrete Monument
- - 1" Iron Pipe
- - Harrison
- △ - P.K. Nail

RECEIVED AT LINCOLN COUNTY
 COURTHOUSE THIS 3RD DAY
 OF December 20 02
Tony Dalko
 LAND INFORMATION OFFICE

CERTIFIED CORRECT:
David A. Renaud
 DATE: 11-29-02 Registered Land Surveyor

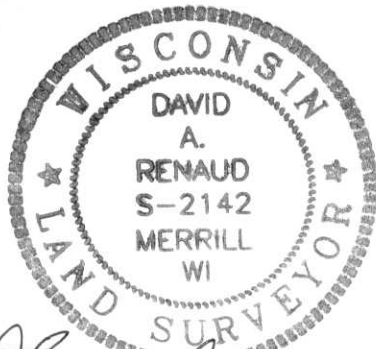

4, 1 - 9, 13