


# DIAGRAM

OF  
Township No. 32 North, Range No. 7  
County, State of Wisconsin

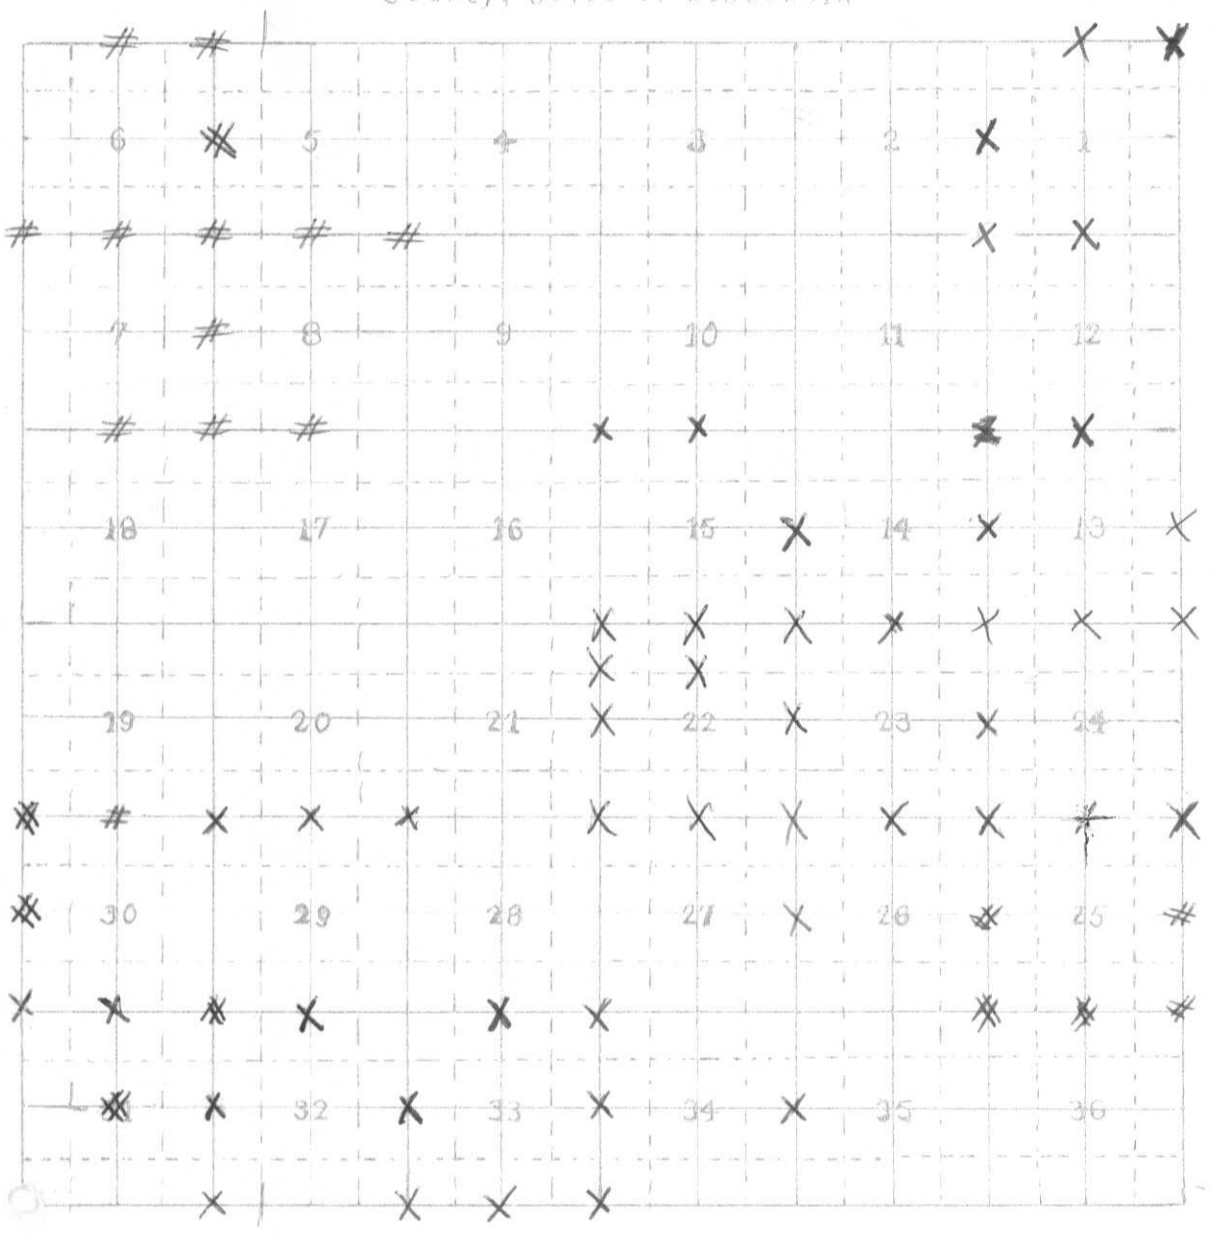

X-CORNER RESET  
 O-CORNER MISSING  
 #-CORNER FOUND