



North  
↑


SECTION SUMMARY

2 - T32N - R7E  
 Section Township Range  
 SCHLEY  
 Town

N 163938.5240  
E 417910.6120

N 163937.1260  
E 420607.9230

N 163934.7450  
E 423246.2890

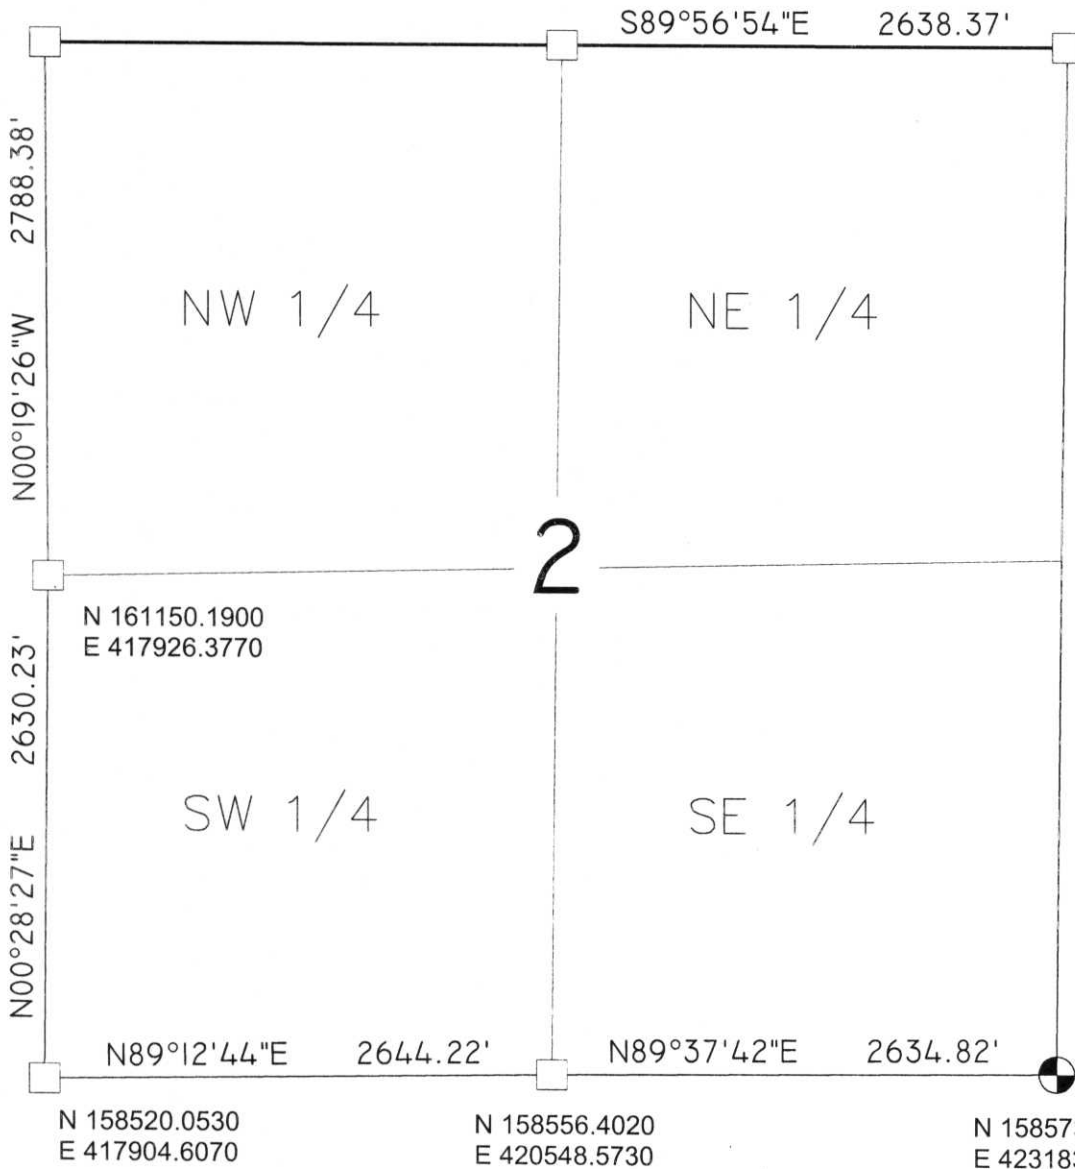

NOTES:

1-COORDINATES & BEARINGS BASED ON LINCOLN COUNTY COORDINATE SYSTEM.

LEGEND

- ⊙ -BERNSTEN MONUMENT
- -GRANITE STONE
- -1 1/2" IRON PIPE
- -2" IRON PIPE
- △ -PK NAIL
- ▲ -RR SPIKE
- -LOCATION FROM TIES
- ⊙ -3/4" REBAR



RECEIVED BY LINCOLN COUNTY  
 SURVEYOR THIS 16<sup>TH</sup> DAY  
 OF September 20 04

*Tommy Dahl*  
 COUNTY SURVEYOR

CERTIFIED CORRECT:

DAVID A. RENAUD

*David Renaud*  
 Registered Land Surveyor

DATE: 9-15-04

A-E 17-21