




**Lincoln
County**

North



SECTION
SUMMARY

10 - 32 - 7E
Section Township Range
MERRILL
Town

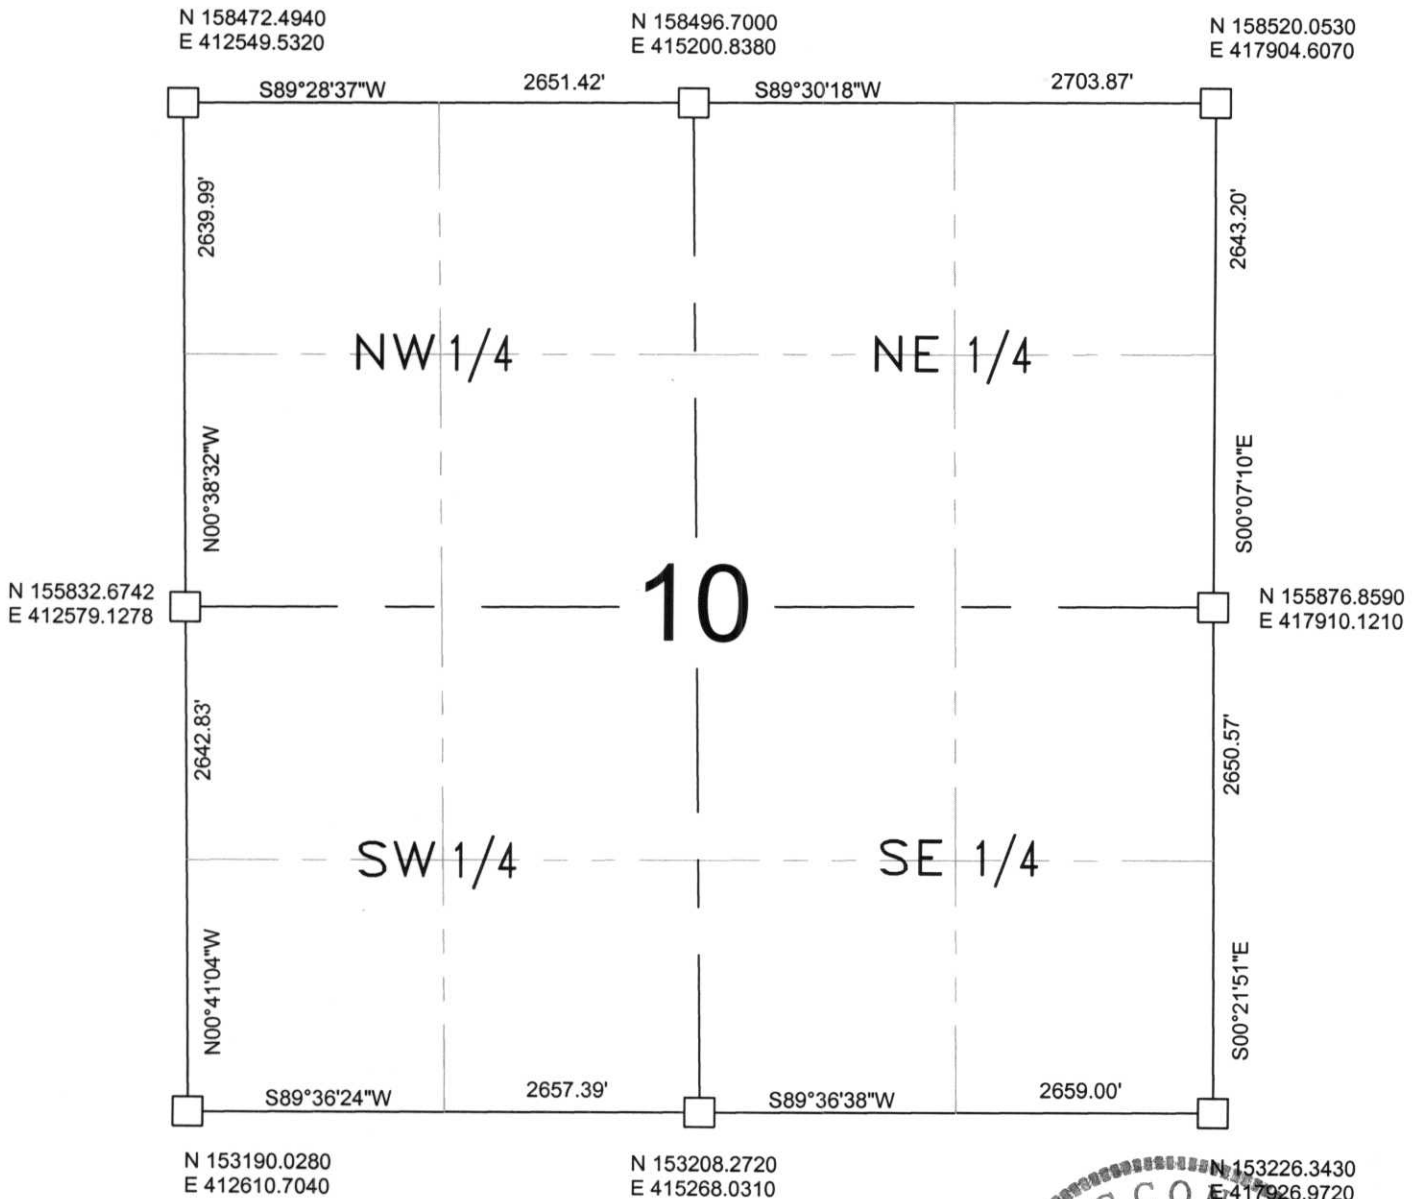

NOTES:
COORDINATES AND BEARINGS ARE REFERENCED TO THE LINCOLN COUNTY COORDINATE SYSTEM AS DEVELOPED BY THE WISCONSIN DEPARTMENT OF TRANSPORTATION AND WERE DETERMINED BY GPS OBSERVATIONS ON CONTROL POINTS AS SUPPLIED BY THE DOT.

LEGEND

- ⊕ - Lincoln County Monument
- - Stone or Concrete Monument
- - 1" Iron Pipe
- - Iron Bar
- △ - P.K. Nail

RECEIVED AT LINCOLN COUNTY
COURTHOUSE THIS 3RD DAY
OF December 20 02
Tom Dabbs
LAND INFORMATION OFFICE



CERTIFIED-CORRECT

DATE: 11-19-02 Registered Land Surveyor

R.E.I. 4080 N. 20th AVE WAUSAU, WI 54401 (715)675-9784

E-I : 13-17